

ELEVATION CERTIFICATE

OMB No. 1660-0008
Expires February 28, 2009

Important: Read the instructions on pages 1-8.

SECTION A - PROPERTY INFORMATION

A1. Building Owner's Name <u>Robert Woods and Mary Gene Woods</u>		For Insurance Company Use:
		Policy Number
A2. Building Street Address (including Apt., Unit, Suite, and/or Bldg. No.) or P.O. Route and Box No. <u>915-17 First Street</u>		Company NAIC Number
City <u>Ocean City</u> State <u>NJ</u> ZIP Code <u>08226</u>		
A3. Property Description (Lot and Block Numbers, Tax Parcel Number, Legal Description, etc.) Lots <u>7</u> Block <u>3</u>		
A4. Building Use (e.g., Residential, Non-Residential, Addition, Accessory, etc.) <u>Residential</u>		
A5. Latitude/Longitude: Lat. <u>39° 16' 57.9"</u> Long. <u>074° 33' 31.0"</u>		Horizontal Datum: <input type="checkbox"/> NAD 1927 <input checked="" type="checkbox"/> NAD 1983
A6. Attach at least 2 photographs of the building if the Certificate is being used to obtain flood insurance.		
A7. Building Diagram Number <u>8</u>		
A8. For a building with a crawl space or enclosure(s), provide		A9. For a building with an attached garage, provide:
a) Square footage of crawl space or enclosure(s) <u>1,500</u> sq ft		a) Square footage of attached garage <u>468</u> sq ft
b) No. of permanent flood openings in the crawl space or enclosure(s) walls within 1.0 foot above adjacent grade <u>9</u>		b) No. of permanent flood openings in the attached garage walls within 1.0 foot above adjacent grade <u>3</u>
c) Total net area of flood openings in A8.b <u>1,800</u> sq in		c) Total net area of flood openings in A9.b <u>600</u> sq in

SECTION B - FLOOD INSURANCE RATE MAP (FIRM) INFORMATION

B1. NFIP Community Name & Community Number <u>Ocean City 345310</u>		B2. County Name <u>Cape May</u>		B3. State <u>NJ</u>	
B4. Map/Panel Number <u>345310 0001</u>	B5. Suffix <u>C</u>	B6. FIRM Index Date <u>07/15/92</u>	B7. FIRM Panel Effective/Revised Date <u>09/05/84</u>	B8. Flood Zone(s) <u>A7</u>	B9. Base Flood Elevation(s) (Zone AO, use base flood depth) <u>10'</u>
B10. Indicate the source of the Base Flood Elevation (BFE) data or base flood depth entered in item B9. <input type="checkbox"/> FIS Profile <input checked="" type="checkbox"/> FIRM <input type="checkbox"/> Community Determined <input type="checkbox"/> Other (Describe) _____					
B11. Indicate elevation datum used for BFE in item B9: <input checked="" type="checkbox"/> NGVD 1929 <input type="checkbox"/> NAVD 1988 <input type="checkbox"/> Other (Describe) _____					
B12. Is the building located in a Coastal Barrier Resources System (CBRS) area or Otherwise Protected Area (OPA)? <input type="checkbox"/> Yes <input checked="" type="checkbox"/> No Designation Date _____ <input type="checkbox"/> CBRS <input type="checkbox"/> OPA					

SECTION C - BUILDING ELEVATION INFORMATION (SURVEY REQUIRED)

C1. Building elevations are based on: Construction Drawings* Building Under Construction* Finished Construction
*A new Elevation Certificate will be required when construction of the building is complete.

C2. Elevations - Zones A1-A30, AE, AH, A (with BFE), VE, V1-V30, V (with BFE), AR, AR/A, AR/AE, AR/A1-A30, AR/AH, AR/AO. Complete items C2.a-g below according to the building diagram specified in item A7.
Benchmark Utilized Ocean City Primary Vertical Datum NGVD 1929
Conversion/Comments _____


Check the measurement used.


a) Top of bottom floor (including basement, crawl space, or enclosure floor)	<u>9.4</u>	<input checked="" type="checkbox"/> feet <input type="checkbox"/> meters (Puerto Rico only)
b) Top of the next higher floor	<u>13.6</u>	<input checked="" type="checkbox"/> feet <input type="checkbox"/> meters (Puerto Rico only)
c) Bottom of the lowest horizontal structural member (V Zones only)	<u>N/A</u>	<input type="checkbox"/> feet <input type="checkbox"/> meters (Puerto Rico only)
d) Attached garage (top of slab)	<u>8.9</u>	<input checked="" type="checkbox"/> feet <input type="checkbox"/> meters (Puerto Rico only)
e) Lowest elevation of machinery or equipment servicing the building (Describe type of equipment in Comments)	<u>10.4</u>	<input checked="" type="checkbox"/> feet <input type="checkbox"/> meters (Puerto Rico only)
f) Lowest adjacent (finished) grade (LAG)	<u>8.7</u>	<input checked="" type="checkbox"/> feet <input type="checkbox"/> meters (Puerto Rico only)
g) Highest adjacent (finished) grade (HAG)	<u>9.1</u>	<input checked="" type="checkbox"/> feet <input type="checkbox"/> meters (Puerto Rico only)

SECTION D - SURVEYOR, ENGINEER, OR ARCHITECT CERTIFICATION

This certification is to be signed and sealed by a land surveyor, engineer, or architect authorized by law to certify elevation information. I certify that the information on this Certificate represents my best efforts to interpret the data available. I understand that any false statement may be punishable by fine or imprisonment under 18 U.S. Code, Section 1001.

Check here if comments are provided on back of form.

Certifier's Name <u>David C. Kruger</u>	License Number <u>NJ Lic. No. 30406</u>
Title <u>Professional Land Surveyor</u>	Company Name <u>David C. Kruger Associates, LLC</u>
Address <u>3323 Simpson Avenue</u>	City <u>Ocean City</u> State <u>NJ</u> ZIP Code <u>08226</u>
Signature 	Date <u>07-22-2008</u> Telephone <u>(609) 391-9393</u>

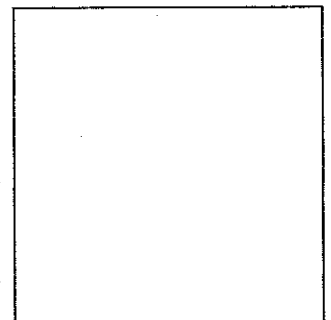


IMPORTANT: In these spaces, copy the corresponding information from Section A.	For Insurance Company Use:
Building Street Address (including Apt., Unit, Suite, and/or Bldg. No.) or P.O. Route and Box No. 915-17 First Street	Policy Number
City Ocean City State NJ ZIP Code 08226	Company NAIC Number

SECTION D - SURVEYOR, ENGINEER, OR ARCHITECT CERTIFICATION (CONTINUED)

Copy both sides of this Elevation Certificate for (1) community official, (2) insurance agent/company, and (3) building owner.

Comments SECTION C2.e) ON REVERSE SIDE REFERS TO BOTTOM OF HOT WATER HEATER
FLOOD VENTS UTILIZED ARE "SMART VENTS", RATED FOR 200 SQ. IN. PER VENT. SEE ATTACHED CERTIFICATION.

Signature  Date 07-22-2008 Check here if attachments

SECTION E - BUILDING ELEVATION INFORMATION (SURVEY NOT REQUIRED) FOR ZONE AO AND ZONE A (WITHOUT BFE)

For Zones AO and A (without BFE), complete Items E1-E5. If the Certificate is intended to support a LOMA or LOMR-F request, complete Sections A, B, and C. For Items E1-E4, use natural grade, if available. Check the measurement used. In Puerto Rico only, enter meters.

- E1. Provide elevation information for the following and check the appropriate boxes to show whether the elevation is above or below the highest adjacent grade (HAG) and the lowest adjacent grade (LAG).
 - a) Top of bottom floor (including basement, crawl space, or enclosure) is _____ feet meters above or below the HAG.
 - b) Top of bottom floor (including basement, crawl space, or enclosure) is _____ feet meters above or below the LAG.
- E2. For Building Diagrams 6-8 with permanent flood openings provided in Section A Items 8 and/or 9 (see page 8 of Instructions), the next higher floor (elevation C2.b in the diagrams) of the building is _____ feet meters above or below the HAG.
- E3. Attached garage (top of slab) is _____ feet meters above or below the HAG.
- E4. Top of platform of machinery and/or equipment servicing the building is _____ feet meters above or below the HAG.
- E5. Zone AO only: If no flood depth number is available, is the top of the bottom floor elevated in accordance with the community's floodplain management ordinance? Yes No Unknown. The local official must certify this information in Section G.

SECTION F - PROPERTY OWNER (OR OWNER'S REPRESENTATIVE) CERTIFICATION

The property owner or owner's authorized representative who completes Sections A, B, and E for Zone A (without a FEMA-issued or community-issued BFE) or Zone AO must sign here. *The statements in Sections A, B, and E are correct to the best of my knowledge.*

Property Owner's or Owner's Authorized Representative's Name _____

Address _____ City _____ State _____ ZIP Code _____

Signature _____ Date _____ Telephone _____

Comments _____

Check here if attachments

SECTION G - COMMUNITY INFORMATION (OPTIONAL)

The local official who is authorized by law or ordinance to administer the community's floodplain management ordinance can complete Sections A, B, C (or E), and G of this Elevation Certificate. Complete the applicable item(s) and sign below. Check the measurement used in Items G8, and G9.

- G1. The information in Section C was taken from other documentation that has been signed and sealed by a licensed surveyor, engineer, or architect who is authorized by law to certify elevation information. (Indicate the source and date of the elevation data in the Comments area below.)
- G2. A community official completed Section E for a building located in Zone A (without a FEMA-issued or community-issued BFE) or Zone AO.
- G3. The following information (Items G4.-G9.) is provided for community floodplain management purposes.

G4. Permit Number 20071637	G5. Date Permit Issued 11/26/07	G6. Date Certificate Of Compliance/Occupancy Issued 8/15/08
-------------------------------	------------------------------------	--

G7. This permit has been issued for: New Construction Substantial Improvement

G8. Elevation of as-built lowest floor (including basement) of the building: _____ feet meters (PR) Datum _____

G9. BFE or (in Zone AO) depth of flooding at the building site: _____ feet meters (PR) Datum _____


Local Official's Name _____ Title _____

Community Name _____ Telephone _____

Signature _____ Date _____

Comments _____

Check here if attachments

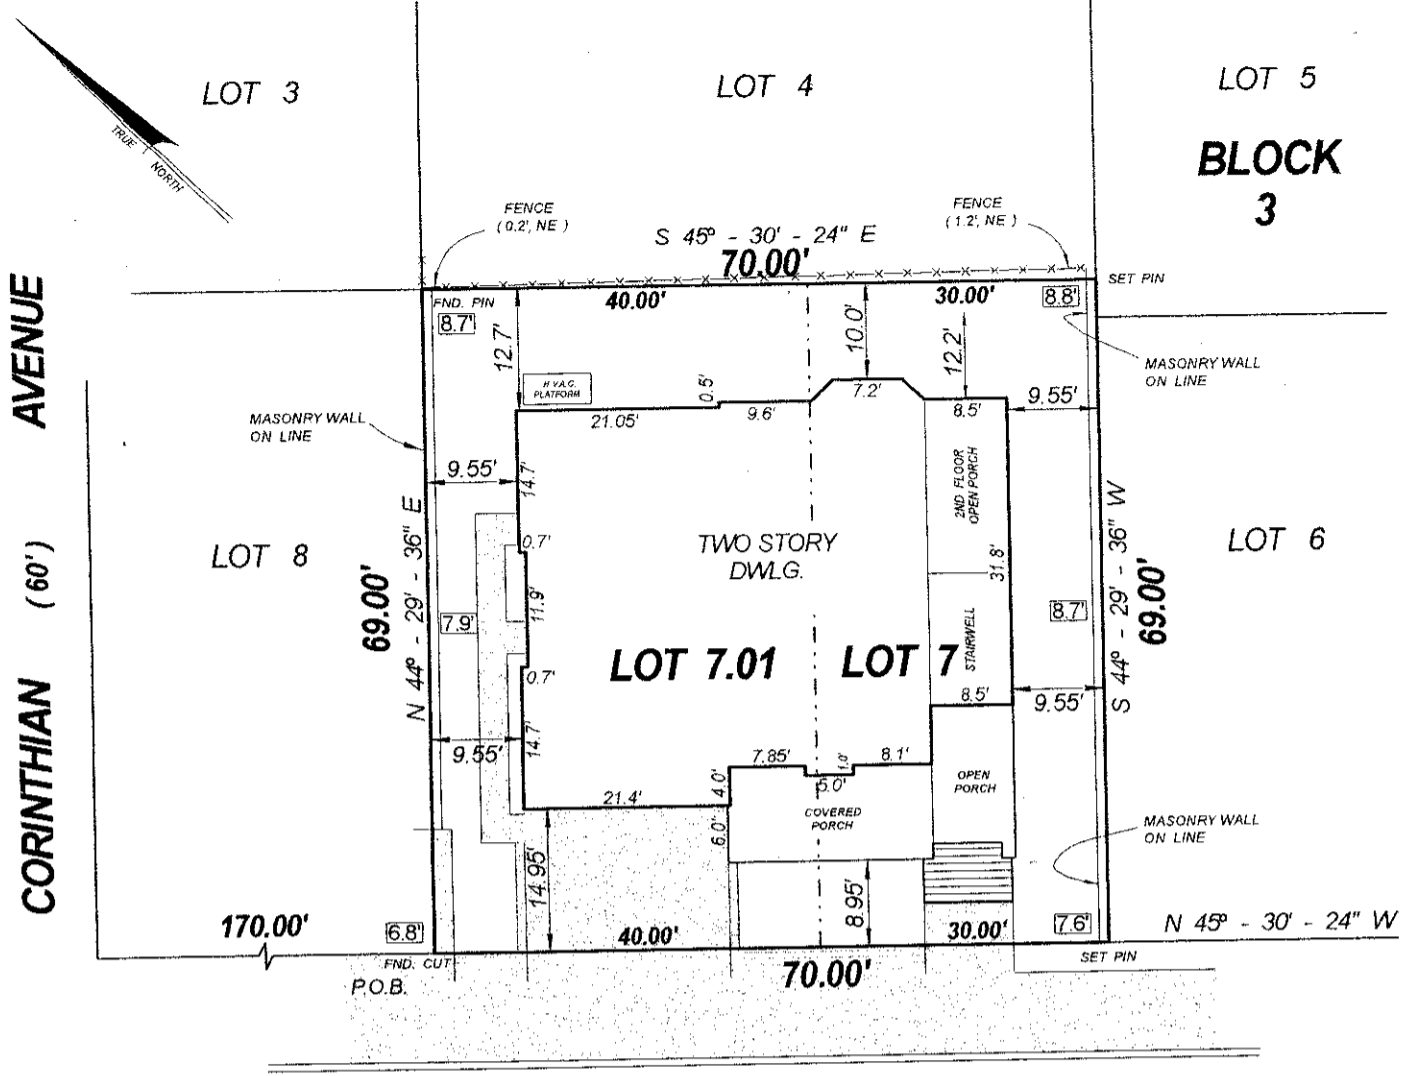

BUILDING ELEVATIONS (NGVD 29) / COVERAGE

ROOF PEAK	= 36.57'
CUPOLA PEAK	= 40.32'
FIRST ELEVATED FLOOR	= 13.57'
BUILDING COVERAGE	= 40.0 %
IMPERVIOUS COVERAGE	= 59.5 %

[6.45] = EXISTING SPOT ELEVATION

Issued to:
 - ROBERT WOODS
 - MARY GENE WOODS

In consideration of the fee paid for making this survey, I declare that this plan is based on a field survey made by me or under my immediate supervision and to the best of my professional knowledge and belief correctly represents the conditions found as of the date of the field survey shown hereon; except such easements and or structures, if any, that may exist below, on, or above the surface of the lands and not visible.

THIS DECLARATION IS GIVEN SOLEY TO THE ABOVE NAMED PARTY FOR THIS TRANSACTION ONLY AND IS NOT TRANSFERABLE.

Surveyor assumes no liability or responsibility for the unauthorized use of this survey for any other purpose, including, but not limited to use of this survey for survey affidavit or resale of property to any party not named herein, either directly or indirectly.

Only signed and sealed copies of this survey shall be considered to be valid. If this survey does not contain a raised seal, it is not an authorized document and may have been altered.

DAVID C. KRUGER
 NJ Professional Land Surveyor License No. 30406
 NJ Professional Planner License No. 3246

PLAN OF SURVEY
LOT 7, 7.01 **BLOCK 3**
 CITY OF OCEAN CITY
 CAPE MAY COUNTY, NJ

DAVID C. KRUGER ASSOCIATES, LLC
 Land Surveying — Planning
 3323 Simpron Avenue Ocean City, New Jersey

NJ CERTIF. OF AUTHORIZATION NO. 24GA28113600

revision	date	date	07 - 31 - 2008	drawn	PT
		scale	1" = 20'	checked	DK
		PROJ. #		7979	