U.S. DEPARTMENT OF HOMELAND SECURITY Federal Emergency Management Agency National Flood Insurance Program

ELEVATION CERTIFICATE

TE Juges 1-8


Important: Read the instructions on pages 1-8

OMB No. 1660-0008 Expires February 28, 2009

xpires F	ebruary 2	8. 2009
0	630	7

		SECTI	ON A - PRO	PERTY INFO	RMA	TION	For Insurance Company Use:
A1. Building Owner's Nam							Policy Number
A2. Building Street Addres 821 FIRST STREET	s (including Apt.,	Unit, Suite, and/or Blo	dg. No.) or P.C). Route and Bo	x No.		Company NAIC Number
City OCEAN CITY	State NJ ZII	Code 08226					
A3. Property Description (I LOT 43 BLOCK	ot and Block Nu 6	mbers, Tax Parcel Nu	mber, Legal D	escription, etc.)			
A4. Building Use (e.g., Res A5. Latitude/Longitude: Lat A6. Attach at least 2 photo A7. Building Diagram Numl A8. For a building with a cr a) Square footage of b) No. of permanent fi enclosure(s) walls c) Total net area of flo	a. N 39° 17′ 04.41 graphs of the buil per 8 awl space or encorawl space or er lood openings in within 1.0 foot ab	" Long. W 74* 33' 39 Iding if the Certificate closure(s), provide nclosure(s) the crawl space or ove adjacent grade	.46"	A9. For a)	nsura r a bu Squa No. o walls	nce. illding with an attac are footage of attac of permanent flood	openings in the attached garage ove adjacent grade
	SECT	ION B - FLOOD IN	SURANCE I				
B1. NFIP Community Name OCEAN CITY 345310	& Community N		2. County Nam APE MAY	ne			B3. State NEW JERSEY
B4. Map/Panel Number 345310-0001	B5. Suffix	B6. FIRM Index Date 7-15-92	Effective	FIRM Panel P/Revised Date 9-5-84		B8. Flood Zone(s) A-7	B9. Base Flood Elevation(s) (Zone AO, use base flood depth) 9 FT
B10. Indicate the source of t FIS Profile B11. Indicate elevation datur B12. Is the building located i Designation Date	☑ FIRM m used for BFE i n a Coastal Barri —	☐ Community Determ I Item B9: NG er Resources System	nined [VD 1929 [(CBRS) area □ CBRS	Other (Descr NAVD 1988 or Otherwise P	ribe) _ C rotecte	Other (Describe)	□Yes ⊠No
	SECTIO	N C - BUILDING EL	EVATION IN	FORMATION	V (SU	JRVEY REQUIR	ED)
C1. Building elevations are based *A new Elevation Certification C2. Elevations – Zones A1-Abelow according to the based Benchmark Utilized PRI Conversion/Comments	ate will be requir 30, AE, AH, A (v uilding diagram s /T Vertical Datu	vith BFE), VE, V1-V30 specified in Item A7.	of the building	☐ Building Un is complete. , AR, AR/A, AR	/AE, <i>F</i>		
d) Attached garage (to	er floor t horizontal struc p of slab) machinery or eq quipment in Com iished) grade (LA	tural member (V Zone uipment servicing the ments) tG)	es only)	11.5 X NA. X 10.8 X 8.4 X	feet feet feet feet feet feet feet	meters (Puerto meters	o Rico only)
	SECTIO	N D - SURVEYOR,	ENGINEER	OR ARCHIT	ECT	CERTIFICATIO	N
This certification is to be sig information. I certify that the I understand that any false s Check here if comments Certifier's Name JAMES E. SCHWAB III	ned and sealed be information on t statement may be	y a land surveyor, en his Certificate represe punishable by fine or	gineer, or arch ents my best ei r imprisonment	itect authorized	by la t the o Code	w to certify elevation data available. e, Section 1001.	
Title LAND SURVEYOR Address			_				
Address 8 EAST 10 TH STREET Signature	_	City OCEAN CI	Telephone	State NJ ZI e 609-398-056		de 08226	
\longrightarrow		6/1408	J				

duilding Street Address (including Apt., Unit, Suite, and/or Bldg. No.)	nformation from Section A.	For Insurance Company Use:
821 FIRST STREET	or P.O. Route and Box No.	Policy Number
City OCEAN CITY State NJ ZIP Code 08226	Company NAIC Number	
SECTION D - SURVEYOR, ENGINE	ER, OR ARCHITECT CERTIFICA	TION (CONTINUED)
Copy both sides of this Elevation Certificate for (1) community official	I, (2) insurance agent/company, and (3) building owner.
Comments C2A IS CRAWL SPACE, C2B IS FIRST FLOOR, C2E IS FALL VENTS ARE "USA FOUNDATION FLOOD AIR VENTS" FLOO THEIR "CERTIFIED CODE COMPLIANT FLOOD MODELS COVER COPIES OF THESE CERTIFICATIONS AND THE SURVEYOR DOES GIGNATURE SECTION E - BUILDING ELEVATION INFORMATION (S	D AIR MODELS MEASURING 8 X 16 250 SQUARE FEET". THE MANUFACES NOT GUARANTEE THE SUITIBILITY Date	IN. AND ACCORDING TO THE MANUFACTURE CTURER HAS NOT SUPPLIED REQUESTED TY OF THESE VENTS.
For Zones AO and A (without BFE), complete Items E1-E5. If the Ce and C. For Items E1-E4, use natural grade, if available. Check the research C. For Items E1-E4, use natural grade, if available. Check the research C. For Items E1-E4, use natural grade, if available. Check the research C. For Items E1-E4, use natural grade, if available. Check the research C. For Building Items Items E2. For Building Diagrams 6-8 with permanent flood openings proved (elevation C2.b in the diagrams) of the building is	propriate boxes to show whether the closure) is feet meters above or feet meters above or feet feet feet feet feet feet feet fee	ly, enter meters. elevation is above or below the highest adjacent meters above or below the HAG. meters above or below the LAG. e page 8 of Instructions), the next higher floor below the HAG. AG. eters above or below the HAG.
SECTION F - PROPERTY OWNER (The property owner or owner's authorized representative who comple		
or Zone AO must sign here. The statements in Sections A, B, and E Property Owner's or Owner's Authorized Representative's Name	are correct to the best of my knowledg	e. State ZIP Code
Signature	Date	Telephone
Comments		, or ophorio
SECTION G - COMM	MUNITY INFORMATION (OPTION	Check here if attachme
ne local official who is authorized by law or ordinance to administer the	e community's floodolain management	Ordinance can complete Sections A. B. C. (a. F.)
. The information in Section C was taken from other document	d sign below. Check the measuremen tation that has been signed and sealed	used in Items G8. and G9.
The information in Section C was taken from other document is authorized by law to certify elevation information. (Indicate A community official completed Section E for a building located)	d sign below. Check the measuremen tation that has been signed and sealed the source and date of the elevation of the in Zone A (without a FEMA-issued	used in Items G8. and G9. by a licensed surveyor, engineer, or architect wh lata in the Comments area below.) or community-issued BFE) or Zone AO.
The information in Section C was taken from other document is authorized by law to certify elevation information. (Indicate A community official completed Section E for a building locate The following information (Items G4G9.) is provided for community of the following information (Items G4G9.)	d sign below. Check the measurement ation that has been signed and sealed the source and date of the elevation of the development of the composition of the elevation of the source and date of the elevation of the source and date of the elevation of the source and the source and the source of the	used in Items G8. and G9. by a licensed surveyor, engineer, or architect wh lata in the Comments area below.) or community-issued BFE) or Zone AO. ses.
The information in Section C was taken from other document is authorized by law to certify elevation information. (Indicate A community official completed Section E for a building locate The following information (Items G4G9.) is provided for community official Completed Section E for a building locate The following information (Items G4G9.) is provided for community Official Complete G5. Date Permit Issued C5.	d sign below. Check the measurement ation that has been signed and sealed the source and date of the elevation of the development of the composition of the elevation of the source and date of the elevation of the source and date of the elevation of the source and the source and the source of the	by a licensed surveyor, engineer, or architect who lata in the Comments area below.) or community-issued BFE) or Zone AO. ses. ate Of Compliance/Occupancy Issued
The information in Section C was taken from other document is authorized by law to certify elevation information. (Indicate A community official completed Section E for a building locate The following information (Items G4G9.) is provided for community official completed Section E for a building locate The following information (Items G4G9.) is provided for community official completed Section E for a building locate The following information (Items G4G9.) is provided for community official complete the applicable item(s) and the information in Section C was taken from other document is authorized by law to certify elevation information. (Indicate A community official completed Section E for a building locate The following information (Items G4G9.) is provided for community of the following information (Items G4G9.) is provided for community of the following information (Items G4G9.) is provided for community of the following information (Items G4G9.) is provided for community of the following information (Items G4G9.) is provided for community of the following information (Items G4G9.) is provided for community of the following information (Items G4G9.) is provided for community of the following information (Items G4G9.) is provided for community of the following information (Items G4G9.) is provided for community of the following information (Items G4G9.) is provided for community of the following information (Items G4G9.) is provided for community of the following information (Items G4G9.) is provided for community of the following information (Items G4G9.) is provided for community of the following information (Items G4G9.) is provided for community of the following information (Items G4G9.) is provided for community of the following information (Items G4G9.) is provided for community of the following information (Items G4G9.) is provided for community of the following information (Items G4G9.) is provided for community of the following information (Items G4G9.) i	a sign below. Check the measurement ation that has been signed and sealed the source and date of the elevation of the developed in Zone A (without a FEMA-issued annunity floodplain management purposed) G6. Date Certification of the control of th	by a licensed surveyor, engineer, or architect who a licensed surveyor, engineer, or architect who lata in the Comments area below.) or community-issued BFE) or Zone AO. ses. ate Of Compliance/Occupancy Issued
The information in Section C was taken from other document is authorized by law to certify elevation information. (Indicate A community official completed Section E for a building locate. The following information (Items G4G9.) is provided for completed Section E for a building locate The following information (Items G4G9.) is provided for completed Section E for a building locate The following information (Items G4G9.) is provided for complete The following information (Items G4G9.) is provided for complete The following information (Items G4G9.) is provided for complete The following information (Items G4G9.) is provided for complete The following information (Items G4G9.) is provided for complete The following information (Items G4G9.) is provided for complete The following information (Items G4G9.) is provided for complete The following information (Items G4G9.) is provided for complete The following information (Items G4G9.) is provided for complete The following information (Items G4G9.) is provided for complete The following information (Items G4G9.) is provided for complete The following information (Items G4G9.) is provided for complete The following Items G4G9.) is provided for complete The following Items G4G9.	a sign below. Check the measurement ation that has been signed and sealed the source and date of the elevation of of the ele	tused in Items G8. and G9. by a licensed surveyor, engineer, or architect whelata in the Comments area below.) or community-issued BFE) or Zone AO. ses. ate Of Compliance/Occupancy Issued
The information in Section C was taken from other document is authorized by law to certify elevation information. (Indicate A community official completed Section E for a building locate. The following information (Items G4G9.) is provided for community of the following information (Items G4G9.) is provided for community of the section E for a building information (Items G4G9.) is provided for community of the section in the following information (Items G4G9.) is provided for community of the section in the section of the section in the section of the section of the section in the section information (Indicate G4G9.) is provided for community of the section information (Items G4G9.) is provided for community of the section information (Indicate G4G9.) is provided for community of the section information (Indicate G4G9.) is provided for community of the section information (Indicate G4G9.) is provided for community of the section information (Indicate G4G9.) is provided for community of the section information (Indicate G4G9.) is provided for community of the section information (Indicate G4G9.) is provided for community of the section information (Indicate G4G9.) is provided for community of the section information (Indicate G4G9.) is provided for community of the section information (Indicate the elevatio	tused in Items G8. and G9. by a licensed surveyor, engineer, or architect whelata in the Comments area below.) or community-issued BFE) or Zone AO. ses. ate Of Compliance/Occupancy Issued
The information in Section C was taken from other document is authorized by law to certify elevation information. (Indicate A community official completed Section E for a building locate The following information (Items G4G9.) is provided for community Number G5. Date Permit Issued This permit has been issued for: This permit has been issued for: Elevation of as-built lowest floor (including basement) of the building beautiful at the building site:	a sign below. Check the measurement attion that has been signed and sealed the source and date of the elevation of the source and date of the elevation of the discource and date of the elevation of the source and date of the elevation o	tused in Items G8. and G9. by a licensed surveyor, engineer, or architect whelata in the Comments area below.) or community-issued BFE) or Zone AO. ses. ate Of Compliance/Occupancy Issued
The information in Section C was taken from other document is authorized by law to certify elevation information. (Indicate A community official completed Section E for a building located The following information (Items G4G9.) is provided for community Name G5. Date Permit Issued G6. Date Permit Issued G7. This permit has been issued for: G8. Description New Construction G9. BFE or (in Zone AO) depth of flooding at the building site: Community Name	a sign below. Check the measurement attion that has been signed and sealed the source and date of the elevation of the source and date of the elevation of the discource and date of the elevation of the source and date of the elevation of the elevation of the source and date of the elevation of the eleva	tused in Items G8. and G9. by a licensed surveyor, engineer, or architect whelata in the Comments area below.) or community-issued BFE) or Zone AO. ses. ate Of Compliance/Occupancy Issued
The information in Section C was taken from other document is authorized by law to certify elevation information. (Indicate A community official completed Section E for a building located The following information (Items G4G9.) is provided for community Name G5. Date Permit Issued G6. Date Permit Issued G7. This permit has been issued for: [Including basement) of the building BFE or (in Zone AO) depth of flooding at the building site: [Including basement] [Including basem	a sign below. Check the measurement attion that has been signed and sealed the source and date of the elevation of the source and date of the elevation of the discource and date of the elevation of the source and date of the elevation o	tused in Items G8. and G9. by a licensed surveyor, engineer, or architect whelata in the Comments area below.) or community-issued BFE) or Zone AO. ses. ate Of Compliance/Occupancy Issued
The information in Section C was taken from other document is authorized by law to certify elevation information. (Indicate A community official completed Section E for a building located The following information (Items G4G9.) is provided for community Name G5. Date Permit Issued G6. Date Permit Issued G7. This permit has been issued for: G8. Description New Construction G9. BFE or (in Zone AO) depth of flooding at the building site: Local Official's Name	a sign below. Check the measurement attion that has been signed and sealed the source and date of the elevation of the source and date of the elevation of the discource and date of the elevation of the source and date of the elevation of the elevation of the source and date of the elevation of the eleva	tused in Items G8. and G9. by a licensed surveyor, engineer, or architect whelata in the Comments area below.) or community-issued BFE) or Zone AO. ses. ate Of Compliance/Occupancy Issued
The information in Section C was taken from other document is authorized by law to certify elevation information. (Indicate A community official completed Section E for a building locate The following information (Items G4G9.) is provided for community Name G5. Date Permit Issued G6. Date Permit Issued G7. This permit has been issued for: G8. Description New Construction Relevation of as-built lowest floor (including basement) of the building by BFE or (in Zone AO) depth of flooding at the building site: Community Name	a sign below. Check the measurement attion that has been signed and sealed the source and date of the elevation of the source and date of the elevation of the discource and date of the elevation of the source and date of the elevation of the elevation of the source and date of the elevation of the eleva	tused in Items G8. and G9. by a licensed surveyor, engineer, or architect whelata in the Comments area below.) or community-issued BFE) or Zone AO. ses. ate Of Compliance/Occupancy Issued

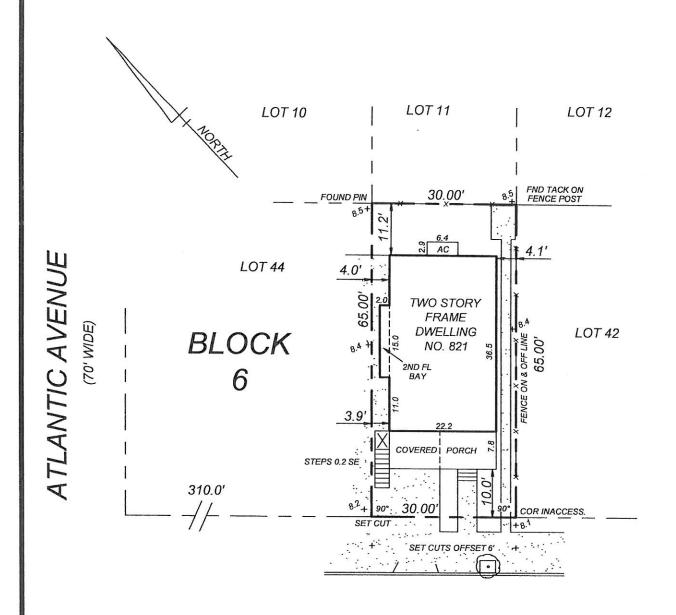

FIRST STREET

(60' WIDE)

+ X.X = EXISTING NGVD 1929 ELEVATION COVERAGE AND HEIGHT

LOT AREA- 1,950 SQ.FT.

BUILDING AREA- , 810 SQ.FT., 41.5 %

PEAK ELEVATION- 35.9 FT.

CENTERLINE ELEVATION- 7.99 FT.

BUILDING HEIGHT- 27.9 FT.

IMPERVIOUS AREA- 1,497 SQ.FT., 76.8%

THIS SURVEY IS FOR USE IN APPLYING FOR MUNICIPAL APPROVAL OF NEW CONSTRUCTION. THE SURVEYOR WILL ACCEPT NO RESPONSIBILITY FOR ITS USE FOR ANY OTHER PURPOSE.



PROFESSIONAL LAND SURVEYOR
NEW JERSEY LIC. 24GS03353600
PROFESSIONAL PLANNER
NEW JERSEY LIC. 31LI00408600

ISSUED TO:
MESSINA CONSTRUCTION

FINAL CONSTRUCTION SURVEY

LOT 43 BLOCK 6 CITY OF OCEAN CITY CAPE MAY COUNTY, NJ

DATE : JUNE 10, 2008 SCALE : 1" = 20'

DWN.BY : JES

SCHWAB LAND SURVEYING AND PLANNING, LLC

8 EAST 10TH STREET OCEAN CITY, NJ 08226

TELE 609-398-0565

FAX 398-1861

CERTIFICATE OF AUTHORIZATION NO. 24GA28101600

FILE : 06-307

FIELD BOOK : ~~~~