

FEDERAL EMERGENCY MANAGEMENT AGENCY
NATIONAL FLOOD INSURANCE PROGRAM
ELEVATION CERTIFICATE

O.M.B. No. 3067-0077
Expires July 31, 2002

Important: Read the Instructions on pages 1 - 7.

SECTION A - PROPERTY OWNER INFORMATION

BUILDING OWNER'S NAME	For Insurance Company Use:
BUILDING STREET ADDRESS (Including Apt, Unit, Suite, and/or Bldg. No.) OR P.O. ROUTE AND BOX NO.	Policy Number
CITY	Company NAIC Number
STATE	ZIP CODE
PROPERTY DESCRIPTION (Lot and Block Numbers, Tax Parcel Number, Legal Description, etc.)	
BUILDING USE (e.g., Residential, Non-Residential, Addition, Accessory, etc. Use a Comments area, if necessary.)	
LATITUDE/LONGITUDE (OPTIONAL) (##°-##'-##" or ##°-##'-##")	
HORIZONTAL DATUM: ☐ NAD 1927 ☐ NAD 1983	SOURCE: ☐ GPS (Type): ☐ USGS Quad Map ☐ Other:

SECTION B - FLOOD INSURANCE RATE MAP (FIRM) INFORMATION

B1. FIRM COMMUNITY NAME & COMMUNITY NUMBER	B2. COUNTY NAME	B3. STATE
Ocean City 375310	CAPE MAY	N.J.
B4. MAP AND PANEL NUMBER	B5. SUFFIX	B6. FIRM INDEX DATE
345310 001	C	7.15.92
B7. FIRM PANEL EFFECTIVE/REVISED DATE	B8. FLOOD ZONE(S)	B9. BASE FLOOD ELEVATION(S) (Zone AO, use depth of flooding)
9/5/84	A7	NINE
B10. Indicate the source of the Base Flood Elevation (BFE) data or base flood depth entered in B9. ☐ FIS Profile ☒ FIRM ☐ Community Determined ☐ Other (Describe):		
B11. Indicate the elevation datum used for the BFE in B9: ☒ NGVD 1929 ☐ NAVD 1988 ☐ Other (Describe):		
B12. Is the building located in a Coastal Barrier Resources System (CBRS) area or Otherwise Protected Area (OPA)? ☐ Yes ☒ No Designation Date:		

SECTION C - BUILDING ELEVATION INFORMATION (SURVEY REQUIRED)

C1. Building elevations are based on: ☐ Construction Drawings ☐ Building Under Construction ☒ Finished Construction
*A new Elevation Certificate will be required when construction of the building is complete.

C2. Building Diagram Number 6 (Select the building diagram most similar to the building for which this certificate is being completed - see pages 6 and 7. If no diagram accurately represents the building, provide a sketch or photograph.)

C3. Elevations - Zones A1-A30, AE, AH, A (with BFE), VE, V1-V30, V (with BFE), AR, AR/A, AR/AE, AR/A1-A30, AR/AH, AR/AO
Complete items C3.a-f below according to the building diagram specified in item C2. State the datum used. If the datum is different from the datum used for the BFE in Section B, convert the datum to that used for the BFE. Show field measurements and datum conversion calculation. Use the space provided or the Comments area of Section D or Section G, as appropriate, to document the datum conversion.

Datum NGVD '29 Conversion/Comments NONE

Elevation reference mark used RM Does the elevation reference mark used appear on the FIRM? ☒ Yes ☐ No

☐ a) Top of bottom floor (including basement or enclosure)	<u>9.53</u> (ft)
☐ b) Top of next higher floor	<u>18.54</u> (ft)
☐ c) Bottom of lowest horizontal structural member (V zones only)	<u>NA</u> ft
☐ d) Attached garage (top of slab)	<u>9.53</u> (ft)
☐ e) Lowest elevation of machinery and/or equipment	<u>11.20</u> (ft)
☐ f) Lowest adjacent (finished) grade (LAG)	<u>9.4</u> (ft)
☐ g) Highest adjacent (finished) grade (HAG)	<u>9.5</u> (ft)
☐ h) No. of permanent openings (flood vents) within 1 ft. above adjacent grade	<u>14</u>
☐ i) Total area of all permanent openings (flood vents) in C3.h	<u>14</u> sq. ft. (sq. cm)

or 'clg the building (Describe in a Comments area.)

SECTION D - SURVEYOR, ENGINEER, OR ARCHITECT CERTIFICATION

This certification is to be signed and sealed by a land surveyor, engineer, or architect authorized by law to certify elevation information.
I certify that the information in Sections A, B, and C on this certificate represents my best efforts to interpret the data available.
I understand that any false statement may be punishable by fine or imprisonment under 18 U.S. Code, Section 1001.

CERTIFIER'S NAME	TITLE	ADDRESS	CITY	STATE	ZIP CODE
Thomas P. KARR	PROP. LAND SURVEYOR	PO BOX 89	DEERFIELD	NJ	08230
KARR LAND SURVEYING	DATE	TELEPHONE			
	1/31/03	609 390 7936			

SEE REVERSE SIDE FOR CONTINUATION

REPLACES ALL PREVIOUS EDITIONS

On the 12-31-2003, copy the corresponding information from Section A.

BUILDING STREET ADDRESS (including Apt., Unit, Suite, and/or Bldg. No.) OR P.O. ROUTE AND BOX NO.	For Insurance Company Use:
63 CENTRAL ROAD	Policy Number:
CITY: OCEAN CITY NJ STATE: 08226 ZIP CODE:	Company NAIC Number:

SECTION D - SURVEYOR, ENGINEER, OR ARCHITECT CERTIFICATION (CONTINUED)

Copy both this and the Elevation Certificate for (1) community official, (2) insurance agent/company, and (3) building owner.

Comments: 2003 FEB 10 House heater is 11.20

SECTION E - BUILDING ELEVATION INFORMATION (SURVEY NOT REQUIRED) FOR ZONE AO AND ZONE A (WITHOUT BFE)

For Zone AO and Zone A (without BFE), complete items E1. through E4. If the Elevation Certificate is intended for use as supporting information for a LOMA or LOMR-F, Section C must be completed.

E1. Building Diagram Number: (Select the building diagram most similar to the building for which this certificate is being completed - see pages 6 and 7. If no diagram accurately represents the building, provide a sketch or photograph.)

E2. The top of the bottom floor (including basement or encasement) of the building is: (m) (ft) above or below (check one) the highest adjacent grade. (Use natural grade, if available.)

E3. For Building Diagrams 6-8 with openings (see page 7), the next higher floor or elevated floor (elevation b) of the building is: (m) (ft) above the highest adjacent grade. Complete items C3.1 and C3.1 on front of form.

E4. For Zone A only: If no flood depth number is available, is the top of the bottom floor elevated in accordance with the community's floodplain management ordinance? Yes No Unknown. The local official must certify this information in Section G.

SECTION F - PROPERTY OWNER (OR OWNER'S REPRESENTATIVE) CERTIFICATION

The property owner or owner's authorized representative who completes Sections A, B, C (Items C3.1 and C3.1 only), and E for Zone A (without a FEMA-issued or community-issued BFE) or Zone AO must sign here. The statements in Sections A, B, C, and E are correct to the best of my knowledge.

PROPERTY OWNER'S OR OWNER'S AUTHORIZED REPRESENTATIVE'S NAME: _____

ADDRESS: _____ CITY: _____ STATE: _____ ZIP CODE: _____

SIGNATURE: _____ DATE: _____ TELEPHONE: _____

Comments: _____

SECTION G - COMMUNITY INFORMATION (OPTIONAL)

The local official who is authorized by law or ordinance to administer the community's floodplain management ordinance can complete Sections A, B, C (or E), and G of this Elevation Certificate. Complete the applicable item(s) and sign below.

31. The information in Section C was taken from other documentation that has been signed and embossed by a licensed surveyor, engineer, or architect who is authorized by state or local law to certify elevation information. (Indicate the source and date of the elevation data in the Comments area below.)

32. A community official completed Section E for a building located in Zone A (without a FEMA-issued or community-issued BFE) or Zone AO.

33. The following information (Items G4-G9) is provided for community floodplain management purposes.

CA. PERMIT NUMBER: 2-1513+02-1514	CB. DATE PERMIT ISSUED: 8/2/02	CC. DATE CERTIFICATE OF COMPLIANCE/OCCUPANCY ISSUED: 6/1/03
-----------------------------------	--------------------------------	---

37. This permit has been issued for: New Construction Substantial Improvement

38. Elevation of the built-up floor (including basement) of the building is: (m) Datum: _____

39. BFE or (in Zone AO) depth of flooding at the building site is: (m) Datum: _____

LOCAL OFFICIAL'S NAME: _____ TITLE: _____

COMMUNITY NAME: _____ TELEPHONE: _____

SIGNATURE: _____ DATE: _____

Comments: _____

FINAL ASBUILT

TOTAL LOT AREA: 3717 SF

LIMIT OF FOUNDATION 34.9 %
BLDG PORCHES AND CONC 63.5 %


ROOF PEAK ELEV 43.4

CENTERLINE OF CENTRAL RD. 8.30

DIFF. 34.1 Feet

BUILDING TIES TO PROPERTY LINE
ARE TO BE USED FOR CHECKING
COMPLIANCE WITH ZONING REGULATIONS
AND NOT TO BE USED FOR
ANY OTHER PURPOSE

THIS SURVEY IS MADE SUBJECT TO ANY RIGHTS, RESTRICTIONS,
EASEMENTS, RIGHT OF WAY, EXCEPTIONS, OR COVENANTS THAT AN
ACCURATE AND CURRENT TITLE REPORT MAY DISCLOSE.

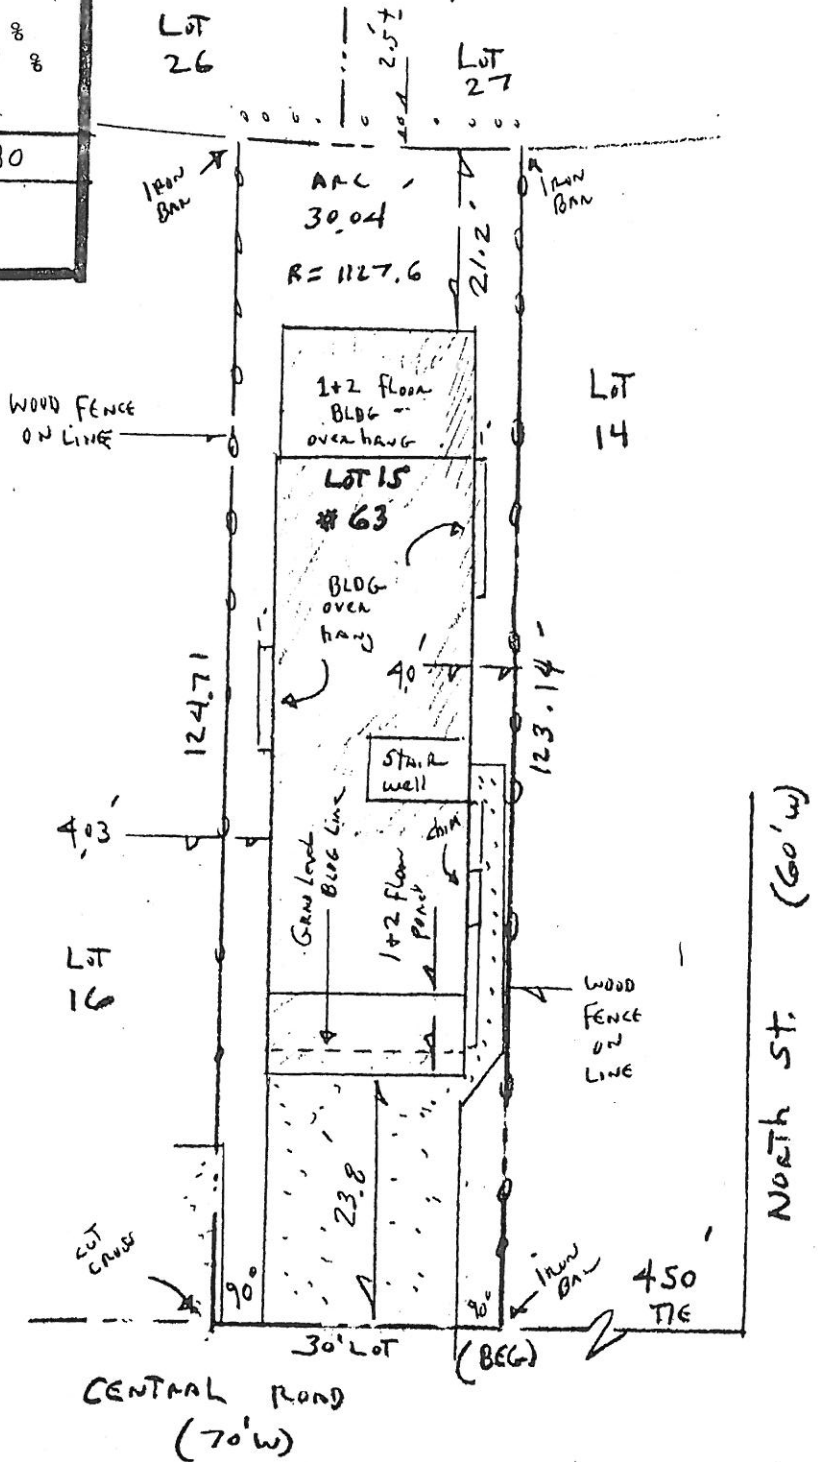

KARR LAND SURVEYING mailing address: P.O. BOX 89 OCEANVIEW, N.J. 08230 PHONE 609 390 7936 FAX 390 7937 THOMAS P. KARR NJ PROFESSIONAL LAND SURVEYOR NJ SURVEYORS LICENSE # 31269 location: route 9 MARION NJ		PLAN OF SURVEY BLOCK(s) <u>70.04</u> LOT(s) <u>15</u> <u>OCEAN CITY</u> COUNTY OF <u>CAPE MAY</u> NEW JERSEY TYPE THREE SURVEY THIS IS NOT AN ALTA STANDARD SURVEY REVISIONS _____ Date _____ DATE OF PLAN <u>1/31/03</u> DRAWN BY <u>TK</u> SCALE <u>1" = 20'</u> PROJECT NO. <u>02122</u>	
---	--	--	--