

ELEVATION CERTIFICATE

7.13.11

OMB No. 1660-0008
Expires March 31, 2012

Important: Read the instructions on pages 1-9.

HDG # 5376	Bk/Pg 1055/62	SECTION A - PROPERTY INFORMATION	For Insurance Company Use:
A1. Building Owner's Name Robert P. DiMarco & Mary Ann DiMarco			Policy Number
A2. Building Street Address (including Apt., Unit, Suite, and/or Bldg. No.) or P.O. Route and Box No. 228 W. Atlantic Boulevard			Company NAIC Number
City Ocean City State NJ ZIP Code 08226			

A3. Property Description (Lot and Block Numbers, Tax Parcel Number, Legal Description, etc.)
Block 70.14, Lot 9

A4. Building Use (e.g., Residential, Non-Residential, Addition, Accessory, etc.) Residential

A5. Latitude/Longitude: Lat. N 39° 17' 36.6" Long. W 74° 33' 40.3" Horizontal Datum: NAD 1927 NAD 1983

A6. Attach at least 2 photographs of the building if the Certificate is being used to obtain flood insurance.

A7. Building Diagram Number 1

A8. For a building with a crawlspace or enclosure(s):

a) Square footage of crawlspace or enclosure(s)	<u>N/A</u>	sq ft
b) No. of permanent flood openings in the crawlspace or enclosure(s) within 1.0 foot above adjacent grade	<u>0</u>	
c) Total net area of flood openings in A8.b	<u>0</u>	sq in
d) Engineered flood openings?	<input type="checkbox"/> Yes <input checked="" type="checkbox"/> No	

A9. For a building with an attached garage:

a) Square footage of attached garage	<u>563</u>	sq ft
b) No. of permanent flood openings in the attached garage within 1.0 foot above adjacent grade	<u>3</u>	
c) Total net area of flood openings in A9.b	<u>600</u>	sq in
d) Engineered flood openings?	<input checked="" type="checkbox"/> Yes <input type="checkbox"/> No	

SECTION B - FLOOD INSURANCE RATE MAP (FIRM) INFORMATION

B1. NFIP Community Name & Community Number Ocean City 345310		B2. County Name Cape May		B3. State New Jersey	
B4. Map/Panel Number 0001	B5. Suffix C	B6. FIRM Index Date 7/15/1992	B7. FIRM Panel Effective/Revised Date 9/5/1984	B8. Flood Zone(s) A-7	B9. Base Flood Elevation(s) (Zone AO, use base flood depth) 9.00'

B10. Indicate the source of the Base Flood Elevation (BFE) data or base flood depth entered in Item B9.
 FIS Profile FIRM Community Determined Other (Describe) _____

B11. Indicate elevation datum used for BFE in Item B9: NGVD 1929 NAVD 1988 Other (Describe) _____

B12. Is the building located in a Coastal Barrier Resources System (CBRS) area or Otherwise Protected Area (OPA)? Yes No
Designation Date _____ CBRS OPA

SECTION C - BUILDING ELEVATION INFORMATION (SURVEY REQUIRED)

C1. Building elevations are based on: Construction Drawings* Building Under Construction* Finished Construction
*A new Elevation Certificate will be required when construction of the building is complete.

C2. Elevations – Zones A1-A30, AE, AH, A (with BFE), VE, V1-V30, V (with BFE), AR, AR/A, AR/AE, AR/A1-A30, AR/AH, AR/AO. Complete Items C2.a-h below according to the building diagram specified in Item A7. Use the same datum as the BFE.
Benchmark Utilized Local Vertical Datum NGVD 1929
Conversion/Comments _____

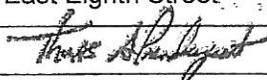
Check the measurement used.

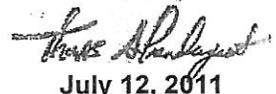
a) Top of bottom floor (including basement, crawlspace, or enclosure floor)	<u>10.00</u>	<input checked="" type="checkbox"/> feet <input type="checkbox"/> meters (Puerto Rico only)
b) Top of the next higher floor	<u>20.00</u>	<input checked="" type="checkbox"/> feet <input type="checkbox"/> meters (Puerto Rico only)
c) Bottom of the lowest horizontal structural member (V Zones only)	<u>N/A</u>	<input checked="" type="checkbox"/> feet <input type="checkbox"/> meters (Puerto Rico only)
d) Attached garage (top of slab)	<u>8.07</u>	<input checked="" type="checkbox"/> feet <input type="checkbox"/> meters (Puerto Rico only)
e) Lowest elevation of machinery or equipment servicing the building (Describe type of equipment and location in Comments)	<u>9.80</u>	<input checked="" type="checkbox"/> feet <input type="checkbox"/> meters (Puerto Rico only)
f) Lowest adjacent (finished) grade next to building (LAG)	<u>7.70</u>	<input checked="" type="checkbox"/> feet <input type="checkbox"/> meters (Puerto Rico only)
g) Highest adjacent (finished) grade next to building (HAG)	<u>7.97</u>	<input checked="" type="checkbox"/> feet <input type="checkbox"/> meters (Puerto Rico only)
h) Lowest adjacent grade at lowest elevation of deck or stairs, including structural support	<u>N/A</u>	<input checked="" type="checkbox"/> feet <input type="checkbox"/> meters (Puerto Rico only)

SECTION D - SURVEYOR, ENGINEER, OR ARCHITECT CERTIFICATION

This certification is to be signed and sealed by a land surveyor, engineer, or architect authorized by law to certify elevation information. I certify that the information on this Certificate represents my best efforts to interpret the data available. I understand that any false statement may be punishable by fine or imprisonment under 18 U.S. Code, Section 1001.

Check here if comments are provided on back of form. Were latitude and longitude in Section A provided by a licensed land surveyor? Yes No

Certifier's Name Thomas A. Prendergast, PLS	License Number GS37604
Title Professional Land Surveyor	Company Name Hyland Design Group, Inc.
Address 101 East Eighth Street	City Ocean City State NJ ZIP Code 08226
Signature 	Date 7/12/2011 Telephone 609.398.4477


July 12, 2011

IMPORTANT: In these spaces, copy the corresponding information from Section A.	For Insurance Company Use:
Building Street Address (including Apt., Unit, Suite, and/or Bldg. No.) or P.O. Route and Box No. 228 W. Atlantic Boulevard	Policy Number
City Ocean City State NJ ZIP Code 08226	Company NAIC Number

SECTION D - SURVEYOR, ENGINEER, OR ARCHITECT CERTIFICATION (CONTINUED)

Copy both sides of this Elevation Certificate for (1) community official, (2) insurance agent/company, and (3) building owner.

Comments C2b. Main Floor Elev 10.00
C2e. Lowest Mechanicals Exterior Condenser Elev 9.80

Signature *Thomas A. [Signature]* Date 7/12/2011 Check here if attachments

SECTION E - BUILDING ELEVATION INFORMATION (SURVEY NOT REQUIRED) FOR ZONE AO AND ZONE A (WITHOUT BFE)

For Zones AO and A (without BFE), complete Items E1-E5. If the Certificate is intended to support a LOMA or LOMR-F request, complete Sections A, B, and C. For Items E1-E4, use natural grade, if available. Check the measurement used. In Puerto Rico only, enter meters.

- E1. Provide elevation information for the following and check the appropriate boxes to show whether the elevation is above or below the highest adjacent grade (HAG) and the lowest adjacent grade (LAG).
 - a) Top of bottom floor (including basement, crawlspace, or enclosure) is _____ feet meters above or below the HAG.
 - b) Top of bottom floor (including basement, crawlspace, or enclosure) is _____ feet meters above or below the LAG.
- E2. For Building Diagrams 6-9 with permanent flood openings provided in Section A Items 8 and/or 9 (see pages 8-9 of Instructions), the next higher floor (elevation C2.b in the diagrams) of the building is _____ feet meters above or below the HAG.
- E3. Attached garage (top of slab) is _____ feet meters above or below the HAG.
- E4. Top of platform of machinery and/or equipment servicing the building is _____ feet meters above or below the HAG.
- E5. Zone AO only: If no flood depth number is available, is the top of the bottom floor elevated in accordance with the community's floodplain management ordinance? Yes No Unknown. The local official must certify this information in Section G.

SECTION F - PROPERTY OWNER (OR OWNER'S REPRESENTATIVE) CERTIFICATION

The property owner or owner's authorized representative who completes Sections A, B, and E for Zone A (without a FEMA-issued or community-issued BFE) or Zone AO must sign here. *The statements in Sections A, B, and E are correct to the best of my knowledge.*

Property Owner's or Owner's Authorized Representative's Name _____

Address _____ City _____ State _____ ZIP Code _____

Signature _____ Date _____ Telephone _____

Comments _____

Check here if attachments

SECTION G - COMMUNITY INFORMATION (OPTIONAL)

The local official who is authorized by law or ordinance to administer the community's floodplain management ordinance can complete Sections A, B, C (or E), and G of this Elevation Certificate. Complete the applicable item(s) and sign below. Check the measurement used in Items G8 and G9.

- 1. The information in Section C was taken from other documentation that has been signed and sealed by a licensed surveyor, engineer, or architect who is authorized by law to certify elevation information. (Indicate the source and date of the elevation data in the Comments area below.)
- 2. A community official completed Section E for a building located in Zone A (without a FEMA-issued or community-issued BFE) or Zone AO.
- 3. The following information (Items G4-G9) is provided for community floodplain management purposes.

G4. Permit Number <u>20080990</u>	G5. Date Permit Issued <u>8/6/08</u>	G6. Date Certificate Of Compliance/Occupancy Issued <u>8/15/11</u>
--------------------------------------	---	---

7. This permit has been issued for: New Construction Substantial Improvement

8. Elevation of as-built lowest floor (including basement) of the building: _____ feet meters (PR) Datum _____

9. BFE or (in Zone AO) depth of flooding at the building site: _____ feet meters (PR) Datum _____

10. Community's design flood elevation _____ feet meters (PR) Datum _____

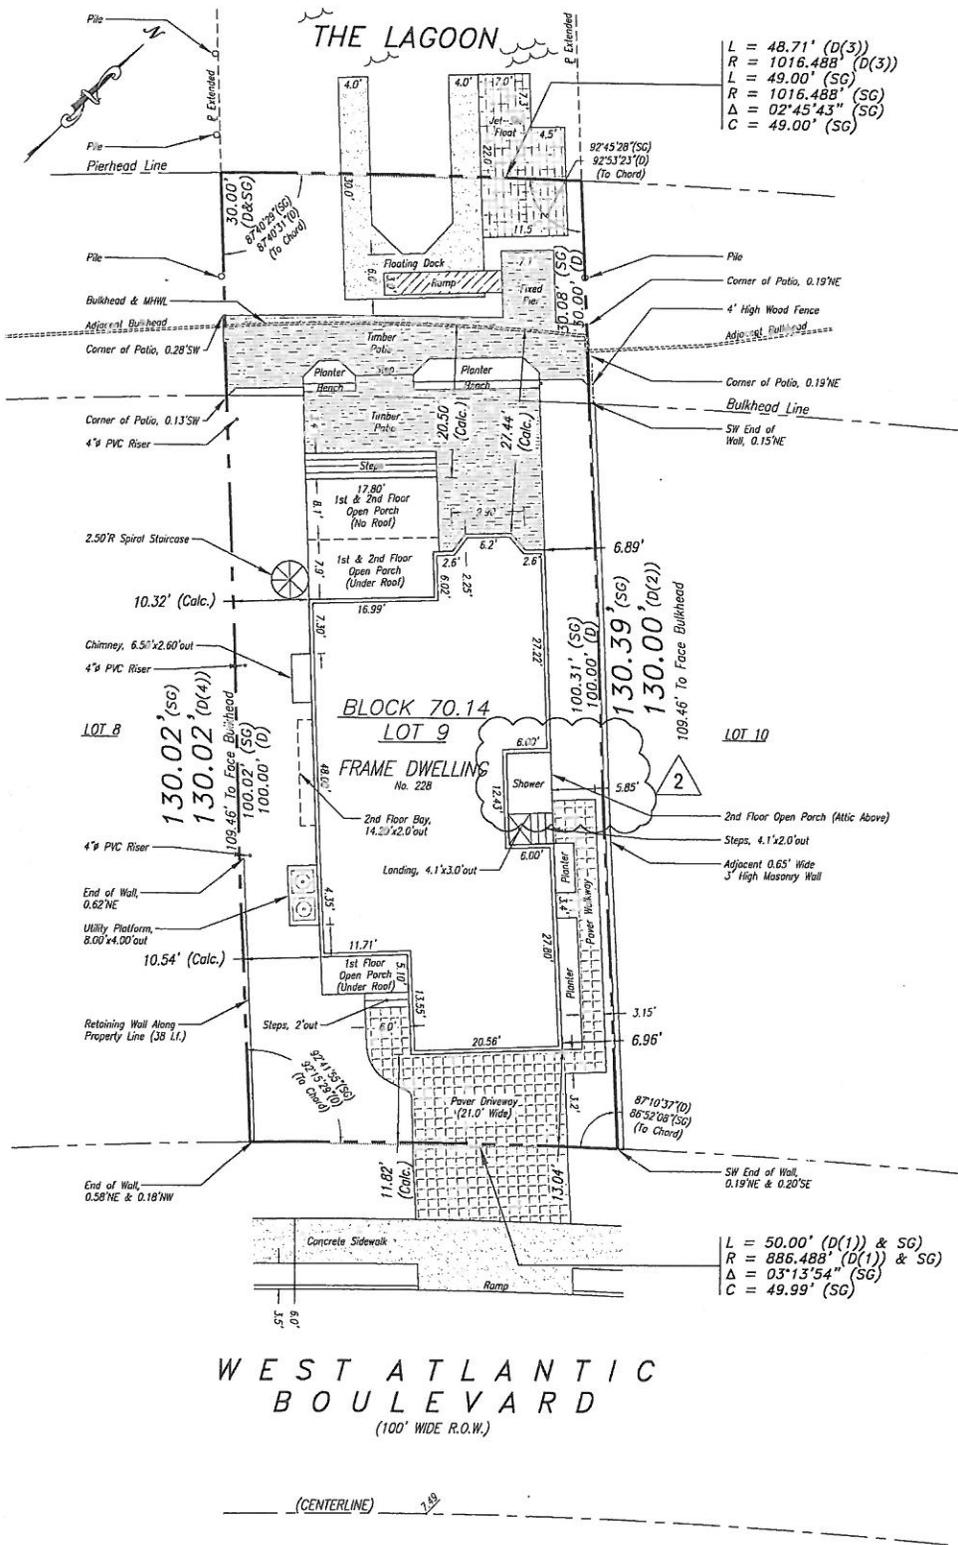
Local Official's Name _____ Title _____

Community Name _____ Telephone _____

Signature _____ Date _____

Comments _____

Check here if attachments



L = 48.71' (D(3))
 R = 1016.488' (D(3))
 L = 49.00' (SG)
 R = 1016.488' (SG)
 Δ = 02°45'43" (SG)
 C = 49.00' (SG)

L = 50.00' (D(1)) & SG
 R = 886.488' (D(1)) & SG
 Δ = 03°13'54" (SG)
 C = 49.99' (SG)

PROPERTY OUTBOUND LEGEND:

(D(1)) = (DEED/COURSE DESIGNATION) PROPERTY DIMENSIONS AS DESCRIBED IN DEED BOOK 3128, PAGE 60

(SG) = (SURVEY GEOMETRY) PROPERTY DIMENSIONS IN ADDITION TO OR AS A POSSIBLE CORRECTION TO CLOSE OR GEOMETRICALLY AGREE WITH DEED/SURVEY OUTBOUND

LEGEND:

(Calc.) = NOT DETERMINED IN FIELD (CALCULATED FROM FIELD WORK)

ELEVATION DATA:
 REFERENCE DATUM: SEA LEVEL DATUM (N.G.V.D., 1929)
 BENCHMARK: PK IN UTILITY POLE
 ELEV. 10.00

HIGHEST ADJACENT GRADE: ELEV. 7.97
 LOWEST ADJACENT GRADE: ELEV. 7.57
 MAIN FLOOR: ELEV. 10.00
 GARAGE FLOOR: ELEV. 8.07

☉ OF WEST ATLANTIC BOULEVARD @ ☉ OF LOT: ELEV. 7.53
 ROOF PEAK: ELEV. 39.06
 (Dwelling Height = 39.06 - 7.53 = 31.53)

ZONING DISTRICT:
 "RESIDENTIAL LAGOON ONE FAMILY ZONE"
 NEIGHBORHOOD (R-L-1-50)
 (NON-DISCRETE RESIDENTIAL DISTRICT)

LOT COVERAGE:
 LOT AREA: 5,441 S.F.
 (As Measured to Face of Bulkhead)

PROPOSED LOT COVERAGE:

HABITABLE BUILDING AREA:	1,870 S.F. (34.3%)
PORCH AREAS:	413 S.F.
CHIMNEY AREA:	17 S.F.
PLATFORM AREA:	32 S.F.
IMPERVIOUS AREA:	1,328 S.F.
TOTAL IMPERVIOUS COVERAGE:	3,660 S.F. (67.2%)*

* Per Section 25-300.8.2 of the Ocean City Ordinances, "Impervious Surface Coverage allowances may be offset a maximum of five percent (5%) above the maximum impervious surface coverage limits established in Section 25-209.1."

FLOOR AREA RATIO (FAR):
 TOTAL FLOOR AREA = 4,350 S.F.
 LOT AREA: 5,441 S.F.
 FLOOR AREA RATIO = 79.9%

WEST ATLANTIC BOULEVARD
 (100' WIDE R.O.W.)

FINAL AS-BUILT SURVEY

SCALE: 1" = 20'

DESCRIPTION:
 BEING KNOWN AS A PORTION OF LOT 1212 AND ALL OF LOT 1213, BLOCK 12, PLAN #3 OF OCEAN CITY GARDENS. TOGETHER WITH RIGHT OF USE OF THAT PORTION OF LAGOON TO THE PIERHEAD LINE.
 ALSO, BEING KNOWN AS LOT 1212B AND 1213, BLOCK 12-G AS SHOWN ON THE FORMER OFFICIAL TAX MAP OF THE CITY OF OCEAN CITY. TOGETHER WITH RIGHT OF USE OF THAT PORTION OF LAGOON TO THE PIERHEAD LINE.
 ALSO, BEING KNOWN AS LOT 9, BLOCK 70.14 AS SHOWN ON THE CURRENT OFFICIAL TAX MAP OF THE CITY OF OCEAN CITY. TOGETHER WITH RIGHT OF USE OF THAT PORTION OF LAGOON TO THE PIERHEAD LINE.
 BEING THE SAME LANDS AND PREMISES AS CONVEYED IN DEED FROM LOUIS E. AND PATRICIA M. OSWALD TO THOMAS AND JUDY UNDERWOOD, DATED DEC.19, 1995 AND FILED IN DEED BOOK 2655, PAGE 91.

- GENERAL NOTES:**
- FIELD WORK FOR SURVEY PERFORMED ON JUNE 3, 2011 AND JULY 7, 2011.
 - SURVEY PERFORMED WITHOUT THE BENEFIT OF A CURRENT TITLE REPORT.
 - THE INFORMATION SHOWN HEREON CORRECTLY REPRESENTS THE CONDITIONS FOUND AT, AND AS OF THE DATE OF THE FIELD WORK. THIS PROPERTY IS SUBJECT TO DOCUMENTS OF RECORD, UNDERGROUND IMPROVEMENTS, EASEMENTS, RIGHTS, RESTRICTIONS, RIGHT OF WAYS, EXCEPTIONS OR COVENANTS NOT VISIBLE OR UNKNOWN TO THE SURVEYOR ARE NOT SHOWN. THE ILLUSTRATION OF ANY MAPPED OR REGULATED ENVIRONMENTAL CONSTRAINTS THAT MAY BE WITHIN THE JURISDICTIONAL LIMITS OF FEDERAL, STATE AND/OR LOCAL REGULATORY AGENCIES AFFECTING THE SUBJECT PROPERTY ARE NOT INCLUDED AS PART OF CONTRACT WITH THE CLIENT UNLESS SPECIFICALLY SHOWN.
 - UNDERLINED TAX LOT AND BLOCK DESIGNATIONS AS SHOWN HEREON ARE PER THE OFFICIAL TAX MAP OF THE CITY OF OCEAN CITY, PREPARED BY JOHN R. WALKER, DATED NOVEMBER 1980.
 - THE SUBJECT LOT LIES IN FLOOD ZONE 'A7' (EL. 9) AS SHOWN ON FEMA FLOOD INSURANCE RATE MAP COMMUNITY PANEL No. 345310 0001 C, REVISED SEPTEMBER 5, 1984.

HYLAND DESIGN GROUP
 Hyland Design Group, Inc
 101 East Eight Street
 Ocean City, New Jersey 08226
 (p) 609.398.4477
 (f) 609.398.7366
 www.HylandDesignGroup.com

The "Single Source Advantage"
 • ENGINEERS • ARCHITECTS • SURVEYORS • PLANNERS
 • ENVIRONMENTAL CONSULTING • INTERIOR DESIGNERS

FINAL AS-BUILT SURVEY
 228 WEST ATLANTIC BOULEVARD
 TAX BLOCK 70.14 TAX LOT 9
 CITY OF OCEAN CITY
 CAPE MAY COUNTY, NEW JERSEY

PREPARED FOR:
ROBERT P. JR. AND MARY ANN DIMARCO

I declare that, to the best of my professional knowledge and belief, this map or plan is the result of a field survey made on the site shown below, by me or under my direct supervision, in accordance with the rules and regulations promulgated by the State Board of Professional Engineers and Land Surveyors.

Thomas A. Prendergast
 Thomas A. Prendergast
 NJ PROFESSIONAL LAND SURVEYOR No. 3304

PROJECT No:	5376.03	No.	DATE	DESCRIPTION	SHEET TITLE: FINAL AS-BUILT SURVEY V1.2 SHEET 1 OF 1
DRAWN BY:	RDS	1.	06.07.11	INITIAL RELEASE	
CHECKED BY:	TAP	2.	07.07.11	Updated Survey	
FIELD BOOK/PAGE:	1055/69-73				