

ELEVATION CERTIFICATE

04-311

Important: Read the instructions on pages 1-7.

SECTION A - PROPERTY OWNER INFORMATION

BUILDING OWNER'S NAME: JEFFREY FROST, BUILDER

BUILDING STREET ADDRESS (Including Apt., Unit, Suite, and/or Bldg. No.) OR P.O. ROUTE AND BOX NO.: 328 WEST SURF ROAD

CITY: OCEAN CITY STATE: NJ ZIP CODE: 08226

PROPERTY DESCRIPTION (Lot and Block Numbers, Tax Parcel Number, Legal Description, etc.): LOT 9 BLOCK 70.18

BUILDING USE (e.g., Residential, Non-residential, Addition, Accessory, etc. Use a Comments area, if necessary.): RESIDENTIAL

LATITUDE/LONGITUDE (OPTIONAL) (##° - ##' - ###.###" or ##.#####"): _____

HORIZONTAL DATUM: NAD 1927 NAD 1983

SOURCE: GPS (Type): _____ USGS Quad Map Other: _____

SECTION B - FLOOD INSURANCE RATE MAP (FIRM) INFORMATION

B1. NFIP COMMUNITY NAME & COMMUNITY NUMBER: 345310 OCEAN CITY

B2. COUNTY NAME: CAPE MAY

B3. STATE: NEW JERSEY

B4. MAP AND PANEL NUMBER: 345310-0001	B5. SUFFIX: C	B6. FIRM INDEX DATE: 7-15-92	B7. FIRM PANEL EFFECTIVE/REVISED DATE: 9-5-84	B8. FLOOD ZONE(S): A-7	B9. BASE FLOOD ELEVATION(S) (Zone AO, use depth of flooding): 9 FT
---------------------------------------	---------------	------------------------------	---	------------------------	--

B10. Indicate the source of the Base Flood Elevation (BFE) data or base flood depth entered in B9.
 FIS Profile FIRM Community Determined Other (Describe): _____

B11. Indicate the elevation datum used for the BFE in B9: NGVD 1929 NAVD 1988 Other (Describe): _____

B12. Is the building located in a Coastal Barrier Resources System (CBRS) area or Otherwise Protected Area (OPA)? Yes No Designation Date: _____

SECTION C - BUILDING ELEVATION INFORMATION (SURVEY REQUIRED)

C1. Building elevations are based on: Construction Drawings* Building Under Construction* Finished Construction

*A new Elevation Certificate will be required when construction of the building is complete.

C2. Building Diagram Number 8 (Select the building diagram most similar to the building for which this certificate is being completed - see pages 6 and 7. If no diagram accurately represents the building, provide a sketch or photograph.)

C3. Elevations - Zones A1-A30, AE, AH, A (with BFE), VE, V1-V30, V (with BFE), AR, AR/A, AR/AE, AR/A1-A30, AR/AH, AR/AO

Complete Items C3.-a-i below according to the building diagram specified in Item C2. State the datum used. If the datum is different from the datum used for the BFE in Section B, convert the datum to that used for the BFE. Show field measurements and datum conversion calculation. Use the space provided or the Comments area of Section D or Section G, as appropriate, to document the datum conversion.

Datum SAME Conversion/Comments NONE

Elevation reference mark used PRVT Does the elevation reference mark used appear on the FIRM? Yes No

- a) Top of bottom floor (including basement or enclosure) 6.8 ft.(m)
- b) Top of next higher floor 10.0 ft.(m)
- c) Bottom of lowest horizontal structural member (V zones only) NA. ft.(m)
- d) Attached garage (top of slab) 7.2 ft.(m)
- e) Lowest elevation of machinery and/or equipment servicing the building (Describe in a Comments area) 10.0 ft.(m)
- f) Lowest adjacent (finished) grade (LAG) 6.6 ft.(m)
- g) Highest adjacent (finished) grade (HAG) 6.8 ft.(m)
- h) No. of permanent openings (flood vents) within 1 ft. above adjacent grade 17
- i) Total area of all permanent openings (flood vents) in C3.h *4,480 sq. in. (sq. cm)

License Number, Embossed Seal, Signature, and Date

10/24/08
GS 33536

SECTION D - SURVEYOR, ENGINEER, OR ARCHITECT CERTIFICATION

This certification is to be signed and sealed by a land surveyor, engineer, or architect authorized by law to certify elevation information.
I certify that the information in Sections A, B, and C on this certificate represents my best efforts to interpret the data available.
I understand that any false statement may be punishable by fine or imprisonment under 18 U.S. Code, Section 1001.

CERTIFIER'S NAME: JAMES E. SCHWAB III

TITLE: LAND SURVEYOR

ADDRESS: 8 EAST 10TH STREET

SIGNATURE:

LICENSE NUMBER: 33,536

COMPANY NAME: SCHWAB LAND SURVEYING AND PLANNING, LLC

CITY: OCEAN CITY STATE: NJ ZIP CODE: 08226

DATE: 10/24/08 TELEPHONE: 609-398-0565

IMPORTANT: In these spaces, copy the corresponding information from Section A.

BUILDING STREET ADDRESS (Including Apt., Unit, Suite, and/or Bldg. No.) OR P.O. ROUTE AND BOX NO.

328 WEST SURF ROAD

CITY
OCEAN CITY

STATE
NJ

ZIP CODE
08226

For Insurance Company Use:

Policy Number

Company NAIC Number

SECTION D - SURVEYOR, ENGINEER, OR ARCHITECT CERTIFICATION (CONTINUED)

Copy both sides of this Elevation Certificate for (1) community official, (2) insurance agent/company, and (3) building owner.

COMMENTS

C3A IS CRAWLSPACE, C3B IS FIRST FLOOR, C3E IS FIRST FLOOR

*C3I IS GROSS VENT AREA. 3 VENTS WITH A GROSS AREA OF OF 768 SQ.IN. ARE IN THE GARAGE.

Check here if attachments

SECTION E - BUILDING ELEVATION INFORMATION (SURVEY NOT REQUIRED) FOR ZONE AO AND ZONE A (WITHOUT BFE)

For Zone AO and Zone A (without BFE), complete Items E1 through E4. If the Elevation Certificate is intended for use as supporting information for a LOMA or LOMR-F, Section C must be completed.

E1. Building Diagram Number __ (Select the building diagram most similar to the building for which this certificate is being completed – see pages 6 and 7. If no diagram accurately represents the building, provide a sketch or photograph.)

E2. The top of the bottom floor (including basement or enclosure) of the building is __ ft.(m) __ in.(cm) above or below (check one) the highest adjacent grade. (Use natural grade, if available).

E3. For Building Diagrams 6-8 with openings (see page 7), the next higher floor or elevated floor (elevation b) of the building is __ ft.(m) __ in.(cm) above the highest adjacent grade. Complete items C3.h and C3.i on front of form.

E4. The top of the platform of machinery and/or equipment servicing the building is __ ft.(m) __ in.(cm) above or below (check one) the highest adjacent grade. (Use natural grade, if available).

E5. For Zone AO only: If no flood depth number is available, is the top of the bottom floor elevated in accordance with the community's floodplain management ordinance?

Yes No Unknown. The local official must certify this information in Section G.

SECTION F - PROPERTY OWNER (OR OWNER'S REPRESENTATIVE) CERTIFICATION

The property owner or owner's authorized representative who completes Sections A, B, C (Items C3.h and C3.i only), and E for Zone A (without a FEMA-issued or community-issued BFE) or Zone AO must sign here. *The statements in Sections A, B, C, and E are correct to the best of my knowledge.*

PROPERTY OWNER'S OR OWNER'S AUTHORIZED REPRESENTATIVE'S NAME

ADDRESS CITY STATE ZIP CODE

SIGNATURE DATE TELEPHONE

COMMENTS

Check here if attachments

SECTION G - COMMUNITY INFORMATION (OPTIONAL)

The local official who is authorized by law or ordinance to administer the community's floodplain management ordinance can complete Sections A, B, C (or E), and G of this Elevation Certificate. Complete the applicable item(s) and sign below.

G1. The information in Section C was taken from other documentation that has been signed and embossed by a licensed surveyor, engineer, or architect who is authorized by state or local law to certify elevation information. (Indicate the source and date of the elevation data in the Comments area below.)

G2. A community official completed Section E for a building located in Zone A (without a FEMA-issued or community-issued BFE) or Zone AO.

G3. The following information (Items G4-G9) is provided for community floodplain management purposes.

G4. PERMIT NUMBER 20050097	G5. DATE PERMIT ISSUED 1/13/05	G6. DATE CERTIFICATE OF COMPLIANCE/OCCUPANCY ISSUED 10/27/05
-------------------------------	-----------------------------------	---

G7. This permit has been issued for: New Construction Substantial Improvement

G8. Elevation of as-built lowest floor (including basement) of the building is: _____ ft.(m) Datum: _____

G9. BFE or (in Zone AO) depth of flooding at the building site is: _____ ft.(m) Datum: _____

LOCAL OFFICIAL'S NAME TITLE

COMMUNITY NAME TELEPHONE



SIGNATURE DATE

COMMENTS

Check here if attachments

CITY OF OCEAN CITY
CAPE MAY COUNTY

SURF ROAD (60' WIDE)

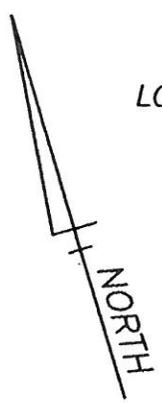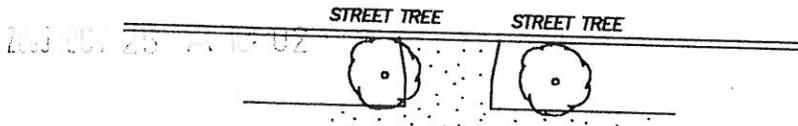


LOT 8

BLOCK
70.18

CEDAR WALK
(10' WIDE)

LOT 10

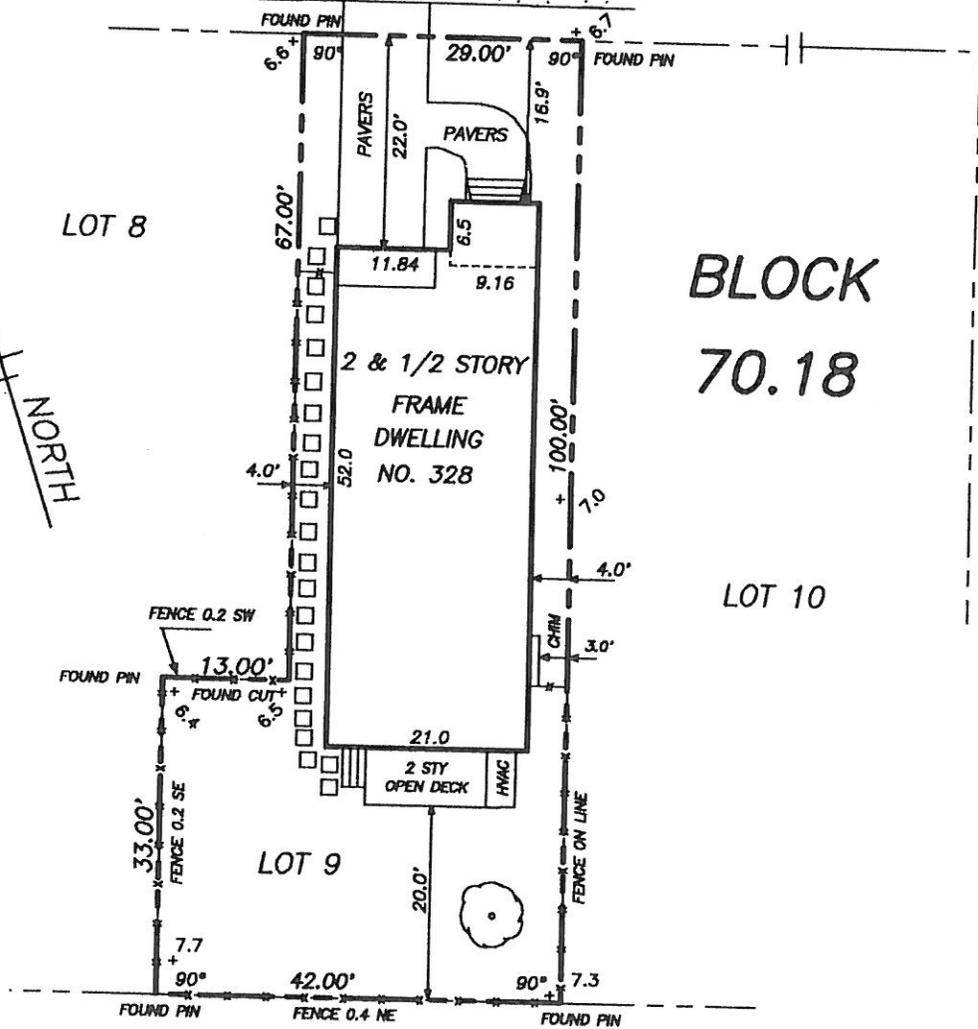

COVERAGE AND HEIGHT

LOT AREA- 3,329 SF.
 * BUILDING AREA- 1,139 SF., 34.2%
 3RD FLOOR AREA- 494 SF., 45.8%
 OF 2ND FLOOR AREA
 IMPERVIOUS AREA- 1,584 SF., 47.6%
 CENTERLINE ELEVATION- 6.68 FT.
 PEAK ELEVATION- 39.3 FT.
 BUILDING HEIGHT- 32.6 FT.

* INCLUDES GARAGE AREA OUTSIDE HABITABLE AREA
 + X.X= EXISTING NGVD 1929 ELEVATION

ISSUED TO:

JEFFREY FROST, BUILDER

FINAL CONSTRUCTION SURVEY

NOT FOR CONVEYANCE

LOT 9 BLOCK 70.18
CITY OF OCEAN CITY
CAPE MAY COUNTY, NJ.

DATE: OCT. 24, 2005 SCALE: 1"= 20' DWN. BY: JES


**SCHWAB LAND SURVEYING
AND PLANNING, LLC.**

8 EAST 10TH STREET
OCEAN CITY, NEW JERSEY 08226

TELE 609-398-0565 FAX 398-1861

CERTIFICATE OF AUTHORIZATION NO. 24GA28101600

FILE: 04-311 FIELD BOOK: ~~~

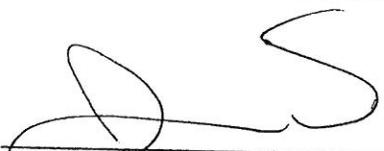
 10/24/05
JAMES E. SCHWAB III
 PROFESSIONAL LAND SURVEYOR
 NEW JERSEY LICENSE NO. 33,536