U.S. DEPARTMENT OF HOMELAND SECURITY Federal Emergency Management Agency National Flood Insurance Program

ELEVATION CERTIFICATE


OMB No. 1660-0008 Expires March 31, 2012

Important: Read the instructions on pages 1-9. 08.038

		SECTI	ON A - PRO	PERTY INFOR	RMATION	1	For Insurance Company Use:
A1. Building Owner's Name	WALL TO SERVICE THE PROPERTY OF THE PROPERTY O			A second			Policy Number
A2. Building Street Address 253 WEST INLET ROAD		, Unit, Suite, and/or Bl	dg. No.) or P.C). Route and Bo	x No.		Company NAIC Number
City OCEAN CITY		P Code 08226					
A3. Property Description (L LOT 13 BLOCK 70.21	ot and Block Nu	mbers, Tax Parcel Nu	ımber, Legal D	escription, etc.)			
A4. Building Use (e.g., Res A5. Latitude/Longitude: Lat A6. Attach at least 2 photo A7. Building Diagram Num A8. For a building with a cr a) Square footage of b) No. of permanent f enclosure(s) within c) Total net area of for d) Engineered flood of	t. N 39° 17' 29.47 graphs of the builder 1 rawlspace or enc crawlspace or enflood openings in 1.0 foot above a bood openings in A openings?	7" Long. W 74° 33' 3' idling if the Certificate closure(s): nclosure(s) the crawlspace or adjacent grade	32.70" is being used NA sq ft sq in	to obtain flood in A9. For a) b) c) d)	r a building Square fo No. of per within 1.0 Total net Engineero	y with an attach potage of attach rmanent flood of foot above adj area of flood op ed flood openir	ned garage <u>NA</u> sq ft openings in the attached garage facent grade penings in A9.b sq in
P4 NEID Commission No.					IIXIVI) INF		33. State
B1. NFIP Community Name OCEAN CITY 345310	a Community N		B2. County Nar CAPE MAY			1 (3)	J. State
B4. Map/Panel Number 345310-0001	B5. Suffix C	B6. FIRM Index Date 7-15-92	Effective	FIRM Panel e/Revised Date 9-5-84		B8. Flood Zone(s) A-7	B9. Base Flood Elevation(s) (Zone AO, use base flood depth) 9 FT
B10. Indicate the source of t FIS Profile B11. Indicate elevation datu B12. Is the building located Designation Date	☐ FIRM Im used for BFE i in a Coastal Barr	☐ Community Deter	mined 0 1929	☐ Other (Desc	cribe)	_ ther (Describe) rea (OPA)?	 □ Yes ⊠ No
	SECTIO	N C - BUILDING E	LEVATION I	NFORMATIO	N (SURV	EY REQUIRE	:D)
below according to the benchmark Utilized PR Conversion/Comments	cate will be requi A30, AE, AH, A (building diagram <u>VT</u> Vertical Datur <u>NONE</u>	(with BFE), VE, V1-V3: specified in Item A7. m 1929	n of the building 0, V (with BFE Use the same), AR, AR/A, AR datum as the B	R/AE, AR/A FE. Check	1-A30, AR/AH,	
		ment, crawlspace, or e	enclosure floor)			meters (Puerto	
b) Top of the next highc) Bottom of the lower		ctural member (V Zon	es only)			meters (Puerto	
d) Attached garage (to					3 1001	(Rico only)
					₫ feet 🔲	meters (Puerto	Rico only)
	f machinery or ed	quipment servicing the cation in Comments)	• building		₫ feet 🔲		Rico only)
	f machinery or ec quipment and loo inished) grade ne	cation in Comments) ext to building (LAG)	building	<u>NA</u> . ⊠ 8.7 ⊠	feet feet feet feet feet	meters (Puerto meters (Puerto meters (Puerto	o Rico only) o Rico only) o Rico only)
g) Highest adjacent (fh) Lowest adjacent gr	f machinery or ec quipment and loo inished) grade ne finished) grade ne	cation in Comments)		8.7 × 9.0	feet feet feet feet feet feet feet feet	meters (Puerto meters (Puerto	o Rico only) o Rico only) o Rico only) o Rico only)
g) Highest adjacent (f	f machinery or ed equipment and loo inished) grade ne finished) grade ne rade at lowest ele	cation in Comments) ext to building (LAG) ext to building (HAG)	rs, including	8.7 × 9.0 × NA. ×	feet	meters (Puerto meters (Puerto meters (Puerto meters (Puerto meters (Puerto	o Rico only)
g) Highest adjacent (fh) Lowest adjacent gr	f machinery or ect equipment and local inished) grade ne finished) grade ne rade at lowest ele SECTIO gned and sealed the information on thatement may be	cation in Comments) ext to building (LAG) ext to building (HAG) evation of deck or stain ON D - SURVEYOR by a land surveyor, er this Certificate repres e punishable by fine or n back of form.	rs, including R, ENGINEER Ingineer, or arcle Inents my best er Imprisonment	NA. S 8.7 9.0 NA. S R, OR ARCHIT hitect authorized afforts to interpret under 18 U.S. Cand longitude in surveyor?	feet	meters (Puerto exailable.) tion 1001. provided by a No	o Rico only)
g) Highest adjacent (f h) Lowest adjacent gr structural support This certification is to be signiformation. I certify that th understand that any false s	f machinery or ec equipment and loc inished) grade ne finished) grade ne rade at lowest ele SECTIO gned and sealed the information on tatement may be ts are provided on	cation in Comments) ext to building (LAG) ext to building (HAG) evation of deck or stain ON D - SURVEYOR by a land surveyor, er this Certificate repres e punishable by fine or n back of form.	rs, including R, ENGINEER Ingineer, or archents my best er Imprisonment Were latitude a licensed land s	NA. 8.7 9.0 NA. R, OR ARCHIT hitect authorized efforts to interpret under 18 U.S. (and longitude in surveyor?	feet	meters (Puerto available.) tion 1001. provided by a No	o Rico only)
g) Highest adjacent (f h) Lowest adjacent gr structural support This certification is to be sig information. I certify that th understand that any false s Check here if comment Certifier's Name JAMES E.	f machinery or ectouring from the control of the co	cation in Comments) ext to building (LAG) ext to building (HAG) evation of deck or stain ON D - SURVEYOR by a land surveyor, er this Certificate repres e punishable by fine or n back of form. Company Name Si	rs, including R, ENGINEER Ingineer, or archents my best er Imprisonment Were latitude a licensed land s	NA. 8.7 9.0 NA. R, OR ARCHIT hitect authorized efforts to interpret under 18 U.S. (and longitude in surveyor? License Numb	feet	meters (Puerto entify elevatio available. I tion 1001. provided by a No 3353600	o Rico only)
g) Highest adjacent (f h) Lowest adjacent gr structural support This certification is to be sig information. I certify that th understand that any false s Check here if comment	f machinery or ectouring from the control of the co	cation in Comments) ext to building (LAG) ext to building (HAG) evation of deck or stain ON D - SURVEYOR by a land surveyor, er this Certificate repres e punishable by fine or n back of form.	rs, including R, ENGINEER Ingineer, or archents my best er Imprisonment Were latitude a licensed land s	NA. 8.7 9.0 NA. R, OR ARCHIT hitect authorized efforts to interpret under 18 U.S. (and longitude in surveyor?	feet	meters (Puerto ertify elevation 1001. ☑ provided by a □ No 3353600 INING, LLC.	o Rico only)

c iii alooc opaoco, oc	opy the corresponding information from Section A.	For Insurance Company Use:
Building Street Address (including Apt., 253 WEST INLET ROAD- GARAGE	Unit, Suite, and/or Bldg. No.) or P.O. Route and Box No.	Policy Number
City OCEAN CITYState NJ ZIP Code	: 08226	Company NAIC Number
SECTION	D - SURVEYOR, ENGINEER, OR ARCHITECT CERTIF	FICATION (CONTINUED)
Copy both sides of this Elevation Certific	icate for (1) community official, (2) insurance agent/company, a	nd (3) building owner.
Comments BUILDING IS DETACHED DATE OF FIELD SURVEY 4-28-11.	GARAGE. C2A IS LOW END OF SLAB.	
		•=
	5/2/11	,
Signature	Date	☐ Check here if attachme
SECTION E-BUILDING ELEV	ATION INFORMATION (SURVEY NOT REQUIRED) FOR	OR ZONE AO AND ZONE A (WITHOUT BFE)
 and C. For Items E1-E4, use natural gr. E1. Provide elevation information for the grade (HAG) and the lowest adjact a) Top of bottom floor (including bits) Top of bottom floor (including bits). E2. For Building Diagrams 6-9 with per (elevation C2.b in the diagrams) or elevation G2.b in the diagrams. E3. Attached garage (top of slab) is 	pasement, crawlspace, or enclosure) is fee pasement, crawlspace, or enclosure) is fee parmanent flood openings provided in Section A Items 8 and/or 9 of the building is feet meters above	co only, enter meters. the elevation is above or below the highest adjacent et meters above or below the HAG. et meters below the LAG. (see pages 8-9 of Instructions), the next higher floor below the HAG. (see pages 8-9 of Instructions), the next higher floor below the HAG.
E5. Zone AO only: If no flood depth no	number is available, is the top of the bottom floor elevated in acc	cordance with the community's floodplain manageme
	Unknown. The local official must certify this information in Se	
	F - PROPERTY OWNER (OR OWNER'S REPRESENT	
or Zone AO must sign here. The statem	ed representative who completes Sections A, B, and E for Zone nents in Sections A, B, and E are correct to the best of my know	∍ A (without a FEMA-issued or community-issued BFI vledge.
Property Owner's or Owner's Authorized	d Representative's Name	
Address	City	State ZIP Code
Signature	Date	Telephone
omments		
		Check here if attachm
a local official who is sufficient by law.	SECTION G - COMMUNITY INFORMATION (OPT	rional)
e local official who is authorized by law	or ordinance to administer the community's floodplain manage	FIONAL)
G of this Elevation Certificate. Compli . The information in Section C wa	or ordinance to administer the community's floodplain manage lete the applicable item(s) and sign below. Check the measure as taken from other documentation that has been signed and se	FIONAL) Iment ordinance can complete Sections A, B, C (or E) Iment used in Items G8 and G9. Realed by a licensed surveyor, engineer, or architect we
 G of this Elevation Certificate. Complete The information in Section C was is authorized by law to certify electric certification. 	or ordinance to administer the community's floodplain manage lete the applicable item(s) and sign below. Check the measure	FIONAL) Iment ordinance can complete Sections A, B, C (or E) Iment used in Items G8 and G9. Imealed by a licensed surveyor, engineer, or architect we Item data in the Comments area below.)
G of this Elevation Certificate. Complete G or this Elevation Certificate. Complete G or this Elevation Certificate. Complete G or this Elevation Certificate. Completed G or this Elevation Certificate. Completed G or this Elevation Certificate. Completed G or this Elevation Certificate. Complete G or this Elevation Certificate. Certificate G or this Elevation Certificate G or this Elevat	or ordinance to administer the community's floodplain manage lete the applicable item(s) and sign below. Check the measure as taken from other documentation that has been signed and se evation information. (Indicate the source and date of the elevation information.	rional) ment ordinance can complete Sections A, B, C (or E) ment used in Items G8 and G9. paled by a licensed surveyor, engineer, or architect we tion data in the Comments area below.) ued or community-issued BFE) or Zone AO.
The information in Section C wa is authorized by law to certify ele A community official completed 3. The following information (Items 4. Permit Number	or ordinance to administer the community's floodplain manage lete the applicable item(s) and sign below. Check the measure as taken from other documentation that has been signed and se evation information. (Indicate the source and date of the eleval Section E for a building located in Zone A (without a FEMA-issis G4-G9) is provided for community floodplain management pur	rional) ment ordinance can complete Sections A, B, C (or E) ment used in Items G8 and G9. paled by a licensed surveyor, engineer, or architect we tion data in the Comments area below.) ued or community-issued BFE) or Zone AO.
The information in Section C wa is authorized by law to certify ele A community official completed of the following information (Items 4. Permit Number	or ordinance to administer the community's floodplain manage lete the applicable item(s) and sign below. Check the measure as taken from other documentation that has been signed and se evation information. (Indicate the source and date of the eleval Section E for a building located in Zone A (without a FEMA-issis G4-G9) is provided for community floodplain management pur	rional) ment ordinance can complete Sections A, B, C (or E) ment used in Items G8 and G9. ealed by a licensed surveyor, engineer, or architect w tion data in the Comments area below.) ued or community-issued BFE) or Zone AO. rposes.
The information in Section C wa is authorized by law to certify ele A community official completed of the following information (Items 4. Permit Number This permit has been issued for: Elevation of as-built lowest floor (included)	or ordinance to administer the community's floodplain manage lete the applicable item(s) and sign below. Check the measure as taken from other documentation that has been signed and se evation information. (Indicate the source and date of the elevation Section E for a building located in Zone A (without a FEMA-issis G4-G9) is provided for community floodplain management pure G5. Date Permit Issued G6. Date Section I Substantial Improvement Indiang basement) of the building: feet m	rional) ment ordinance can complete Sections A, B, C (or E) ment used in Items G8 and G9. ealed by a licensed surveyor, engineer, or architect w tion data in the Comments area below.) ued or community-issued BFE) or Zone AO. rposes.
The information in Section C wa is authorized by law to certify ele A community official completed of the following information (Items 4. Permit Number This permit has been issued for: Elevation of as-built lowest floor (included)	or ordinance to administer the community's floodplain manage lete the applicable item(s) and sign below. Check the measure as taken from other documentation that has been signed and se evation information. (Indicate the source and date of the elevation Section E for a building located in Zone A (without a FEMA-issis G4-G9) is provided for community floodplain management put G5. Date Permit Issued G6. Date C6 New Construction Substantial Improvement Inding basement) of the building: feet management	rment ordinance can complete Sections A, B, C (or E, ement used in Items G8 and G9. ealed by a licensed surveyor, engineer, or architect we tion data in the Comments area below.) ued or community-issued BFE) or Zone AO. rposes. eartificate Of Compliance/Occupancy Issued
The information in Section C wa is authorized by law to certify election C was is authorized by law to certify election C was in authorized by law to certify election C was in authorized by law to certify election C was in authorized by law to certify election C was in authorized by law to certify election C was in authorized by law to certify election C was in a certification of the certification C was in a certifica	or ordinance to administer the community's floodplain manage lete the applicable item(s) and sign below. Check the measure as taken from other documentation that has been signed and se evation information. (Indicate the source and date of the elevation Section E for a building located in Zone A (without a FEMA-issis G4-G9) is provided for community floodplain management put G5. Date Permit Issued G6. Date C6 G6. D	rment ordinance can complete Sections A, B, C (or E, ement used in Items G8 and G9. ealed by a licensed surveyor, engineer, or architect we tion data in the Comments area below.) ued or community-issued BFE) or Zone AO. rposes. ertificate Of Compliance/Occupancy Issued
The information in Section C wa is authorized by law to certify election C was a suthorized by law to certify election C was a community official completed S. A community official completed S. The following information (Items 4. Permit Number This permit has been issued for: Elevation of as-built lowest floor (included BFE or (in Zone AO) depth of flooding C. Community's design flood elevation	or ordinance to administer the community's floodplain manage lete the applicable item(s) and sign below. Check the measure as taken from other documentation that has been signed and se evation information. (Indicate the source and date of the elevation Section E for a building located in Zone A (without a FEMA-issis G4-G9) is provided for community floodplain management put G5. Date Permit Issued G6. Date C6 G6. D	rment ordinance can complete Sections A, B, C (or E, ement used in Items G8 and G9. ealed by a licensed surveyor, engineer, or architect we tion data in the Comments area below.) used or community-issued BFE) or Zone AO. rposes. eartificate Of Compliance/Occupancy Issued teters (PR) Datum neters (PR) Datum
The information in Section C wa is authorized by law to certify elected. A community official completed of the following information (Items of the following of the	or ordinance to administer the community's floodplain manage lete the applicable item(s) and sign below. Check the measure as taken from other documentation that has been signed and se evation information. (Indicate the source and date of the elevation Section E for a building located in Zone A (without a FEMA-issis G4-G9) is provided for community floodplain management putous G5. Date Permit Issued G6. Date C6 G6. Date C6 G7	rment ordinance can complete Sections A, B, C (or E, ement used in Items G8 and G9. ealed by a licensed surveyor, engineer, or architect we tion data in the Comments area below.) used or community-issued BFE) or Zone AO. rposes. eartificate Of Compliance/Occupancy Issued teters (PR) Datum neters (PR) Datum
d G of this Elevation Certificate. Completed G of this Elevation Certificate. Completed is authorized by law to certify election. ☐ A community official completed G of this Elevation Certificate. ☐ The following information (Items	or ordinance to administer the community's floodplain manage lete the applicable item(s) and sign below. Check the measure as taken from other documentation that has been signed and se evation information. (Indicate the source and date of the elevation Section E for a building located in Zone A (without a FEMA-issis G4-G9) is provided for community floodplain management putous G5. Date Permit Issued G6. Date C6	rment ordinance can complete Sections A, B, C (or E, ement used in Items G8 and G9. ealed by a licensed surveyor, engineer, or architect we tion data in the Comments area below.) used or community-issued BFE) or Zone AO. rposes. eartificate Of Compliance/Occupancy Issued teters (PR) Datum neters (PR) Datum

INLET ROAD (60' WIDE)

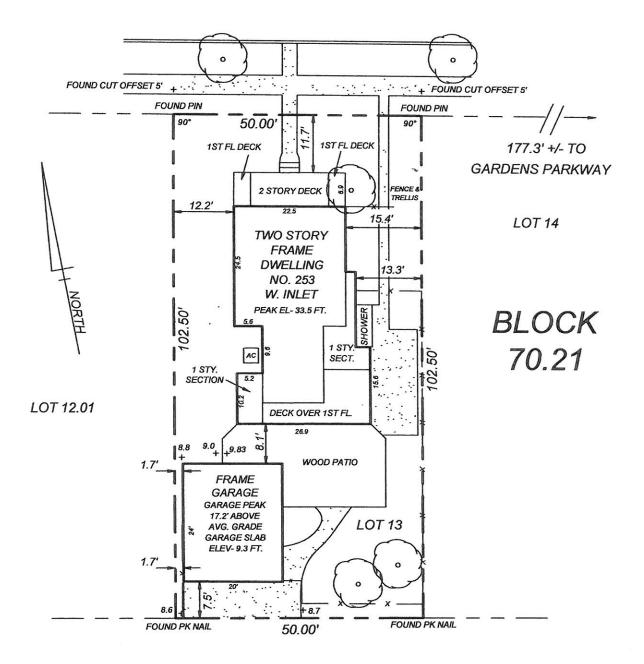

15 FEET WIDE PUBLIC ALLEY

ISSUED TO: GENE WEBER

+ X.X = EXISTING NGVD 1929 ELEVATION

EXISTING COVERAGE

LOT AREA- 5,125 SQ.FT

BUILDING AREA- 1,524 SQ.FT., 29.7%

IMPERVIOUS AREA- 2,733 SQ.FT., 53.3 %

THIS SURVEY IS FOR USE IN APPLYING FOR MUNICIPAL APPROVAL OF NEW CONSTRUCTION. THE SURVEYOR WILL ACCEPT NO RESPONSIBILITY FOR ITS USE FOR ANY OTHER PURPOSE.

4-26-11 FINAL CONDITIONS 1-11-11 ADDED GARAGE UNDER CONST. 8-17-10 UPDATED AND RE-ISSUED

SURVEY OF EXISTING IMPROVEMENTS

~~~NOT FOR CONVEYANCE~~~

# LOT 13 BLOCK 70.21 CITY OF OCEAN CITY CAPE MAY COUNTY, NJ

DATE: MAR. 3, 2008 SCALE: 1" = 20'

# SCHWAB LAND SURVEYING AND PLANNING, LLC

8 EAST 10TH STREET OCEAN CITY, NJ 08226

TELE 609-398-0565


FAX 398-1861

DWN.BY :

CERTIFICATE OF AUTHORIZATION NO. 24GA28101600

FILE: 08-038

FIELD BOOK : BK. 49, PG. 16

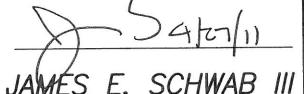

PROFESSIONAL LAND SURVEYOR NEW JERSEY LIC. 24GS03353600