

FEDERAL EMERGENCY MANAGEMENT AGENCY
NATIONAL FLOOD INSURANCE PROGRAM

ELEVATION CERTIFICATE

O.M.B. No. 3067-0077
Expires December 31, 2006

Important: Read the instructions on pages 1 - 7.

BUILDING OWNER'S NAME OF OCEAN CITY RICHARD & DEBORAH BOOTH		For Insurance Company Use:
BUILDING STREET ADDRESS (Including Apt., Unit, Suite, and/or Bldg. No.) OR P.O. ROUTE AND BOX NO. 360 E. SEABRIGHT ROAD		Policy Number
CITY OCEAN CITY		Company NAIC Number

STATE NJ	ZIP CODE 08226
--------------------	--------------------------

PROPERTY DESCRIPTION (Lot and Block Numbers, Tax Parcel Number, Legal Description, etc.)
BLOCK 70.25 LOT 21

BUILDING USE (e.g., Residential, Non-residential, Addition, Accessory, etc. Use a Comments area, if necessary.)
RESIDENTIAL

LATITUDE/LONGITUDE (OPTIONAL)
(##° - ##' - ###" or #####)

HORIZONTAL DATUM:
☐ NAD 1927 ☐ NAD 1983

SOURCE: ☐ GPS (Type): ☐ USGS Quad Map ☐ Other:

SECTION B - FLOOD INSURANCE RATE MAP (FIRM) INFORMATION

B1. NFIP COMMUNITY NAME & COMMUNITY NUMBER OCEAN CITY 345310		B2. COUNTY NAME CAPE MAY		B3. STATE NJ	
B4. MAP AND PANEL NUMBER 345310 0001	B5. SUFFIX C	B6. FIRM INDEX DATE 7-15-1992	B7. FIRM PANEL EFFECTIVE/REVISED DATE 9-5-1984	B8. FLOOD ZONE(S) A-7	B9. BASE FLOOD ELEVATION(S) (Zone AO, use depth of flooding) 9.0

B10. Indicate the source of the Base Flood Elevation (BFE) data or base flood depth entered in B9.
☐ FIS Profile ☒ FIRM ☐ Community Determined ☐ Other (Describe):

B11. Indicate the elevation datum used for the BFE in B9: **X** NGVD 1929 ☐ NAVD 1988 ☐ Other (Describe):

B12. Is the building located in a Coastal Barrier Resources System (CBRS) area or Otherwise Protected Area (OPA)? ☐ Yes ☒ No Designation Date

SECTION C - BUILDING ELEVATION INFORMATION (SURVEY REQUIRED)

C1. Building elevations are based on: ☐ Construction Drawings* ☐ Building Under Construction* ☒ Finished Construction
*A new Elevation Certificate will be required when construction of the building is complete.

C2. Building Diagram Number **8** (Select the building diagram most similar to the building for which this certificate is being completed - see pages 6 and 7. If no diagram accurately represents the building, provide a sketch or photograph.)

C3. Elevations - Zones A1-A30, AE, AH, A (with BFE), VE, V1-V30, V (with BFE), AR, AR/A, AR/AE, AR/A1-A30, AR/AH, AR/AO
Complete Items C3.-a-i below according to the building diagram specified in Item C2. State the datum used. If the datum is different from the datum used for the BFE in Section B, convert the datum to that used for the BFE. Show field measurements and datum conversion calculation. Use the space provided or the Comments area of Section D or Section G, as appropriate, to document the datum conversion.

Datum **1929** Conversion/Comments **NO CONVERSION**

Elevation reference mark used **CMCMUA** Does the elevation reference mark used appear on the FIRM? ☐ Yes ☒ No

- ☐ a) Top of bottom floor (including basement or enclosure) **10.0 ft.(m)**
☐ b) Top of next higher floor **12.5 ft.(m)**
☐ c) Bottom of lowest horizontal structural member (V zones only) **NA ft.(m)**
☐ d) Attached garage (top of slab) **NA ft.(m)**
☐ e) Lowest elevation of machinery and/or equipment servicing the building (Describe in a Comments area) **10.5 ft.(m)**
☐ f) Lowest adjacent (finished) grade (LAG) **10.0 ft.(m)**
☐ g) Highest adjacent (finished) grade (HAG) **10.6 ft.(m)**
☐ h) No. of permanent openings (flood vents) within 1 ft. above adjacent grade **3**
☐ i) Total area of all permanent openings (flood vents) in C3.h **380 sq. in. (sq. cm)**

License Number, Embossed Seal, Signature, and Date

21C#33531
6-20-06

SECTION D - SURVEYOR, ENGINEER, OR ARCHITECT CERTIFICATION

This certification is to be signed and sealed by a land surveyor, engineer, or architect authorized by law to certify elevation information.

I certify that the information in Sections A, B, and C on this certificate represents my best efforts to interpret the data available.

I understand that any false statement may be punishable by fine or imprisonment under 18 U.S. Code, Section 1001.

CERTIFIER'S NAME **GORDON M. LUDWIG, SOLE MEMBER**

LICENSE NUMBER **24GS03353100**

TITLE **LAND SURVEYOR**

COMPANY NAME **POINT TO POINT SURVEYING CO. LLC.**

ADDRESS
P.O. BOX 299

CITY
SOMERS POINT

STATE
NJ

ZIP CODE
08244

SIGNATURE

DATE
6-20-06

TELEPHONE
609-927-9295

IMPORTANT: In these spaces, copy the corresponding information from Section A.			For Insurance Company Use:
BUILDING STREET ADDRESS (including Apt. Unit, Suite, and/or Bldg. No. (OR P.O. ROUTE AND BOX NO.			Policy Number
360 E. SEABRIGHT ROAD			
CITY	STATE	ZIP CODE	Company NAIC Number
OCEAN CITY	NJ	08226	

SECTION D - SURVEYOR, ENGINEER, OR ARCHITECT CERTIFICATION (CONTINUED)

Copy both sides of this Elevation Certificate for (1) community official, (2) insurance agent/company, and (3) building owner.

COMMENTS
C3-A IS THE CRAWL SPACE (MORE OR LESS). C3-B IS THE FIRST FLOOR. C3-E IS THE AIR CONDITIONERS. HEATER ELEVATION IS 12.5 (MORE OR LESS).
CRAWL SPACE OPENINGS DO NOT HAVE GRATES.

☐ Check here if attachments

SECTION E - BUILDING ELEVATION INFORMATION (SURVEY NOT REQUIRED) FOR ZONE AO AND ZONE A (WITHOUT BFE)

For Zone AO and Zone A (without BFE), complete Items E1 through E4. If the Elevation Certificate is intended for use as supporting information for a LOMA or LOMR-F, Section C must be completed.

- E1. Building Diagram Number __ (Select the building diagram most similar to the building for which this certificate is being completed – see pages 6 and 7. If no diagram accurately represents the building, provide a sketch or photograph.)
- E2. The top of the bottom floor (including basement or enclosure) of the building is __ ft.(m) __ in.(cm) ☐ above or ☐ below (check one) the highest adjacent grade. (Use natural grade, if available).
- E3. For Building Diagrams 6-8 with openings (see page 7), the next higher floor or elevated floor (elevation b) of the building is __ ft.(m) __ in.(cm) above the highest adjacent grade. Complete items C3.h and C3.i on front of form.
- E4. The top of the platform of machinery and/or equipment servicing the building is __ ft.(m) __ in.(cm) ☐ above or ☐ below (check one) the highest adjacent grade. (Use natural grade, if available).
- E5. For Zone AO only: If no flood depth number is available, is the top of the bottom floor elevated in accordance with the community's floodplain management ordinance?
☐ Yes ☐ No ☐ Unknown. The local official must certify this information in Section G.

SECTION F - PROPERTY OWNER (OR OWNER'S REPRESENTATIVE) CERTIFICATION

The property owner or owner's authorized representative who completes Sections A, B, C (Items C3.h and C3.i only), and E for Zone A (without a FEMA-issued or community-issued BFE) or Zone AO must sign here. The statements in Sections A, B, C, and E are correct to the best of my knowledge.

PROPERTY OWNER'S OR OWNER'S AUTHORIZED REPRESENTATIVE'S NAME

ADDRESS	CITY	STATE	ZIP CODE
SIGNATURE	DATE	TELEPHONE	
COMMENTS			

☐ Check here if attachments

SECTION G - COMMUNITY INFORMATION (OPTIONAL)

The local official who is authorized by law or ordinance to administer the community's floodplain management ordinance can complete Sections A, B, C (or E), and G of this Elevation Certificate. Complete the applicable item(s) and sign below.

- G1. ☐ The information in Section C was taken from other documentation that has been signed and embossed by a licensed surveyor, engineer, or architect who is authorized by state or local law to certify elevation information. (Indicate the source and date of the elevation data in the Comments area below.)
- G2. ☐ A community official completed Section E for a building located in Zone A (without a FEMA-issued or community-issued BFE) or Zone AO.
- G3. ☐ The following information (Items G4-G9) is provided for community floodplain management purposes.

G4. PERMIT NUMBER 20651496	G5. DATE PERMIT ISSUED 7/29/05	G6. DATE CERTIFICATE OF COMPLIANCE/OCCUPANCY ISSUED 6/23/06
-------------------------------	-----------------------------------	--

G7. This permit has been issued for: ☐ New Construction ☐ Substantial Improvement

G8. Elevation of as-built lowest floor (including basement) of the building is:

____ ft.(m) Datum: ____

G9. BFE or (in Zone AO) depth of flooding at the building site is:

____ ft.(m) Datum: ____

LOCAL OFFICIAL'S NAME	TITLE
COMMUNITY NAME	TELEPHONE
SIGNATURE	DATE
COMMENTS	

CONCRETE WALK



TREES



SEABRIGHT (60' WIDE) ROAD

C.L. EL 9.8

L.S. WALLS & MECH. NOT INC. IN IMPERVIOUS COV.
FENCE BEING INSTALLED AT TIME OF FIELD WORK

C.L. EL 9.6

BLDG. TIES TO FOUNDATION

POOL TIES TO WATER EDGE

PROPERTY IS LOCATED IN FLOOD ZONE 'A--7'

POSSIBLY SUBJECT TO GENERAL NEIGHBORHOOD SCHEME
OF RESTRICTIONS OF OCEAN CITY ASSOCIATION AND/OR
OCEAN CITY IMPROVEMENT COMPANY ETC.

**SUBJECT TO EASEMENTS, RESTRICTIONS, COVENANTS
ETC. THAT A FULL REPORT OF TITLE AND SEARCH
OF THE PUBLIC RECORD MAY DISCLOSE.**

GENERAL NOTES:

TITLE SEARCH:
THIS SURVEY HAS BEEN PREPARED WITHOUT THE BENEFIT OF A TITLE SEARCH AND IS SUBJECT
TO EASEMENTS, VALIDITY OF CHAIN OF TITLE, ETC., THAT A FULL TITLE SEARCH MAY DISCLOSE.

TIDELANDS & WETLANDS: (UNLESS OTHERWISE NOTED HEREON)
NO FRESHWATER WETLANDS, RIGHTS OR INTERESTS OF THE UNITED STATES OF AMERICA OR THE STATE
OF NEW JERSEY OVER LANDS NOW OR FORMERLY FLOWED BY TIDE WATERS BUT NO LONGER VISIBLE ARE
PHYSICALLY EVIDENT OR LANDS CONTAINING OR AFFECTED BY ANY ANIMAL, MARINE OR BOTANICAL SPECIES
REGULATED, PROTECTED BY OR UNDER THE JURISDICTION OF ANY FEDERAL, STATE, OR LOCAL AGENCY HAVE
BEEN LOCATED OR DELINEATED AS PART OF THIS PROJECT.

UTILITIES:
NO ATTEMPT WAS MADE TO LOCATE THE UNDERGROUND UTILITIES WHICH MAY EXIST ON THIS PROPERTY.
PRIOR TO ANY EXCAVATION, LANDSCAPING, FENCE INSTALLATION ETC. A MARK OUT SHALL BE PERFORMED
TO DETERMINE THE EXACT LOCATION OF UTILITIES, FUEL TANKS ETC., UNDERGROUND IF ANY.

HAZARDOUS SUBSTANCE:
WE ARE NOT EXPERTS IN THE DETECTION AND IDENTIFICATION OF POTENTIALLY HAZARDOUS
SUBSTANCES, NOR DOES THIS PLAN PURPORT TO REVEAL THE PRESENCE OF SUCH SUBSTANCES.

BUILDING OFFSETS:
ALL BUILDING OFFSETS ARE TO THE FACE OF SIDING UNLESS OTHERWISE NOTED, AND ARE NOT
TO BE USED FOR DESIGN PURPOSES, PROPERTY LINE DETERMINATION, FENCE INSTALLATION, ETC.

PLOT PLAN NOT TO BE USED FOR CONVEYANCE

TOTAL BLDG. COV. 3,150± S.F.

35± OF LOT (INC. GARAGE)

HALF STORY S.F. 745±S.F.

38.2% OF 2ND FLOOR±

BLOCK AND LOT NUMBERS REFER TO THE CURRENT
TAX MAP OF THE CITY OF OCEAN CITY.

ISSUED TO:

1- RICHARD L. & DEBORAH M. BOOTH

IN CONSIDERATION OF A FEE PAID

I DECLARE THAT TO THE BEST OF MY PROFESSIONAL KNOWLEDGE, INFORMATION,
AND BELIEF, THIS MAP OR PLAN IS A RESULT OF A FIELD SURVEY MADE BY ME
OR UNDER MY DIRECT SUPERVISION, IN ACCORDANCE WITH THE RULES AND
AND REGULATIONS OF THE "STATE BOARD OF PROFESSIONAL ENGINEERS AND LAND
SURVEYORS, N.J.A.C. 13:40-5.1 LAND SURVEYORS, PREPARATION OF LAND SURVEYS."
THE INFORMATION SHOWN HEREON CORRECTLY REPRESENTS THE CONDITIONS FOUND
AS OF THE DATE OF THE FIELD SURVEY, EXCEPT SUCH IMPROVEMENTS OR EASEMENTS
"OF RECORD" IF ANY BELOW THE SURFACE AND NOT VISIBLE.
THIS DECLARATION IS GIVEN SOLELY TO THE ABOVE NAMED PARTIES FOR THIS
TRANSACTION ONLY AND IS NOT TRANSFERABLE EXCEPT AS FOLLOWS:
A. TO THE TITLE INSURER SO IT MAY INSURE TITLE TO THE PREMISES SHOWN HEREON.
B. TO THE MORTGAGE HOLDER THE DECLARATION SHALL SURVIVE TO ITS SUCCESSOR(S)
AND/OR ASSIGN(S).

CAUTION: IF THIS DOCUMENT DOES NOT CONTAIN THE RAISED
IMPRESSION SEAL OF THE PROFESSIONAL WHOSE NAME
APPEARS HEREON, IT IS NOT AN AUTHORIZED ORIGINAL
DOCUMENT AND MAY HAVE BEEN ALTERED.

FINAL CONST, PLAN

BLOCK 70.25 LOT 21

CITY OF OCEAN CITY

CAPE MAY COUNTY NJ

DATE: JUNE 2006


DRAWN BY: G.M.L.

SCALE: 1" = 15'


CALC'D BY: G.M.L.

PROJ. NO.: 04-0316 FINAL

CHK'D BY: G.M.L.

 **POINT TO POINT SURVEYING CO., L.L.C.**
P.O. BOX 299 SOMERS POINT, NJ 08244
609-927-9295 FAX 609-653-8404
CERT. OF AUTH. # 24GA28059900

GORDON M. LUDWIG
LICENSED LAND SURVEYOR
NJ LICENSE # 24GS03353100

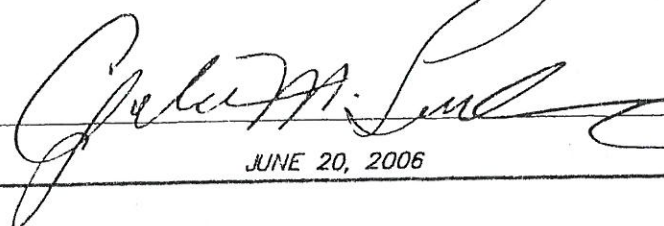

SOLE MEMBER

JUNE 20, 2006

