

ELEVATION CERTIFICATE

Important: Read the instructions on pages 1-9.

09-040

SECTION A - PROPERTY INFORMATION

A1. Building Owner's Name JEFF FROST, BUILDER	For Insurance Company Use: Policy Number
A2. Building Street Address (including Apt., Unit, Suite, and/or Bldg. No.) or P.O. Route and Box No. 364 EAST SURF ROAD	Company NAIC Number

A3. Property Description (Lot and Block Numbers, Tax Parcel Number, Legal Description, etc.)
LOT 24 BLOCK 70.26

A4. Building Use (e.g., Residential, Non-Residential, Addition, Accessory, etc.) RESIDENTIAL

A5. Latitude/Longitude: Lat. N 39° 17' 21.82" Long. W 74° 33' 19.15" Horizontal Datum: NAD 1927 NAD 1983

A6. Attach at least 2 photographs of the building if the Certificate is being used to obtain flood insurance.

A7. Building Diagram Number 8

A8. For a building with a crawlspace or enclosure(s):

a) Square footage of crawlspace or enclosure(s)	<u>1963</u> sq ft
b) No. of permanent flood openings in the crawlspace or enclosure(s) within 1.0 foot above adjacent grade	<u>10</u>
c) Total net area of flood openings in A8.b	<u>2,000</u> sq in
d) Engineered flood openings?	<input checked="" type="checkbox"/> Yes <input type="checkbox"/> No

A9. For a building with an attached garage:

a) Square footage of attached garage	<u>NA</u> sq ft
b) No. of permanent flood openings in the attached garage within 1.0 foot above adjacent grade	<u> </u>
c) Total net area of flood openings in A9.b	<u> </u> sq in
d) Engineered flood openings?	<input type="checkbox"/> Yes <input type="checkbox"/> No

SECTION B - FLOOD INSURANCE RATE MAP (FIRM) INFORMATION

B1. NFIP Community Name & Community Number OCEAN CITY 345310		B2. County Name CAPE MAY		B3. State NJ	
B4. Map/Panel Number 345310-0001	B5. Suffix C	B6. FIRM Index Date 7-15-92	B7. FIRM Panel Effective/Revised Date 9-5-84	B8. Flood Zone(s) A-7	B9. Base Flood Elevation(s) (Zone AO, use base flood depth) 10 FT

B10. Indicate the source of the Base Flood Elevation (BFE) data or base flood depth entered in Item B9.
 FIS Profile FIRM Community Determined Other (Describe) _____

B11. Indicate elevation datum used for BFE in Item B9: NGVD 1929 NAVD 1988 Other (Describe) _____

B12. Is the building located in a Coastal Barrier Resources System (CBRS) area or Otherwise Protected Area (OPA)? Yes No
Designation Date _____ CBRS OPA

SECTION C - BUILDING ELEVATION INFORMATION (SURVEY REQUIRED)

C1. Building elevations are based on: Construction Drawings* Building Under Construction* Finished Construction
*A new Elevation Certificate will be required when construction of the building is complete.

C2. Elevations – Zones A1-A30, AE, AH, A (with BFE), VE, V1-V30, V (with BFE), AR, AR/A, AR/AE, AR/A1-A30, AR/AH, AR/AO. Complete Items C2.a-h below according to the building diagram specified in Item A7. Use the same datum as the BFE.
Benchmark Utilized PRVT Vertical Datum 1929
Conversion/Comments NONE


Check the measurement used.


a) Top of bottom floor (including basement, crawlspace, or enclosure floor)	<u>9.6</u>	<input checked="" type="checkbox"/> feet <input type="checkbox"/> meters (Puerto Rico only)
b) Top of the next higher floor	<u>13.0</u>	<input checked="" type="checkbox"/> feet <input type="checkbox"/> meters (Puerto Rico only)
c) Bottom of the lowest horizontal structural member (V Zones only)	<u>NA</u>	<input checked="" type="checkbox"/> feet <input type="checkbox"/> meters (Puerto Rico only)
d) Attached garage (top of slab)	<u>NA</u>	<input checked="" type="checkbox"/> feet <input type="checkbox"/> meters (Puerto Rico only)
e) Lowest elevation of machinery or equipment servicing the building (Describe type of equipment and location in Comments)	<u>11.2</u>	<input checked="" type="checkbox"/> feet <input type="checkbox"/> meters (Puerto Rico only)
f) Lowest adjacent (finished) grade next to building (LAG)	<u>9.5</u>	<input checked="" type="checkbox"/> feet <input type="checkbox"/> meters (Puerto Rico only)
g) Highest adjacent (finished) grade next to building (HAG)	<u>10.5</u>	<input checked="" type="checkbox"/> feet <input type="checkbox"/> meters (Puerto Rico only)
h) Lowest adjacent grade at lowest elevation of deck or stairs, including structural support	<u>9.5</u>	<input checked="" type="checkbox"/> feet <input type="checkbox"/> meters (Puerto Rico only)

SECTION D - SURVEYOR, ENGINEER, OR ARCHITECT CERTIFICATION

This certification is to be signed and sealed by a land surveyor, engineer, or architect authorized by law to certify elevation information. I certify that the information on this Certificate represents my best efforts to interpret the data available. I understand that any false statement may be punishable by fine or imprisonment under 18 U.S. Code, Section 1001.

Check here if comments are provided on back of form. Were latitude and longitude in Section A provided by a licensed land surveyor? Yes No

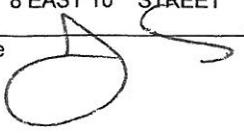Certifier's Name JAMES E. SCHWAB III	License Number 24GS03353600
Title LAND SURVEYOR	Company Name SCHWAB LAND SURVEYING AND PLANNING, LLC
Address 8 EAST 10 TH STREET	City OCEAN CITY State NJ ZIP Code 08226
Signature 	Date <u>10/1/10</u> Telephone 609-398-0565

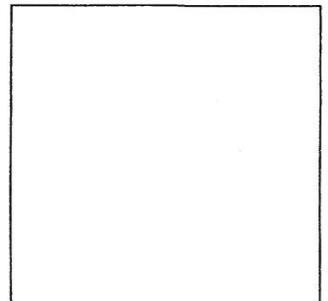


IMPORTANT: In these spaces, copy the corresponding information from Section A.	For Insurance Company Use:
Building Street Address (including Apt., Unit, Suite, and/or Bldg. No.) or P.O. Route and Box No. 364 EAST SURF ROAD	Policy Number
City OCEAN CITY State NJ ZIP Code 08226	Company NAIC Number

SECTION D - SURVEYOR, ENGINEER, OR ARCHITECT CERTIFICATION (CONTINUED)

Copy both sides of this Elevation Certificate for (1) community official, (2) insurance agent/company, and (3) building owner.

Comments C2A IS CRAWLSPACE AND FORMER GARAGE NOW DIVIDED INTO SEPARATE UTILITY AND STORE ROOM (STORE ROOM HAS OVERHEAD DOOR). C2B IS FIRST FLOOR. C2E IS AC CONDENSOR PLATFORM. ALL VENTS ARE SMART VENT MODEL 1540-510 RATED BY THE MANUFACTURER AS EQUIVALENT TO 200 SQ.IN.NET FREE AREA EACH (SEE ATTACHED). DATE OF FIELD SURVEY 7-1-10.

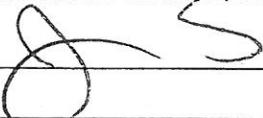Signature  Date 10/1/10 Check here if attachments

SECTION E - BUILDING ELEVATION INFORMATION (SURVEY NOT REQUIRED) FOR ZONE AO AND ZONE A (WITHOUT BFE)

For Zones AO and A (without BFE), complete Items E1-E5. If the Certificate is intended to support a LOMA or LOMR-F request, complete Sections A, B, and C. For Items E1-E4, use natural grade, if available. Check the measurement used. In Puerto Rico only, enter meters.

- E1. Provide elevation information for the following and check the appropriate boxes to show whether the elevation is above or below the highest adjacent grade (HAG) and the lowest adjacent grade (LAG).
 - a) Top of bottom floor (including basement, crawlspace, or enclosure) is _____ feet meters above or below the HAG.
 - b) Top of bottom floor (including basement, crawlspace, or enclosure) is _____ feet meters above or below the LAG.
- E2. For Building Diagrams 6-9 with permanent flood openings provided in Section A Items 8 and/or 9 (see pages 8-9 of Instructions), the next higher floor (elevation C2.b in the diagrams) of the building is _____ feet meters above or below the HAG.
- E3. Attached garage (top of slab) is _____ feet meters above or below the HAG.
- E4. Top of platform of machinery and/or equipment servicing the building is _____ feet meters above or below the HAG.
- E5. Zone AO only: If no flood depth number is available, is the top of the bottom floor elevated in accordance with the community's floodplain management ordinance? Yes No Unknown. The local official must certify this information in Section G.

SECTION F - PROPERTY OWNER (OR OWNER'S REPRESENTATIVE) CERTIFICATION

The property owner or owner's authorized representative who completes Sections A, B, and E for Zone A (without a FEMA-issued or community-issued BFE) or Zone AO must sign here. *The statements in Sections A, B, and E are correct to the best of my knowledge.*

Property Owner's or Owner's Authorized Representative's Name _____

Address _____	City _____	State _____	ZIP Code _____
Signature _____	Date _____	Telephone _____	
Comments _____			

Check here if attachments

SECTION G - COMMUNITY INFORMATION (OPTIONAL)

The local official who is authorized by law or ordinance to administer the community's floodplain management ordinance can complete Sections A, B, C (or E), and G of this Elevation Certificate. Complete the applicable item(s) and sign below. Check the measurement used in Items G8 and G9.

- G1. The information in Section C was taken from other documentation that has been signed and sealed by a licensed surveyor, engineer, or architect who is authorized by law to certify elevation information. (Indicate the source and date of the elevation data in the Comments area below.)
- G2. A community official completed Section E for a building located in Zone A (without a FEMA-issued or community-issued BFE) or Zone AO.
- G3. The following information (Items G4-G9) is provided for community floodplain management purposes.

G4. Permit Number 20081589	G5. Date Permit Issued 12/29/08	G6. Date Certificate Of Compliance/Occupancy Issued 7/28/11
-------------------------------	------------------------------------	--


- G7. This permit has been issued for: New Construction Substantial Improvement
- G8. Elevation of as-built lowest floor (including basement) of the building: _____ feet meters (PR) Datum _____
- G9. BFE or (in Zone AO) depth of flooding at the building site: _____ feet meters (PR) Datum _____
- G10. Community's design flood elevation _____ feet meters (PR) Datum _____

Local Official's Name _____	Title _____
Community Name _____	Telephone _____
Signature _____	Date _____
Comments _____	

+X.X = NGVD 1929 ELEVATION

AVERAGE FRONT ALIGNMENT

LOT NO.	SETBACK	MEASURED TO
26	29.3'	PORCH
25	30.1'	DWELLING
24 (PIQ)	12.1'	ENC. PORCH
23	14.6'	PORCH
22	11.9'	PORCH
<hr/>		
AVERAGE	19.6'	

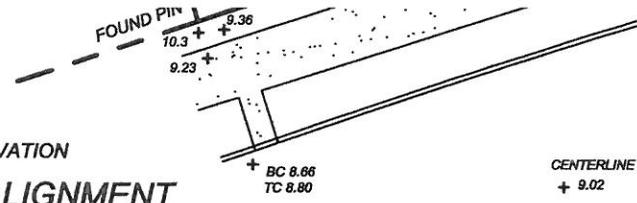

SURF ROAD
(60' WIDE)

COVERAGE AND HEIGHT

LOT AREA- 7,236 SQ.FT.
 BUILDING AREA- 2,185 SQ.FT., 30.2%
 TOP FLOOR AREA- 460 SQ.FT., 29.2%
 OF 2ND FLOOR AREA
 IMPERVIOUS AREA- 4,340 SQ.FT., 60%
 PEAK ELEVATION- 40.6 FT.
 CENTERLINE ELEVATION- 9.02 FT.
 BUILDING HEIGHT- 31.6 FT.

REVISED 7-14-11, RECONFIGURED PAVERS
 REVISED 11-19-10- RECONFIGURED PAVERS
 REVISED 7/01/10- FINAL CONDITIONS
 REVISED 8/13/09- UNDER CONSTRUCTION CONDITIONS
 REVISED 2/9/09 - ADDED AVERAGE FRONT ALIGNMENT

SURVEY OF EXISTING IMPROVEMENTS

~~~NOT FOR CONVEYANCE~~~

**LOT 24 BLOCK 70.26  
CITY OF OCEAN CITY  
CAPE MAY COUNTY, NJ**

DATE : OCT. 4, 2006 SCALE : 1"= 20' DWN.BY : JES

**SCHWAB LAND SURVEYING  
AND PLANNING, LLC**

8 EAST 10TH STREET  
OCEAN CITY, NJ 08226

TELE 609-398-0565 FAX 398-1861


CERTIFICATE OF AUTHORIZATION NO. 24GA28101600

FILE : 09040 FIELD BOOK : 42,PG.45

THIS SURVEY IS FOR USE IN APPLYING FOR MUNICIPAL APPROVAL OF NEW CONSTRUCTION. THE SURVEYOR WILL ACCEPT NO RESPONSIBILITY FOR ITS USE FOR ANY OTHER PURPOSE.

  
**JAMES E. SCHWAB III**  
 PROFESSIONAL LAND SURVEYOR  
 NEW JERSEY LICENSE NO. 33,536

ISSUED TO:  
JEFF FROST, BUILDER

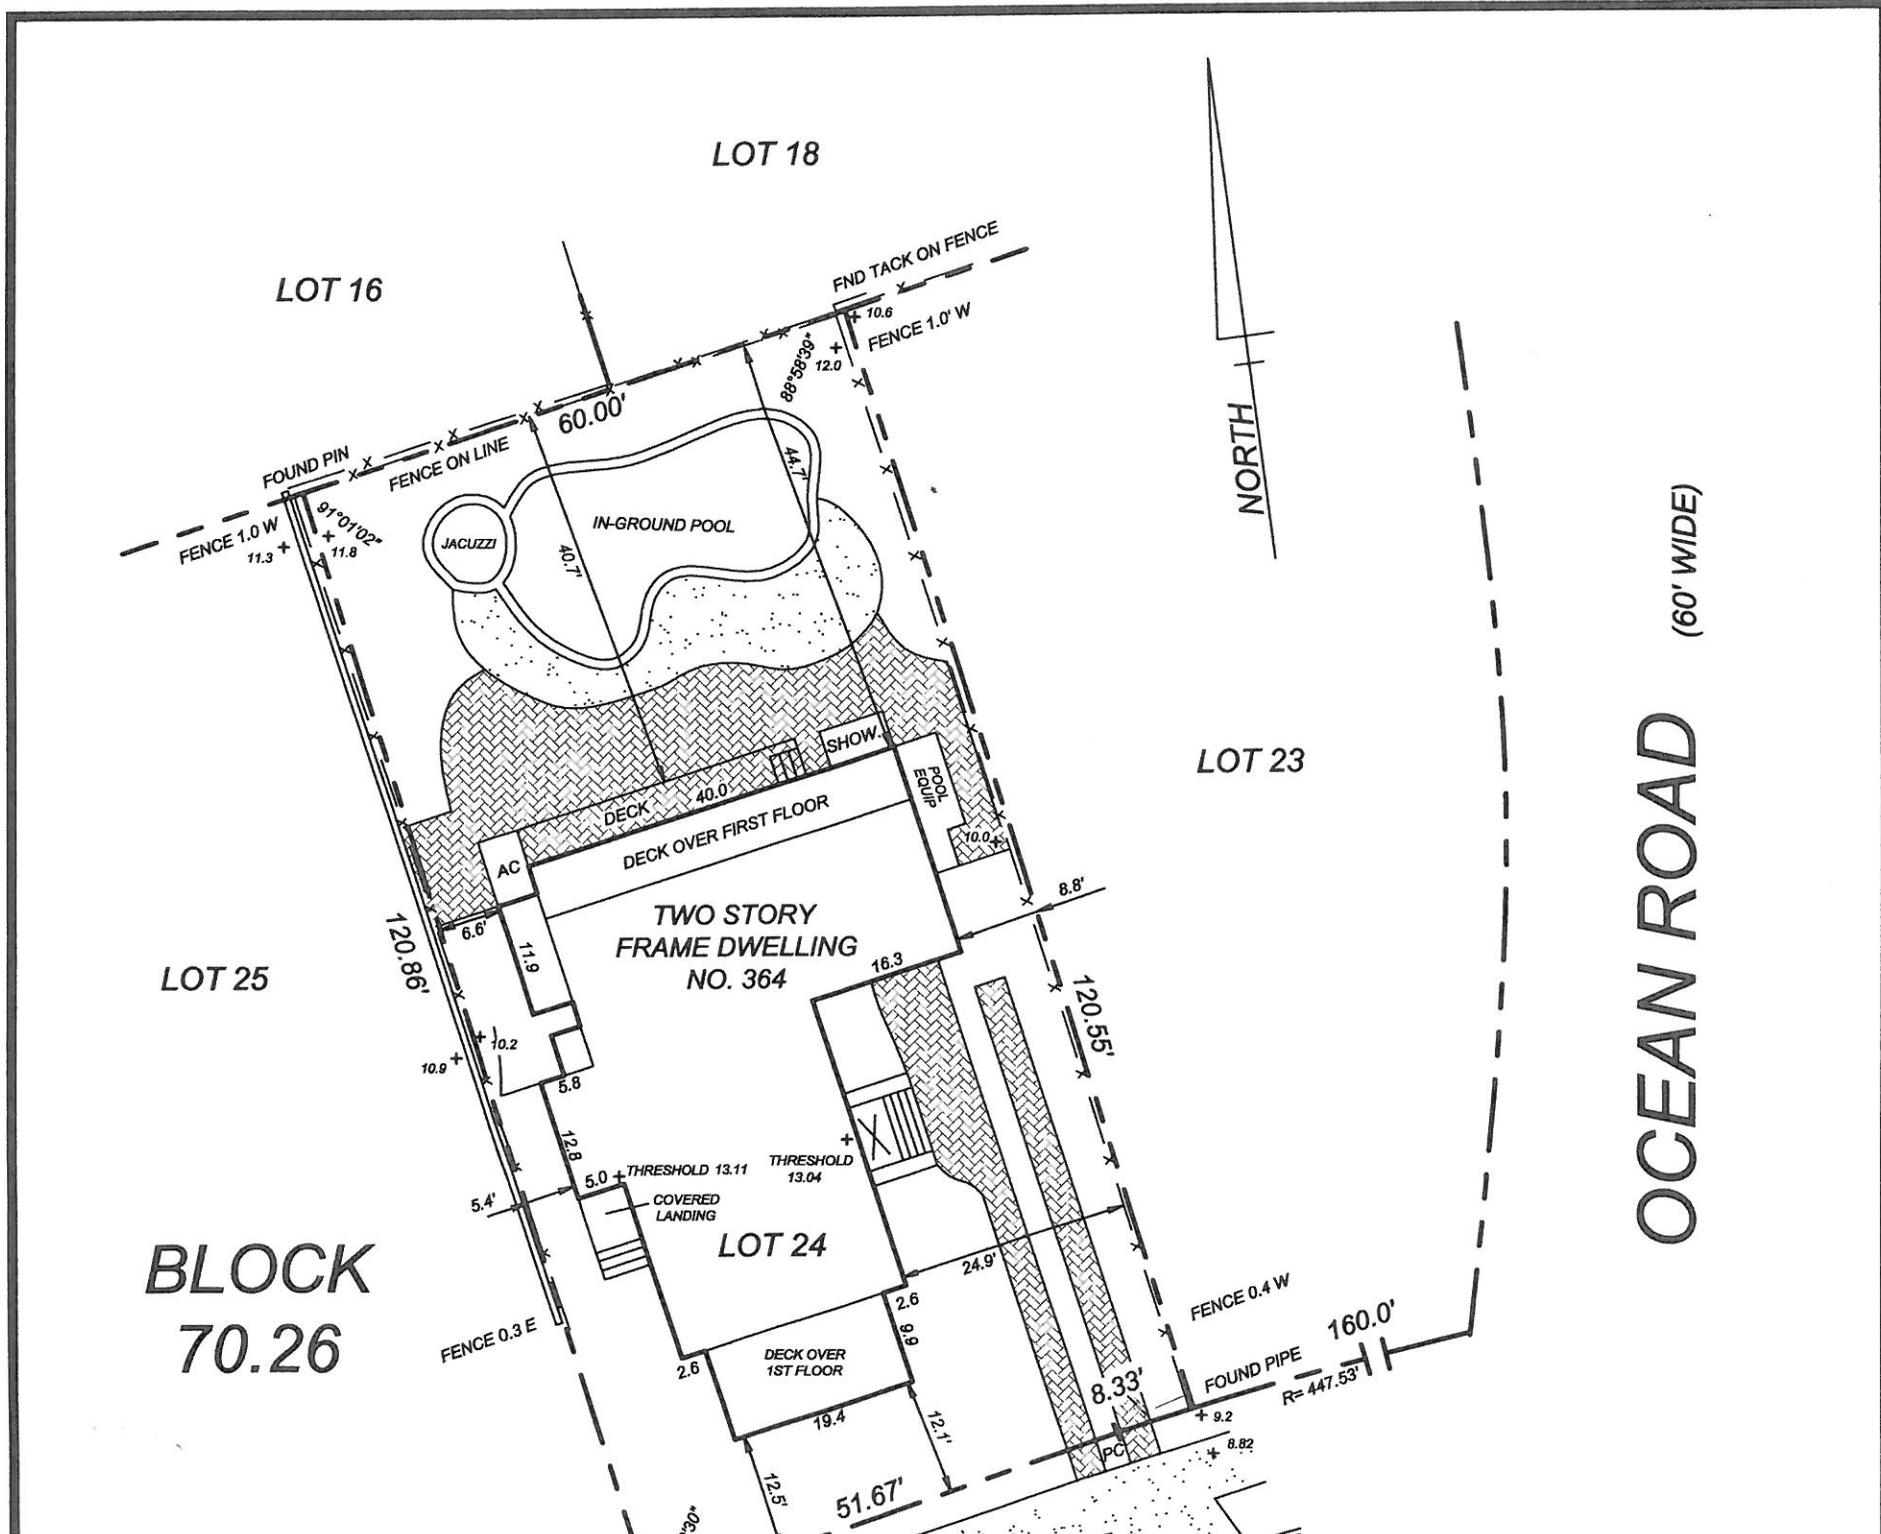

LOT 18

LOT 16

NORTH

LOT 23

LOT 25

TWO STORY  
FRAME DWELLING  
NO. 364

LOT 24

BLOCK  
70.26

OCEAN ROAD  
(60' WIDE)