U.S. DEP. RTIMENT OF HOMELAND SECURITY Federal Emergency Management Agency

Signature

ELEVATION CERTIFICATE

Important: Read the instructions on pages 1-9.


OMB No. 1660-0008 Expires March 31, 2012

National Flood Insurance Program SECTION A - PROPERTY INFORMATION A1. Building Owner's Name RALPH J. MELFI A2. Building Street Address (including Apt., Unit, Suite, and/or Bidg. No.) or P.O. Route and Box No. 158-160 OCEAN ROAD City OCEAN CITY State NJ ZIP Code 08226 A3. Property Description (Lot and Block Numbers, Tax Parcel Number, Legal Description, etc.) A4. Building Use (e.g., Residential, Non-Residential, Addition, Accessory, etc.) RESIDENTIAL A5. Latitude/Longitude: Lat. 39-17'-34" N Long. 74-33'-38" W Horizontal Datum: NAD 1927 NAD 1983 A6. Attach at least 2 photographs of the building if the Certificate is being used to obtain flood insurance. A7. Building Diagram Number 8 A8. For a building with a crawlspace or enclosure(s): A9. For a building with an attached garage: a) Square footage of crawlapace or enclosure(s) a) Square footage of attached garage 910 sq ft NA sq ft b) No. of permanent flood openings in the crawlspace or No. of permanent flood openings in the attached garage enclosure(s) within 1.0 foot above adjacent grade within 1.0 foot above adjacent grade N/A Total net area of flood openings in A8.b 1024 Total net area of flood openings in A9.b sq in N/A sq in d) Engineered flood openings? d) Engineered flood openings? ☐ Yes No No SECTION B - FLOOD INSURANCE RATE MAP (FIRM) INFORMATION B1. NFIP Community Name & Community Number **B2. County Name** B3. State 3453100001 C CAPE MAY B4. Map/Panel Number B5. Suffix B6. FIRM Index **B7. FIRM Panel** B8. Flood B9. Base Flood Elevation(s) (Zone 345310-0001 Date Effective/Revised Date Zone(s) AO, use base flood depth) 7/15/92 9/5/84 B10. Indicate the source of the Base Flood Elevation (BFE) data or base flood depth entered in Item B9. ☑ FIRM ☐ Community Determined Other (Describe) B11. Indicate elevation datum used for BFE in Item B9: ☒ NGVD 1929 ■ NAVD 1988 Other (Describe) B12. Is the building located in a Coastal Barrier Resources System (CBRS) area or Otherwise Protected Area (OPA)? ⊠ No ☐ Yes Designation Date ☐ CBRS ☐ OPA SECTION C - BUILDING ELEVATION INFORMATION (SURVEY REQUIRED) Building elevations are based on: ☐ Construction Drawings* ☐ Building Under Construction* A new Elevation Certificate will be required when construction of the building is complete. Elevations – Zones A1-A30, AE, AH, A (with BFE), VE, V1-V30, V (with BFE), AR, AR/A, AR/AE, AR/A1-A30, AR/AH, AR/AO. Complete Items C2.a-h below according to the building diagram specified in Item A7. Use the same datum as the BFE. Benchmark Utilized LOCALVertical Datum 1929 Conversion/Comments N/A Check the measurement used. Top of bottom floor (including basement, crawlspace, or enclosure floor) 11.3 a) ☑ feet ☐ meters (Puerto Rico only) b) Top of the next higher floor 15.6 Bottom of the lowest horizontal structural member (V Zones only) C) ☐ feet ☐ meters (Puerto Rico only) N/A d) Attached garage (top of slab) N/A. ☑ feet ☐ meters (Puerto Rico only) e) Lowest elevation of machinery or equipment servicing the building 11.5 (Describe type of equipment and location in Comments) n Lowest adjacent (finished) grade next to building (LAG) 11.2 ☐ feet ☐ meters (Puerto Rico only) Highest adjacent (finished) grade next to building (HAG) 11.3 ☑ feet ☐ meters (Puerto Rico only) Lowest adjacent grade at lowest elevation of deck or stairs, including h) 11.2 ☑ feet ☐ meters (Puerto Rico only) structural support SECTION D - SURVEYOR, ENGINEER, OR ARCHITECT CERTIFICATION This certification is to be signed and sealed by a land surveyor, engineer, or architect authorized by law to certify elevation information. I certify that the information on this Certificate represents my best efforts to interpret the data available. understand that any false statement may be punishable by fine or imprisonment under 18 U.S. Code, Section 1001.□ Check here if comments are provided on back of form. Were latitude and longitude in Section A provided by a licensed land surveyor? PLACE ☑ Yes ☐ No 95A. Certifier's Name THOMAS N. TOLBERT License Number 38608 HERE Title PRESIDENT Company Name DESIGN LAND SURVEYING, P.A. Address P.O. BOX 667 City TURNERSVILLE State NJ ZIP Code 08012

Date 10/26/11

Telephone 856-374-1134

IMPORTANT: In these spaces	, copy the corresponding	information from Section A		CONTROL CONTRACTOR
Building Street Address (including A 158-160 OCEAN ROAD) or P.O. Route and Box No.		Rails Number
City OCEAN CITYState NJ ZIP C	ode 08226	v Zijor zajbrili		Controlly NAC Sturber
SECTIO	N D - SURVEYOR, ENGIN	EER, OR ARCHITECT CER	TIFICATION (CON	TINUED)
Copy both sides of this Elevation Ce				
Comments				
		¥		
Signature		Date		
SECTION E - BUILDING EL	EVATION INFORMATION (SURVEY NOT REQUIRED)	FOR ZONE AO AI	☐ Check here if attachm ND ZONE A (WITHOUT BFE)
For Zones AO and A (without BFE), and C. For Items E1-E4, use natura E1. Provide elevation information fi grade (HAG) and the lowest ac	complete Items E1-E5. If the C I grade, if available. Check the or the following and check the a liacent grade (LAG).	ertificate is intended to support a measurement used. In Puerto F ppropriate boxes to show wheth	LOMA or LOMR-F	request, complete Sections A, B,
a) Top of bottom floor (including b) Top of bottom floor (including E2. For Building Diagrams 6-9 with (elevation C2.b in the diagrams E3. Attached garage (top of slab) is	g basement, crawlspace, or end g basement, crawlspace, or end permanent flood openings prov o) of the building is	rided in Section A Items 8 and/or	eet meters a 9 (see pages 8-9 of ve or below the I	HAG.
E4. Top of platform of machinery at E5. Zone AO only: If no flood depth ordinance? Yes No	nd/or equipment servicing the but number is available is the too	uilding is feet	☐ meters ☐ abov	e or Delow the HAG.
ordinance? Yes No	Unknown. The local official	must certify this information in S	ection G.	ommunity's floodplain manageme
	N F - PROPERTY OWNER			CATION
The state of the s	ized representative who completements in Sections A, B, and E	etes Sections A B and E for Zon	o A fuithant - FERR	A-issued or community-issued BF
Property Owner's or Owner's Authoriz	ized representative who completements in Sections A, B, and E	etes Sections A B and E for Zon	o A fuithant - FERR	A-issued or community-issued BF
Property Owner's or Owner's Authoriz	ized representative who completements in Sections A, B, and E	etes Sections A, B, and E for Zoi are correct to the best of my kno	ne A (without a FEM/ owledge.	A-issued or community-issued BF ZIP Code
The property owner or owner's author Zone AO must sign here. The state Property Owner's or Owner's Authorize Address Signature Comments	ized representative who completements in Sections A, B, and E	etes Sections A, B, and E for Zoi are correct to the best of my kno City	ne A (without a FEM/ wiledge. State	A-issued or community-issued BF ZIP Code
Property Owner's or Owner's Authorized Address	ized representative who comple ements in Sections A, B, and E red Representative's Name	etes Sections A, B, and E for Zoi are correct to the best of my kno City Date	ne A (without a FEM/ owledge. State Telephone	A-issued or community-issued BF ZIP Code
Property Owner's or Owner's Authorized Address Signature Comments	ized representative who completements in Sections A, B, and E and Representative's Name	etes Sections A, B, and E for Zoi are correct to the best of my kno City Date	State Telephone	A-issued or community-issued BF ZIP Code Check here if attachm
Property Owner's or Owner's Authorized by lad G of this Elevation Certificate. Com	ized representative who completements in Sections A, B, and E and Representative's Name SECTION G - COMM w or ordinance to administer the applicable item(s) and	etes Sections A, B, and E for Zoi are correct to the best of my kno City Date #UNITY INFORMATION (OF e community's floodplain manage of sign below. Check the measure	State Telephone TIONAL) ement used in lease	ZiP Code Check here if attachm
Property Owner's or Owner's Authorized Address Signature Comments e local official who is authorized by lad G of this Elevation Certificate. Comments The information in Section C is authorized by law to certify	sections A, B, and E and Representative's Name SECTION G - COMM w or ordinance to administer the oplete the applicable item(s) and was taken from other document elevation information. (Indicate	city Date MUNITY INFORMATION (OF e community's floodplain managed sign below. Check the measuration that has been signed and sthe source and date of the elevities.	State Telephone TIONAL) ement ordinance carement used in Items tealed by a licensed attention data in the Contact of the Co	ZIP Code Check here if attachm Complete Sections A, B, C (or E GB and G9. Surveyor, engineer, or architect w
Property Owner's or Owner's Authorized Address Signature Comments e local official who is authorized by lad G of this Elevation Certificate. Comments The information in Section Comments is authorized by law to certify A community official complete The following information (Iter	SECTION G - COMM were ordinance to administer the applicable item(s) and satisfaction information. (Indicate d Section E for a building locate ins G4-G9) is provided for comments.	etes Sections A, B, and E for Zoi are correct to the best of my knot City Date MUNITY INFORMATION (OF e community's floodplain managed sign below. Check the measurement of the community's floodplain managed sign below.	State Telephone TIONAL) ement ordinance carement used in Items ealed by a licensed state of community.	ZIP Code Check here if attachm Complete Sections A, B, C (or E GB and G9. Surveyor, engineer, or architect w
Property Owner's or Owner's Authorized Address Signature Comments e local official who is authorized by lad G of this Elevation Certificate. Comis authorized by law to certify A community official complete The following information (Iter	SECTION G - COMN w or ordinance to administer the applicable item(s) and was taken from other documents delevation information. (Indicate d Section E for a building located	city Date MUNITY INFORMATION (OF e community's floodplain managed is ign below. Check the measure atton that has been signed and stressource and date of the elevited in Zone A (without a FEMA-is munity floodplain management property of the source and property floodplain management property of the source and community floodplain management property floodplain manag	State Telephone TIONAL) ement ordinance carement used in Items ealed by a licensed ation data in the Corresued or community-is imposes.	ZIP Code Check here if attachm Complete Sections A, B, C (or E GB and G9. Surveyor, engineer, or architect w
Property Owner's or Owner's Authorized Address Signature Comments e local official who is authorized by lad G of this Elevation Certificate. Comis authorized by law to certify A community official complete The following information (Iter	SECTION G - COMIN we or ordinance to administer the applicable item(s) and elevation information. (Indicate d Section E for a building locate ins G4-G9) is provided for communication. (S. Date Permit Issued Section E for a building locate ins G4-G9) is provided for communication.	City Date MUNITY INFORMATION (OF e community's floodplain managed in Source and date of the elevited in Zone A (without a FEMA-ismunity floodplain management put G6. Date C	State Telephone TIONAL) ement ordinance carement used in Items ealed by a licensed ation data in the Corresued or community-is imposes.	ZiP Code Check here if attachm Complete Sections A, B, C (or E, G8 and G9. Surveyor, engineer, or architect warments area below.) ssued BFE) or Zone AO.
Property Owner's or Owner's Authorized Address Signature Comments e local official who is authorized by lad G of this Elevation Certificate. Comis authorized by law to certify A community official complete The following information (Iter	SECTION G - COMM were ordinance to administer the oplete the applicable item(s) and was taken from other document elevation information. (Indicate d Section E for a building locate on G4-G9) is provided for comm G5. Date Permit Issued New Construction cluding basement) of the building located of the construction of the building basement) of the building located of the construction of the construct	City Date MUNITY INFORMATION (OF e community's floodplain managed sign below. Check the measure atton that has been signed and sthe source and date of the elevited in Zone A (without a FEMA-ismunity floodplain management put G6. Date C	State Telephone TIONAL) ement ordinance carement used in Items ealed by a licensed ation data in the Corresued or community-is imposes.	ZiP Code Check here if attachm Complete Sections A, B, C (or E) GB and G9. Surveyor, engineer, or architect warments area below.) Issued BFE) or Zone AO. Ince/Occupancy Issued
Property Owner's or Owner's Authorized Address Signature Comments e local official who is authorized by lad G of this Elevation Certificate. Comis authorized by law to certify A community official complete The following information (Iter	SECTION G - COMM SECTION G - COMM We or ordinance to administer the oplete the applicable item(s) and several and several control of the building located and GA-G9) is provided for commod of the building located and GA-G9). We construction cluding basement) of the building at the building site:	City Date MUNITY INFORMATION (OF e community's floodplain managed sign below. Check the measure attent that has been signed and sign below. Check the measure attent that has been signed and sign below. Check the measure attent that has been signed and sign below. Check the measure attent that has been signed and sign below. Check the measure attent that has been signed and sign below. Check the measure attention that has been signed and sign below. Check the measure attention that has been signed and sign below. Check the measure attention that has been signed and sign below. Check the measure attention that has been signed and sign below. Check the measure attention that has been signed and sign below. Check the measure attention that has been signed and that has been sign below that has been	State Telephone TIONAL) ement ordinance carement used in Items attached by a licensed attached attached attached attached attached attached attached by a licensed by a	ZiP Code Check here if attachm Complete Sections A, B, C (or E) G8 and G9. surveyor, engineer, or architect warments area below.) ssued BFE) or Zone AO. Ince/Occupancy Issued
Property Owner's or Owner's Authorized Address Gignature Comments e local official who is authorized by lad G of this Elevation Certificate. Comments The information in Section Comments is authorized by law to certify A community official complete The following information (Iter Permit Number This permit has been issued for: Elevation of as-built lowest floor (in BFE or (in Zone AO) depth of flood of Community's design flood elevation	SECTION G - COMM SECTION G - COMM We or ordinance to administer the oplete the applicable item(s) and several and several control of the building located and GA-G9) is provided for commod of the building located and GA-G9). We construction cluding basement) of the building at the building site:	City Date MUNITY INFORMATION (OF e community's floodplain managed sign below. Check the measure attention that has been signed and sign below. Check the measure attention that has been signed and sign below. Check the measure attention that has been signed and sign below. Check the measure attention that has been signed and sign below. Check the measure attention that has been signed and sign below. Check the measure attention that has been signed and sign below. Check the measure attention in the sign below. The sign below in the sign below in the sign below. The sign below in the sign below in the sign below in the sign below. The sign below in the sign below	State Telephone TIONAL) ement ordinance carement used in Items attended by a licensed attended or community-is imposes. ertificate Of Complia	ZiP Code Check here if attachm Complete Sections A, B, C (or E) G8 and G9. surveyor, engineer, or architect warments area below.) ssued BFE) or Zone AO. Ince/Occupancy Issued
Property Owner's or Owner's Authorized Address Gignature Comments d G of this Elevation Certificate. Comments The information in Section Comments authorized by law to certify A community official complete The following information (Iter Permit Number This permit has been issued for: Elevation of as-built lowest floor (in BFE or (in Zone AO) depth of flood	SECTION G - COMM SECTION G - COMM We or ordinance to administer the oplete the applicable item(s) and several and several control of the building located and GA-G9) is provided for commod of the building located and GA-G9). We construction cluding basement) of the building at the building site:	City Date MUNITY INFORMATION (OF e community's floodplain managed sign below. Check the measure attion that has been signed and sign the source and date of the elevited in Zone A (without a FEMA-ismunity floodplain management put G6. Date C G Substantial Improvement G Get G n Get G n Get G n Get G n G feet G n G n G n G n G n G n G n G n G n G	State Telephone TIONAL) ement ordinance carement used in Items attached by a licensed attached attached attached attached attached attached attached by a licensed by a	ZiP Code Check here if attachm Complete Sections A, B, C (or E) G8 and G9. surveyor, engineer, or architect warments area below.) ssued BFE) or Zone AO. Ince/Occupancy Issued
Property Owner's or Owner's Authorized Address Signature Comments e local official who is authorized by lad G of this Elevation Certificate. Comis authorized by law to certify A community official complete The following information (Iter Permit Number This permit has been issued for: Elevation of as-built lowest floor (in BFE or (in Zone AO) depth of flood of Community's design flood elevation of all Official's Name	SECTION G - COMM SECTION G - COMM We or ordinance to administer the oplete the applicable item(s) and several and several control of the building located and GA-G9) is provided for commod of the building located and GA-G9). We construction cluding basement) of the building at the building site:	City Date MUNITY INFORMATION (OP e community's floodplain manag d sign below. Check the measur ation that has been signed and s the source and date of the elevi- ed in Zone A (without a FEMA-is- munity floodplain management pu G6. Date C Substantial Improvement ng: feet n feet n feet n Title Telephone	State Telephone TIONAL) ement ordinance carement used in Items attached by a licensed attached attached attached attached attached attached attached by a licensed by a	ZiP Code Check here if attachm Complete Sections A, B, C (or E) G8 and G9. surveyor, engineer, or architect warments area below.) ssued BFE) or Zone AO. Ince/Occupancy Issued
Property Owner's or Owner's Authorized Address Signature Comments e local official who is authorized by lad G of this Elevation Certificate. Comis authorized by law to certify A community official complete The following information (Iter A Permit Number This permit has been issued for: Elevation of as-built lowest floor (in BFE or (in Zone AO) depth of flood). Community's design flood elevation of acal Official's Name	SECTION G - COMM SECTION G - COMM We or ordinance to administer the oplete the applicable item(s) and several and several control of the building located and GA-G9) is provided for commod of the building located and GA-G9). We construction cluding basement) of the building at the building site:	City Date MUNITY INFORMATION (OF e community's floodplain managed sign below. Check the measure attion that has been signed and sign the source and date of the elevited in Zone A (without a FEMA-ismunity floodplain management put G6. Date C G Substantial Improvement G Get G n Get G n Get G n Get G n G feet G n G n G n G n G n G n G n G n G n G	State Telephone TIONAL) ement ordinance carement used in Items attached by a licensed attached attached attached attached attached attached attached by a licensed by a	ZiP Code Check here if attachm Complete Sections A, B, C (or E) G8 and G9. surveyor, engineer, or architect warments area below.) ssued BFE) or Zone AO. Ince/Occupancy Issued

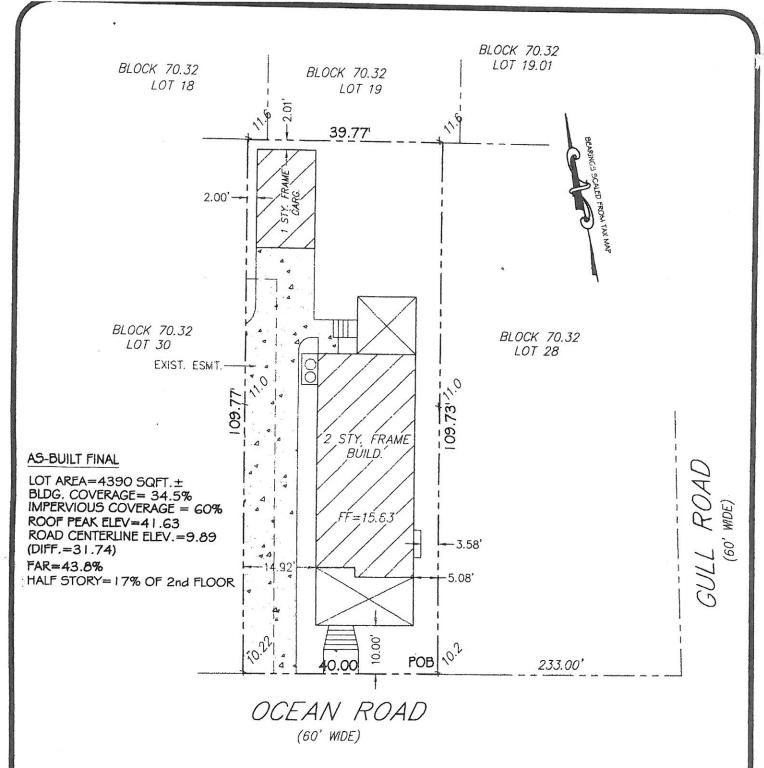

THIS SURVEY PLAN IS BASED ON INFORMATION PROVIDED BY CLIENT
THIS SURVEY PLAN IS NOT A GUARANTEE OF OWNERSHIP
BEING LOT 29, BLOCK 70.32, TAX MAP OF THE CITY OF OCEAN CITY
SURVEYOR RESERVES THE RIGHT TO REVISE THIS PLAN OF SURVEY UPON RECEIPT
AND REVIEW OF AN ACCURATE THIE REPORT AND AN ACCURATE ABSTRACT ON ALL
LOTS AFFECTED BY, OR ADJOINING TO, THE PROPERTY IN QUESTION
NO ATTEMPT WAS MADE TO LOCATE THE UTILITIES WHICH MAY EXIST ON THIS PROPERTY.
PRIOR TO ANY EXCAVATION, CONTRACTOR SHALL BE RESPONSIBLE TO DETERMINE THEIR EXACT LOCATION.
SUBJECT TO BUILDING REGULATIONS, RESTRICTIONS, EASEMENTS, RIGHTS-OF-WAY, COVENANTS, RESERVATIONS
AND AGREEMENTS OF RECORD, IF ANY.

Design Land Surveying P.A. MENDER OF:

P.O. Box 667 Turnersville, N.J. 08012 Toll Free Phone 1-800-418-9373 Phone (856) 374-1134 - Fax (856) 589-0246 DATE _03/17/11 SURVEY NO. SCALE 1"=20' 1103004 DRN:

SKETCH PLAT

158-160 OCEAN ROAD

SITUATE IN: CITY OF OCEAN CITY CAPE MAY COUNTY **NEW JERSEY**

REV: 08/01/11 (HALF STY) REV: 10/26/11 (FINAL)

TO: RALPH J. MELFI

In consideration of the fee pair for making this survey, I hereby deci-assumed for (a) the location of easements that may be located below visible, or matters of title. This declaration is issued solely to the h-shall have no responsibility or liability for any reason unless the fee-reason shall not exceed the sum of ORE THOUSAND DOLLARS (1,000.00)

THOMAS N. TOLBERT
PROFESSIONAL LAND SURVEYOR
N.J. LIC. GS 38608