

ELEVATION CERTIFICATE
FEDERAL EMERGENCY MANAGEMENT AGENCY
NATIONAL FLOOD INSURANCE PROGRAM

O.M.B. NO. 3067-0
Expires May 31, 1993

ATTENTION: Use of this certificate does not provide a waiver of the flood insurance purchase requirement. This form is used only to provide elevation information necessary to ensure compliance with applicable community floodplain management ordinances, to determine the proper insurance premium rate, and/or to support a request for a Letter of Map Amendment or Revision (LOMA or LOI). Instructions for completing this form can be found on the following pages.

SECTION A PROPERTY INFORMATION

BUILDING OWNER'S NAME	FOR INSURANCE COMPANY USE	
STREET ADDRESS (Including Apt., Unit, Suite and/or Bldg. Number) OR R.O. ROUTE AND BOX NUMBER	POLICY NUMBER	
919-21 SECOND STREET	COMPANY NAIC NUMBER	
OTHER DESCRIPTION (Lot and Block Numbers, etc.)		
LOT 9 BLOCK 101 (TAX MAP)		
CITY	STATE	ZIP CODE
(CAPE MAY COUNTY) OCEAN CITY	N. J.	08226

SECTION B FLOOD INSURANCE RATE MAP (FIRM) INFORMATION

Provide the following from the proper FIRM (See Instructions):

1. COMMUNITY NUMBER	2. PANEL NUMBER	3. SUFFIX	4. DATE OF FIRM INDEX	5. FIRM ZONE	6. BASE FLOOD ELEVATION (in AC Zone, use 0000)
345310	0001	C	9/05/84	A7	EL. 10

7. Indicate the elevation datum system used on the FIRM for Base Flood Elevations (BFE): ☒ NGVD '29 ☐ Other (describe on page 2).
8. For Zones A or V, where no BFE is provided on the FIRM, and the community has established a BFE for this building site, indicate the community's BFE: 11 feet NGVD (or other FIRM datum—see Section B, Item 7).

SECTION C BUILDING ELEVATION INFORMATION

1. Using the Elevation Certificate Instructions, indicate the diagram number from the diagrams found on Pages 5 and 6 that best describes the subject building's reference level 5.
- 2a). FIRM Zones A1-A30, AE, AH, and A (with BFE). The top of the reference level floor from the selected diagram is at an elevation of 00 01 10 14 feet NGVD (or other FIRM datum—see Section B, Item 7).
- 2b). FIRM Zones V1-V30, VE, and V (with BFE). The bottom of the lowest horizontal structural member of the reference elevation from the selected diagram, is at an elevation of 11 11 11 11 feet NGVD (or other FIRM datum—see Section B, Item 7).
- 3a). FIRM Zone A (without BFE). The floor used as the reference level from the selected diagram is 11 11 11 11 feet above ☐ or below ☐ (check one) the highest grade adjacent to the building.
- 3b). FIRM Zone AO. The floor used as the reference level from the selected diagram is 11 11 11 11 feet above ☐ or below ☐ (check one) the highest grade adjacent to the building. If no flood depth number is available, is the building's lowest floor (reference level) elevated in accordance with the community's floodplain management ordinance? ☐ Yes ☐ No ☐ Unknown
3. Indicate the elevation datum system used in determining the above reference level elevations: ☒ NGVD '29 ☐ Other (describe under Comments on Page 2). (NOTE: If the elevation datum used in measuring the elevations is different than that used on the FIRM [see Section B, Item 7], then convert the elevations to the datum system used on the FIRM and show the conversion equation under Comments on Page 2.)
4. Elevation reference mark used appears on FIRM: ☒ Yes ☐ No (See Instructions on Page 4)
5. The reference level elevation is based on: ☒ actual construction ☐ construction drawings
(NOTE: Use of construction drawings is only valid if the building does not yet have the reference level floor in place. In which case this certificate will only be valid for the building during the course of construction. A post-construction Elevation Certificate will be required once construction is complete.)
6. The elevation of the lowest grade immediately adjacent to the building is: 01 01 01 06 18 feet NGVD (or other FIRM datum—see Section B, Item 7).

SECTION D COMMUNITY INFORMATION

1. If the community official responsible for verifying building elevation's specifies that the reference level indicated in Section C, Item 1 is not the "lowest floor" as defined in the community's floodplain management ordinance, the elevation of the building's "lowest floor" as defined by the ordinance is: 11 11 11 11 feet NGVD (or other FIRM datum—see Section B, Item 7).
2. Date of the start of construction or substantial improvement: _____

SECTION E CERTIFICATION

This certification is to be signed by a land surveyor, engineer, or architect who is authorized by state or local law to certify elevation information when the elevation information for Zones A1-A30, AE, AH, A (with BFE), V1-V30, VE, and V (with BFE) is required. Community officials who are authorized by local law or ordinance to provide floodplain management information, may also sign the certification. In the case of Zones AO and A (without a FEMA or community issued BFE), a building official, a property owner, or an owner's representative may also sign the certification.

Reference level diagrams 6, 7 and 8 - Distinguishing Features-If the certifier is unable to certify to breakaway/non-breakaway wall, enclosure size, location of servicing equipment, area use, wall openings, or unfinished area Feature(s), then list the Feature(s) not included in the certification under Comments below. The diagram number, Section C, Item 1, must still be entered.


I certify that the information in Sections B and C on this certificate represents my best efforts to interpret the data available. I understand that any false statement may be punishable by fine or imprisonment under 18 U.S. Code, Section 1001.

THOMAS P. KARR	31269	
CERTIFIER'S NAME	LICENSE NUMBER (or Affix Seal)	
PROF. LAND SURVEYOR	KARR LAND SURVEYING	
TITLE	COMPANY NAME	
PO BOX 89	SENVILLE	NJ 08360
ADDRESS	CITY	STATE ZIP
THOMAS P. KARR	7/10/97	609 390 7936
SIGNATURE	DATE	PHONE

Copies should be made of this Certificate for: 1) community official, 2) insurance agent/company, and 3) building owner.

COMMENTS: CITY OF OCEAN CITY
JUL 11 10 02 AM '97

Ref Level is
Bottom of Heater

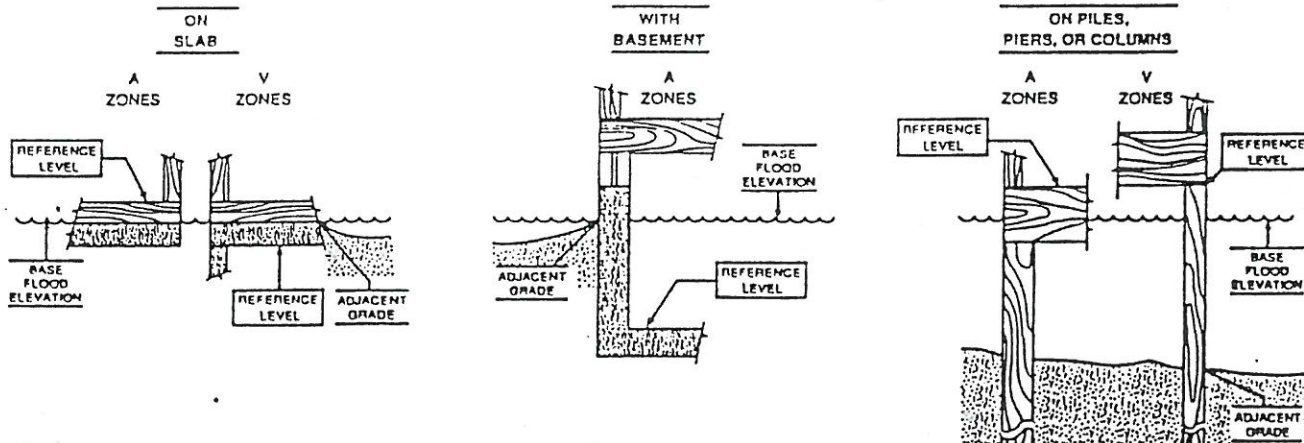

The diagrams above illustrate the points at which the elevations should be measured in A Zones and V Zones.

Elevations for all A Zones should be measured at the top of the reference level floor.

Elevations for all V Zones should be measured at the bottom of the lowest horizontal structural member.


15' w Public Alley

TAX MAP NORTH

Conithian Ave (60'w)

Tie 191'

(BEG)

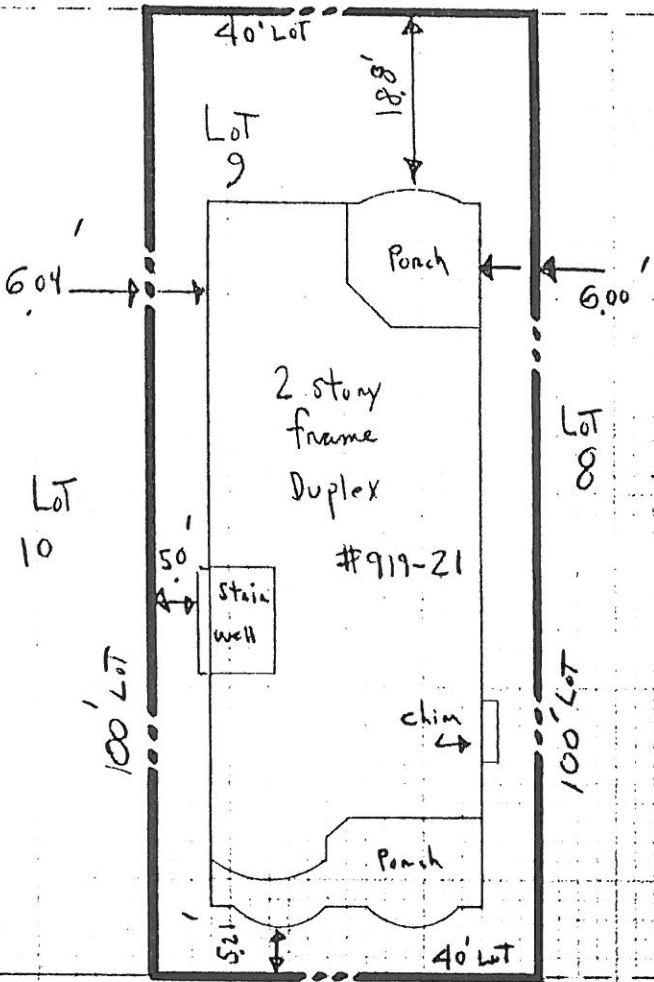

NOTE :
40' X 100' LOT
ALL LOT CORNERS
ARE 90°

ALL ELEV. ARE
NGVD

Roof Peak Elev 41.25
2nd St. Elev 6.53

Diff 34.72 Feet

2nd St. (60'w)

OK
J. Carr
7/14/97

To:
MR. PANSINI / Hafelfinger Standeven

FINAL / ASBUILT

KARR
LAND SURVEYING
P.O. BOX 89
OCEANVIEW, N.J. 08230
PHONE 609 390 7936 FAX 390 7937
Thomas P. Karr
THOMAS P. KARR
P.L.S. LICENSE NO. 31269

PLAN OF SURVEY	
BLOCK(s) <u>101</u>	LOT(s) <u>9</u>
<u>OCEAN CITY</u>	
COUNTY OF <u>CAPE MAY</u>	
NEW JERSEY	
TYPE <u>THREE</u>	Date <u>7.10.97</u> Drawn By <u>GS</u>
REVISIONS	Scale <u>1"=20'</u> Chk'd By <u>TK</u>
Date	PROJECT NO. <u>96345</u>