

FEDERAL EMERGENCY MANAGEMENT AGENCY
 NATIONAL FLOOD INSURANCE PROGRAM
ELEVATION CERTIFICATE

O.M.B. No. 3067-0077
 Expires July 31, 2002

Important: Read the instructions on pages 1 - 7.

| SECTION A - PROPERTY OWNER INFORMATION | | | For Insurance Company Use: | |
|--|-------------|--|--|--|
| BUILDING OWNER'S NAME James B. and Margaret A. Coe | | | Policy Number | |
| BUILDING STREET ADDRESS (Including Apt., Unit, Suite, and/or Bldg. No.) OR P.O. ROUTE AND BOX NO. # 826 St. Charles Place | | | Company NAIC Number | |
| CITY Ocean City | STATE NJ | | ZIP CODE 08226 | |
| PROPERTY DESCRIPTION (Lot and Block Numbers, Tax Parcel Number, Legal Description, etc.) Lot 12, Block 103 | | | | |
| BUILDING USE (e.g., Residential, Non-residential, Addition, Accessory, etc. Use Comments section if necessary.) residential | | | | |
| LATITUDE/LONGITUDE (OPTIONAL) (##° - ##' - ###.###" or ###.#####") | | HORIZONTAL DATUM: <input type="checkbox"/> NAD 1927 <input type="checkbox"/> NAD 1983 | SOURCE: <input type="checkbox"/> GPS (Type): _____ <input type="checkbox"/> USGS Quad Map <input type="checkbox"/> Other: _____ | |

| SECTION B - FLOOD INSURANCE RATE MAP (FIRM) INFORMATION | | | | | |
|--|-----------------|--------------------------------|---|-------------------------|--|
| B1. NFIP COMMUNITY NAME & COMMUNITY NUMBER Ocean City 345310 | | B2. COUNTY NAME Cape May | | B3. STATE NJ | |
| B4. MAP AND PANEL NUMBER 345310 0001 | B5. SUFFIX C | B6. FIRM INDEX DATE 7/15/92 | B7. FIRM PANEL EFFECTIVE/REVISED DATE 9/5/84 | B8. FLOOD ZONE(S) A7 | B9. BASE FLOOD ELEVATION(S) (Zone AO, use depth of flooding) 9' |
| B10. Indicate the source of the Base Flood Elevation (BFE) data or base flood depth entered in B9. <input type="checkbox"/> FIS Profile <input checked="" type="checkbox"/> FIRM <input type="checkbox"/> Community Determined <input type="checkbox"/> Other (Describe): _____ | | | | | |
| B11. Indicate the elevation datum used for the BFE in B9: <input checked="" type="checkbox"/> NGVD 1929 <input type="checkbox"/> NAVD 1988 <input type="checkbox"/> Other (Describe): _____ | | | | | |
| B12. Is the building located in a Coastal Barrier Resources System (CBRS) area or Otherwise Protected Area (OPA)? <input type="checkbox"/> Yes <input checked="" type="checkbox"/> No Designation Date: _____ | | | | | |

| SECTION C - BUILDING ELEVATION INFORMATION (SURVEY REQUIRED) | |
|--|--|
| C1. Building elevations are based on: <input type="checkbox"/> Construction Drawings* <input type="checkbox"/> Building Under Construction* <input checked="" type="checkbox"/> Finished Construction *A new Elevation Certificate will be required when construction of the building is complete. | |
| C2. Building Diagram Number <u>8</u> (Select the building diagram most similar to the building for which this certificate is being completed - see pages 6 and 7. If no diagram accurately represents the building, provide a sketch or photograph.) | |
| C3. Elevations - Zones A1-A30, AE, AH, A (with BFE), VE, V1-V30, V (with BFE), AR, AR/A, AR/AE, AR/A1-A30, AR/AH, AR/AO Complete Items C3a-i below according to the building diagram specified in Item C2. State the datum used. If the datum is different from the datum used for the BFE in Section B, convert the datum to that used for the BFE. Show field measurements and datum conversion calculation. Use the space provided or the Comments area of Section D or Section G, as appropriate, to document the datum conversion. Datum <u>NGVD 29</u> Conversion/Comments _____ Elevation reference mark used <u>USCGS DISK "TIDAL"</u> Does the elevation reference mark used appear on the FIRM? <input type="checkbox"/> Yes <input checked="" type="checkbox"/> No | |
| <input type="checkbox"/> a) Top of bottom floor (including basement or enclosure) <input type="checkbox"/> b) Top of next higher floor <input type="checkbox"/> c) Bottom of lowest horizontal structural member (V zones only) <input type="checkbox"/> d) Attached garage (top of slab) <input type="checkbox"/> e) Lowest elevation of machinery and/or equipment servicing the building <input type="checkbox"/> f) Lowest adjacent grade (LAG) <input type="checkbox"/> g) Highest adjacent grade (HAG) <input type="checkbox"/> h) No. of permanent openings (flood vents) within 1 ft. above adjacent grade <u>17</u> <input type="checkbox"/> i) Total area of all permanent openings (flood vents) in C3h <u>2,448</u> sq. in. (sq. cm) | _____ 9.8 ft.(m) _____ 12.7 ft.(m) _____ N/A _____ ft.(m) _____ 9.8 ft.(m) _____ 10.3 ft.(m) _____ 9.5 ft.(m) _____ 9.6 ft.(m) |

License Number, Embossed Seal, Signature, and Date



| SECTION D - SURVEYOR, ENGINEER, OR ARCHITECT CERTIFICATION | | | |
|---|--|---------------------------------|-------------------|
| This certification is to be signed and sealed by a land surveyor, engineer, or architect authorized by law to certify elevation information. I certify that the information in Sections A, B, and C on this certificate represents my best efforts to interpret the data available. I understand that any false statement may be punishable by fine or imprisonment under 18 U.S. Code, Section 1001. | | | |
| CERTIFIER'S NAME David C. Kruger | | LICENSE NUMBER NJ Lic. 30406 | |
| TITLE Professional Land Surveyor | COMPANY NAME David C. Kruger Associates | | |
| ADDRESS 3323 Simpson Avenue | CITY Ocean City | STATE NJ | ZIP CODE 08226 |
| SIGNATURE  | DATE 5/3/00 | TELEPHONE (609) 391-9393 | |

| | | | |
|--|-------------|-------------------|----------------------------|
| IMPORTANT: In these spaces, copy the corresponding information from Section A. | | | For Insurance Company Use: |
| BUILDING STREET ADDRESS (Including Apt., Unit, Suite, and/or Bldg. No.) OR P.O. ROUTE AND BOX NO. # 826 St. Charles Place | | | Policy Number |
| CITY Ocean City | STATE NJ | ZIP CODE 08226 | Company NAIC Number |

SECTION D - SURVEYOR, ENGINEER, OR ARCHITECT CERTIFICATION (CONTINUED)

Copy both sides of this Elevation Certificate for (1) community official, (2) insurance agent/company, and (3) building owner.

COMMENTS

Check here if attachments

SECTION E - BUILDING ELEVATION INFORMATION (SURVEY NOT REQUIRED) FOR ZONE AO AND ZONE A (WITHOUT BFE)

For Zone AO and Zone A (without BFE), complete Items E1 through E4. *If the Elevation Certificate is intended for use as supporting information for a LOMA or LOMR-F, Section C must be completed.*

- E1. Building Diagram Number _____ (Select the building diagram most similar to the building for which this certificate is being completed – see pages 6 and 7. If no diagram accurately represents the building, provide a sketch or photograph.)
- E2. The top of the bottom floor (including basement or enclosure) of the building is _____ ft.(m) _____ in.(cm) _____ above or _____ below (check one) the highest adjacent grade.
- E3. For Building Diagrams 6-8 with openings (see page 7), the next higher floor or elevated floor (elevation b) of the building is _____ ft.(m) _____ in.(cm) above the highest adjacent grade.
- E4. For Zone AO only: If no flood depth number is available, is the top of the bottom floor elevated in accordance with the community's floodplain management ordinance? Yes No Unknown. The local official must certify this information in Section G.

SECTION F - PROPERTY OWNER (OR OWNER'S REPRESENTATIVE) CERTIFICATION

The property owner or owner's authorized representative who completes Sections A, B, and E for Zone A (without a FEMA-issued or community-issued BFE) or Zone AO must sign here.

PROPERTY OWNER'S OR OWNER'S AUTHORIZED REPRESENTATIVE'S NAME _____

ADDRESS _____ CITY _____ STATE _____ ZIP CODE _____

SIGNATURE _____ DATE _____ TELEPHONE _____

COMMENTS _____

Check here if attachments

SECTION G - COMMUNITY INFORMATION (OPTIONAL)

The local official who is authorized by law or ordinance to administer the community's floodplain management ordinance can complete Sections A, B, C (or E), and G of this Elevation Certificate. Complete the applicable item(s) and sign below.

- G1. The information in Section C was taken from other documentation that has been signed and embossed by a licensed surveyor, engineer, or architect who is authorized by state or local law to certify elevation information. (Indicate the source and date of the elevation data in the Comments area below.)
- G2. A community official completed Section E for a building located in Zone A (without a FEMA-issued or community-issued BFE) or Zone AO.
- G3. The following information (Items G4-G9) is provided for community floodplain management purposes.

| | | |
|------------------------------|-----------------------------------|--|
| G4. PERMIT NUMBER 99-2212 | G5. DATE PERMIT ISSUED 12/8/99 | G6. DATE CERTIFICATE OF COMPLIANCE/OCCUPANCY ISSUED 5/24/00 |
|------------------------------|-----------------------------------|--|

- G7. This permit has been issued for: New Construction Substantial Improvement
- G8. Elevation of as-built lowest floor (including basement) of the building is: _____ ft.(m) Datum: _____
- G9. BFE or (in Zone AO) depth of flooding at the building site is: _____ ft.(m) Datum: _____

LOCAL OFFICIAL'S NAME _____ TITLE _____

COMMUNITY NAME _____ TELEPHONE _____


SIGNATURE _____ DATE _____

COMMENTS _____

Check here if attachments

± = 8.87'

ST. CHARLES (70') PLACE

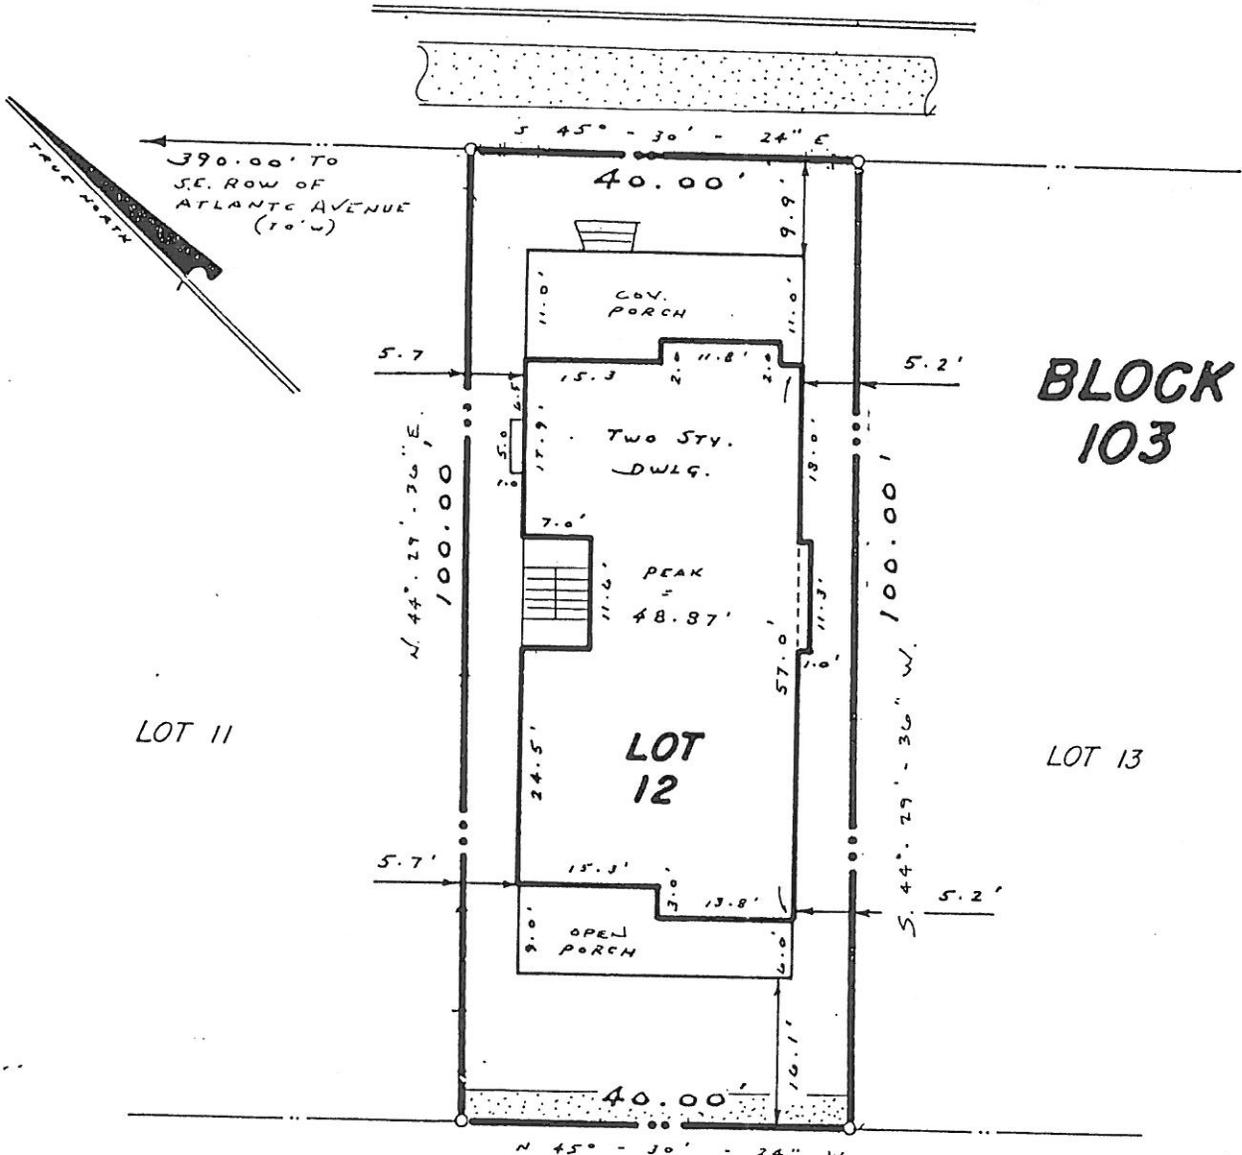

BLOCK 103

LOT 11

LOT 13

PUBLIC (15') ALLEY

48.87
887
40.00

Issued to:

- JAMES B. COE
- MARGARET A. COE

Frankly Approved 5/18/00
[Signature]

TOTAL BUILDING COVERAGE = 48.6 %
 - including covered porch = 48.6 %
 - excluding covered porch = 41.2 %
 TOTAL IMPERVIOUS COVERAGE = 57.1 %

Overlay

| | | | |
|---|--------|------------------|-------------------------|
| PLAN OF SURVEY | | | |
| LOT 12 | | BLOCK 103 | |
| CITY OF OCEAN CITY CAPE MAY COUNTY, N.J. | | | |
| DAVID C. KRUGER ASSOCIATES Land Surveying • Planning 3323 Simpson Avenue, Suite 6 • Ocean City, NJ | | | |
| | | date 3.2.00 | drawn P.T. |
| FINAL SURVEY | 5.3.00 | D.K. | scale 1" = 20' |
| checked D.K. | | | |
| revision: | date | by | book - pg. - Proj. 7762 |

[Signature]
DAVID C. KRUGER
N.J.P.L.S. License No. 30406

Not valid unless seal embossed