

FEDERAL EMERGENCY MANAGEMENT AGENCY
NATIONAL FLOOD INSURANCE PROGRAM

O.M.B. No. 3067-0077
Expires July 31, 2002

ELEVATION CERTIFICATE

Important: Read the instructions on pages 1 - 7.

SECTION A - PROPERTY OWNER INFORMATION

For Insurance Company Use:

BUILDING OWNER'S NAME

Policy Number

BUILDING STREET ADDRESS (Including Apt., Unit, Suite, and/or Bldg. No.) OR P.O. ROUTE AND BOX NO.

Company NAIC Number

900 Second Street

CITY Ocean City

STATE

New Jersey

ZIP CODE

08226

PROPERTY DESCRIPTION (Lot and Block Numbers, Tax Parcel Number, Legal Description, etc.)

Lot 1, Block 200

BUILDING USE (e.g., Residential, Non-residential, Addition, Accessory, etc. Use Comments section if necessary.)

Residential

LATITUDE/LONGITUDE (OPTIONAL)

HORIZONTAL DATUM:

SOURCE: ☐ GPS (Type):

(##° - ##' - ##.##" or ##.#####)

☐ NAD 1927 ☐ NAD 1983

☐ USGS Quad Map ☐ Other:

SECTION B - FLOOD INSURANCE RATE MAP (FIRM) INFORMATION

B1. NFIP COMMUNITY NAME & COMMUNITY NUMBER

City of Ocean City

345310

B2. COUNTY NAME

Cape May County

B3. STATE

New Jersey

B4. MAP AND PANEL
NUMBER

345310 0001

B5. SUFFIX

C

B6. FIRM INDEX
DATE

7/15/1992

B7. FIRM PANEL
EFFECTIVE/REVISED DATE

7-1-1974/9-5-1984

B8. FLOOD
ZONE(S)

A7

B9. BASE FLOOD ELEVATION(S)
(Zone AO, use depth of flooding)

10'

B10. Indicate the source of the Base Flood Elevation (BFE) data or base flood depth entered in B9.

☐ FIS Profile ☒ FIRM ☐ Community Determined ☐ Other (Describe):

B11. Indicate the elevation datum used for the BFE in B9: ☒ NGVD 1929 ☐ NAVD 1988 ☐ Other (Describe):

B12. Is the building located in a Coastal Barrier Resources System (CBRS) area or Otherwise Protected Area (OPA)? ☐ Yes ☒ No

Designation Date:

SECTION C - BUILDING ELEVATION INFORMATION (SURVEY REQUIRED)

C1. Building elevations are based on: ☐ Construction Drawings* ☐ Building Under Construction* ☒ Finished Construction

*A new Elevation Certificate will be required when construction of the building is complete.

C2. Building Diagram Number 7 (Select the building diagram most similar to the building for which this certificate is being completed - see pages 6 and 7. If no diagram accurately represents the building, provide a sketch or photograph.)

C3. Elevations - Zones A1-A30, AE, AH, A (with BFE), VE, V1-V30, V (with BFE), AR, AR/A, AR/AE, AR/A1-A30, AR/AH, AR/AO. Complete Items C3a-i below according to the building diagram specified in Item C2. State the datum used. If the datum is different from the datum used for the BFE in Section B, convert the datum to that used for the BFE. Show field measurements and datum conversion calculation. Use the space provided or the Comments area of Section D or Section G, as appropriate, to document the datum conversion.

Datum NGVD 29 Conversion/Comments

Elevation reference mark used _____ Does the elevation reference mark used appear on the FIRM? ☐ Yes ☒ No

- ☐ a) Top of bottom floor (including basement or enclosure) 7.9 ft. (ft.)
- ☐ b) Top of next higher floor 16.3 ft. (ft.)
- ☐ c) Bottom of lowest horizontal structural member (V zones only) N/A ft. (m)
- ☐ d) Attached garage (top of slab) 7.9 ft. (ft.)
- ☐ e) Lowest elevation of machinery and/or equipment servicing the building 10.0 ft. (ft.)
- ☐ f) Lowest adjacent grade (LAG) 7.4 ft. (ft.)
- ☐ g) Highest adjacent grade (HAG) 7.4 ft. (ft.)
- ☐ h) No. of permanent openings (flood vents) within 1 ft. above adjacent grade 12
- ☐ i) Total area of all permanent openings (flood vents) in C3h 2,592 sq. in. (sq. ft.)

License Number, Embossed Seal, Signature, and Date

L.S.N° 34844 1/5/2001

Mark G. DeVaul

SECTION D - SURVEYOR, ENGINEER, OR ARCHITECT CERTIFICATION

This certification is to be signed and sealed by a land surveyor, engineer, or architect authorized by law to certify elevation information. I certify that the information in Sections A, B, and C on this certificate represents my best efforts to interpret the data available.

I understand that any false statement may be punishable by fine or imprisonment under 18 U.S. Code, Section 1001.

CERTIFIER'S NAME

Mark G. DeVaul

LICENSE NUMBER 34844

TITLE

Land Surveyor

COMPANY NAME

DeVaul Surveying

ADDRESS

20 DeVauls Lane

CITY Ocean View

STATE

New Jersey

ZIP CODE

08230

SIGNATURE

Mark G. DeVaul

DATE

Jan. 5, 2001

TELEPHONE

(609) 624-0572

IMPORTANT: In these spaces, copy the corresponding information from Section A.			For Insurance Company Use:	
BUILDING STREET ADDRESS (Including Apt., Unit, Suite, and/or Bldg. No.) OR P.O. ROUTE AND BOX NO. 900 Second Street			Policy Number	
CITY Ocean City	STATE New Jersey	ZIP CODE 08226	Company NAIC Number	

SECTION D - SURVEYOR, ENGINEER, OR ARCHITECT CERTIFICATION (CONTINUED)

Copy both sides of this Elevation Certificate for (1) community official, (2) insurance agent/company, and (3) building owner.

COMMENTS

☐ Check here if attachments

SECTION E - BUILDING ELEVATION INFORMATION (SURVEY NOT REQUIRED) FOR ZONE AO AND ZONE A (WITHOUT BFE)

For Zone AO and Zone A (without BFE), complete Items E1 through E4. If the Elevation Certificate is intended for use as supporting information for a LOMA or LOMR-F, Section C must be completed.

- E1. Building Diagram Number _____ (Select the building diagram most similar to the building for which this certificate is being completed - see pages 6 and 7. If no diagram accurately represents the building, provide a sketch or photograph.)
- E2. The top of the bottom floor (including basement or enclosure) of the building is _____ ft.(m) _____ in.(cm) ☐ above or ☐ below (check one) the highest adjacent grade.
- E3. For Building Diagrams 6-8 with openings (see page 7), the next higher floor or elevated floor (elevation b) of the building is _____ ft.(m) _____ in.(cm) above the highest adjacent grade.
- E4. For Zone AO only: If no flood depth number is available, is the top of the bottom floor elevated in accordance with the community's floodplain management ordinance? ☐ Yes ☐ No ☐ Unknown. The local official must certify this information in Section G.

SECTION F - PROPERTY OWNER (OR OWNER'S REPRESENTATIVE) CERTIFICATION

The property owner or owner's authorized representative who completes Sections A, B, and E for Zone A (without a FEMA-issued or community-issued BFE) or Zone AO must sign here.

PROPERTY OWNER'S OR OWNER'S AUTHORIZED REPRESENTATIVE'S NAME

ADDRESS CITY STATE ZIP CODE

SIGNATURE DATE TELEPHONE

COMMENTS

☐ Check here if attachments

SECTION G - COMMUNITY INFORMATION (OPTIONAL)

The local official who is authorized by law or ordinance to administer the community's floodplain management ordinance can complete sections A, B, C (or E), and G of this Elevation Certificate. Complete the applicable item(s) and sign below.

1. ☐ The information in Section C was taken from other documentation that has been signed and embossed by a licensed surveyor, engineer, or architect who is authorized by state or local law to certify elevation information. (Indicate the source and date of the elevation data in the Comments area below.)
2. ☐ A community official completed Section E for a building located in Zone A (without a FEMA-issued or community-issued BFE) or Zone AO.
3. ☐ The following information (Items G4-G9) is provided for community floodplain management purposes.

G4. PERMIT NUMBER 99-0921	G5. DATE PERMIT ISSUED 5/25/99	G6. DATE CERTIFICATE OF COMPLIANCE/OCCUPANCY ISSUED 4/25/01
------------------------------	-----------------------------------	--

7. This permit has been issued for: ☐ New Construction ☐ Substantial Improvement

8. Elevation of as-built lowest floor (including basement) of the building is: _____ ft.(m) Datum: _____

9. BFE or (in Zone AO) depth of flooding at the building site is: _____ ft.(m) Datum: _____


LOCAL OFFICIAL'S NAME TITLE

COMMUNITY NAME TELEPHONE

SIGNATURE DATE

COMMENTS

☐ Check here if attachments

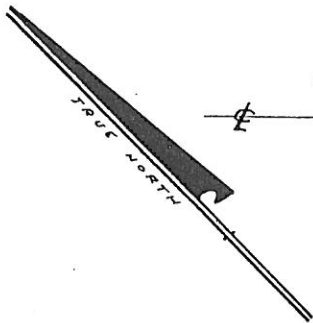

SECOND


(60')

STREET

AVENUE

(60')

CORINTHIAN

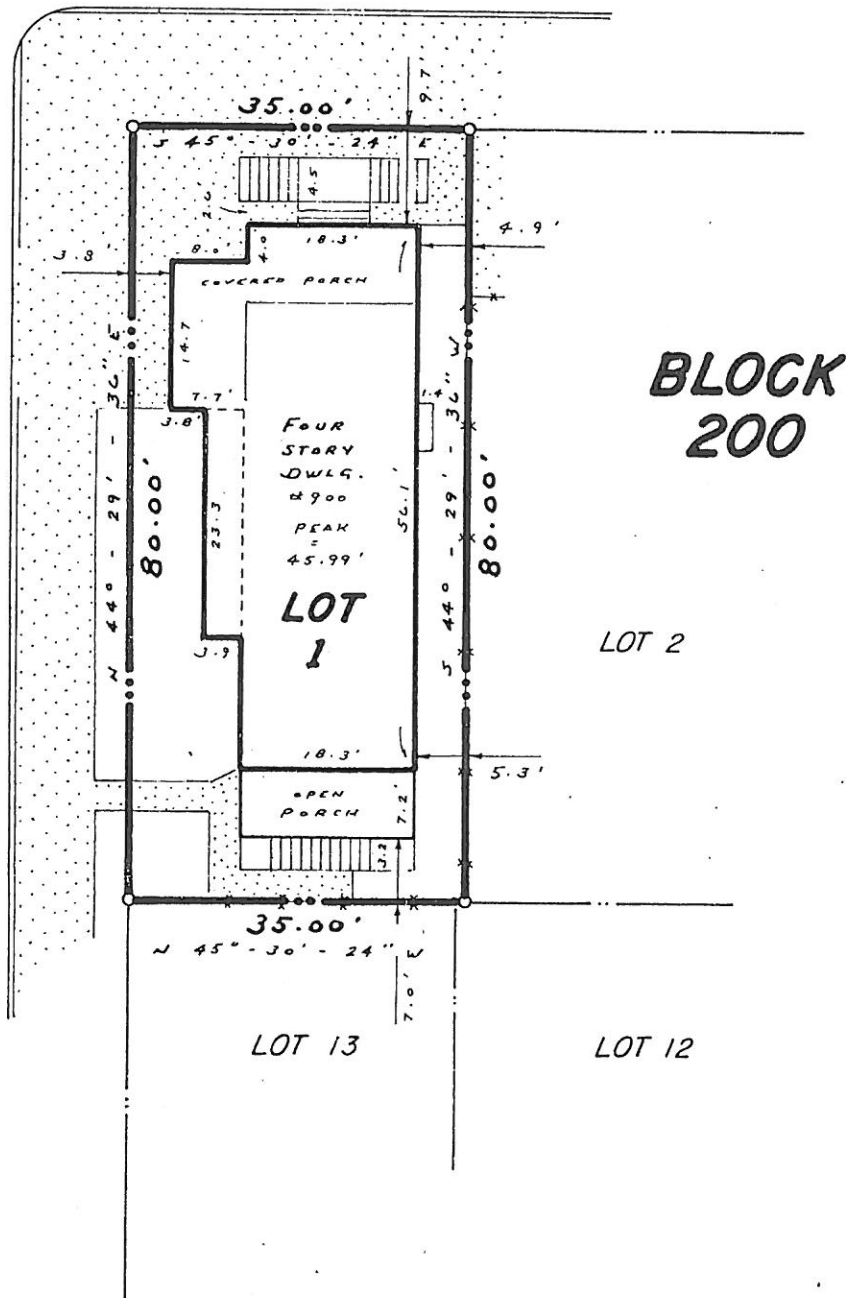

BLOCK
200

LOT 2

LOT 13

LOT 12

Issued to:

ROBERTS BURNS

NOTE: This survey is made subject to any rights, restrictions, easements, rights-of-way exceptions or covenants that an accurate and current title report may disclose.

Any insuror of title relying hereon and any other party in interest:

In consideration of the fee paid for making this survey, I hereby certify to its accuracy (except such easements, if any, that may exist below the surface of the land or on the surface of the lands and not visible) as an inducement for any insuror of title to insure the title to the lands and premises as shown therein. This certification is made only to above named parties for purchase and/or mortgage of herein delineated property by above named purchaser. No responsibility or liability is assumed by Surveyor for use of survey for any other purpose including but not limited to use of survey for survey affidavit, resale of property, or to any other person not listed in certification, either directly or indirectly.

DAVID C. KRUGER

N.J.P.L.S. License No. 30406

PLAN OF SURVEY

LOT 1

BLOCK 200

CITY OF OCEAN CITY
CAPE MAY COUNTY, N.J.

DAVID C. KRUGER ASSOCIATES

Land Surveying • Planning

3323 Simpson Avenue, Suite 6 • Ocean City, NJ

			date 7.13.2000	drawn P.T.
			scale 1" = 20'	checked D.K.
revision:	date:	by:	book - pg. -	Proj. 7934