## U.S. DEPARTMENT OF HOMELAND SECURITY

## **ELEVATION CERTIFICATE**

OMB No. 1660-0008 Expires March 31, 2012

Federal Emergency Management Agency National Flood Insurance Program Important: Read the instructions on pages 1-9. **SECTION A - PROPERTY INFORMATION** For Insurance Company Use: A1. Building Owner's Name Robert & Constance Meng Policy Number A2. Building Street Address (including Apt., Unit, Suite, and/or Bldg. No.) or P.O. Route and Box No.

832 Second Street	Company NAIC Number
City Ocean City State NJ ZIP Code 08226	
A3. Property Description (Lot and Block Numbers, Tax Parcel Number, Legal Description, etc.) Block 203 Lot 14	
A4. Building Use (e.g., Residential, Non-Residential, Addition, Accessory, etc.) Residential  A5. Latitude/Longitude: Lat. 40 07 49.0 Long. 75 40 27.6 Horizontal Datum:  A6. Attach at least 2 photographs of the building if the Certificate is being used to obtain flood insurance.  A7. Building Diagram Number 7	☐ NAD 1927 ⊠ NAD 1983
A8. For a building with a crawlspace or enclosure(s):  a) Square footage of crawlspace or enclosure(s)  b) No. of permanent flood openings in the crawlspace or enclosure(s) within 1.0 foot above adjacent grade  c) Total net area of flood openings?  A9. For a building with an attact and square footage of attact and square footage of attact and square footage of attact and square flood openings in the crawlspace or enclosure(s) within 1.0 foot above adjacent grade  c) Total net area of flood openings?  A9. For a building with an attact and square footage of attact and square footage of attact and square footage of attact and square flood openings and square footage of attact and square flood openings and square footage of attact and square flood openings and squar	thed garage 673 sq ft openings in the attached garage lijacent grade 0 sq in openings in A9.b 0 sq in ongs?
SECTION B - FLOOD INSURANCE RATE MAP (FIRM) INFORMATION	
Occan City 245210	33. State NJ
B4. Map/Panel Number 345310 0001         B5. Suffix C         B6. FIRM Index Date July 15, 1992         B7. FIRM Panel Effective/Revised Date September 5, 1984         B8. Flood Zone(s) A7	B9. Base Flood Elevation(s) (Zone AO, use base flood depth)
B10. Indicate the source of the Base Flood Elevation (BFE) data or base flood depth entered in Item B9.  ☐ FIS Profile ☐ FIRM ☐ Community Determined ☐ Other (Describe)  B11. Indicate elevation datum used for BFE in Item B9: ☐ NGVD 1929 ☐ NAVD 1988 ☐ Other (Describe B12. Is the building located in a Coastal Barrier Resources System (CBRS) area or Otherwise Protected Area (OPA)?  ☐ CBRS ☐ OPA	) □ Yes ⊠ No
SECTION C - BUILDING ELEVATION INFORMATION (SURVEY REQUIR	ED)
<ul> <li>Building elevations are based on:</li></ul>	☑ Finished Construction , AR/AO. Complete Items C2.a-h
Check the measurem	ent used.
a) Top of bottom floor (including basement, crawlspace, or enclosure floor) 9.0	Rico only)
c) Bottom of the lowest horizontal structural member (V Zones only)  n.a  feet meters (Puerton Meters)  Attached garage (top of slab)  9.0  feet meters (Puerton Meters)	
d) Attached garage (top of slab) <u>9.0</u>	(5.5)
f) Lowest adjacent (finished) grade next to building (LAG) 8.3 🛮 feet 🗀 meters (Puerto	Rico only)
g) Highest adjacent (finished) grade next to building (HAG) 8.4	•••••••••••••••••••••••••••••••••••••••
SECTION D - SURVEYOR, ENGINEER, OR ARCHITECT CERTIFICATION	J
This certification is to be signed and sealed by a land surveyor, engineer, or architect authorized by law to certify elevatic information. I certify that the information on this Certificate represents my best efforts to interpret the data available. I understand that any false statement may be punishable by fine or imprisonment under 18 U.S. Code, Section 1001.	
<ul> <li>☑ Check here if comments are provided on back of form.</li> <li>Were latitude and longitude in Section A provided by a</li> </ul>	PLAGE
	SFAL HERE
licensed land surveyor? ☑ Yes ☐ No  Certifier's Name Stephen C. Martinelli  License Number 30089  Title Professional Land Surveyor Company Name Stephen C. Martinelli Land Surveying LLC	SEAL
licensed land surveyor? ☑ Yes ☐ No  Certifier's Name Stephen C. Martinelli  License Number 30089	SEAL

FEMA Form 81-31, Mar 09


See reverse side for continuation.

Replaces all previous editions

	esponding information from Section A.	For Insurance Company Use:
	d/or Bldg. No.) or P.O. Route and Box No.	Policy Number
332 Second Street  City Ocean CityState NJ ZIP Code 08226		Company NAIC Number
	OR, ENGINEER, OR ARCHITECT CERTIFICA	
copy both sides of this Elevation Certificate for (1) com	nmunity official, (2) insurance agent/company, and (3)	) building owner.
Comments Machinery = Heater in garage The entire ground floor/garage is slab on g	grade construction. The principal use is on the floor a	above.
	Rev. 7-21-10	
Signature	Date 6-18-10	
SECTION E - BUILDING FLEVATION INFO	RMATION (SURVEY NOT REQUIRED) FOR Z	Check here if attachme
DOLLOW ELEVATION IN O	TAMATION (GONTET NOT REGUNED) TOR 2	ONE AO AND ZONE A (WITHOUT BFE)
<ul> <li>b) Top of bottom floor (including basement, crawled).</li> <li>For Building Diagrams 6-9 with permanent flood (elevation C2.b in the diagrams) of the building is</li> <li>Attached garage (top of slab) is</li> <li>Top of platform of machinery and/or equipment s</li> <li>Zone AO only: If no flood depth number is available.</li> </ul>	e. Check the measurement used. In Puerto Rico onlid check the appropriate boxes to show whether the est.).  Ispace, or enclosure) is feet  openings provided in Section A Items 8 and/or 9 (see to be feet above or  feet meters above or below the Hervicing the building is feet measurement.	ly, enter meters. elevation is above or below the highest adjacent  meters ☐ above or ☐ below the HAG. meters ☐ above or ☐ below the LAG. e pages 8-9 of Instructions), the next higher floor ☐ below the HAG. HAG. eters ☐ above or ☐ below the HAG. ance with the community's floodplain manageme
ordinance? Yes No Unknown. The	e local official must certify this information in Section	G.
SECTION F - PROPERT	TY OWNER (OR OWNER'S REPRESENTATIV	/E) CERTIFICATION
r Zone AO must sign here. The statements in Section roperty Owner's or Owner's Authorized Representative ddress		e. State ZIP Code
ignature		
	Date	Telephone
omments		
		☐ Check here if attachm
SECTIO	N G - COMMUNITY INFORMATION (OPTION	
local official who is authorized by law or ordinance to G of this Elevation Certificate. Complete the applica	ble item(s) and sign below. Check the measurement ther documentation that has been signed and sealed	t used in Items G8 and G9.  by a licensed surveyor, engineer, or architect water in the Comments area below.)
A community official completed Section E for a	building located in Zone A (without a FEMA-issued or vided for community floodplain management purpose	
□ A community official completed Section E for a □ The following information (Items G4-G9) is produced.	building located in Zone A (without a FEMA-issued ovided for community floodplain management purpose	
A community official completed Section E for a The following information (Items G4-G9) is prod Permit Number G5. Date Perm This permit has been issued for:  Elevation of as-built lowest floor (including basemer BFE or (in Zone AO) depth of flooding at the building	building located in Zone A (without a FEMA-issued of vided for community floodplain management purpose nit Issued 12/7/09 G6. Date Certification Substantial Improvement nt) of the building: feet meters g site: feet meters	ate Of Compliance/Occupancy Issued
A community official completed Section E for a The following information (Items G4-G9) is proved.  A Permit Number  This permit has been issued for:  Elevation of as-built lowest floor (including basemer BFE or (in Zone AO) depth of flooding at the building). Community's design flood elevation	building located in Zone A (without a FEMA-issued of vided for community floodplain management purpose nit Issued 12/7/09 G6. Date Certification Substantial Improvement nt) of the building: feet meters g site: feet meters	ate Of Compliance/Occupancy Issued    Compliance   Occupancy Issued   Occupancy Issued
A community official completed Section E for a The following information (Items G4-G9) is production.  4. Permit Number G5. Date Permit New Constitution of as-built lowest floor (including basemer BFE or (in Zone AO) depth of flooding at the building call Official's Name	building located in Zone A (without a FEMA-issued of vided for community floodplain management purpose nit Issued 12/7/09 G6. Date Certificator truction Substantial Improvement nit) of the building: feet meters g site: feet meters	ate Of Compliance/Occupancy Issued  72110  s (PR) Datum s (PR) Datum
A community official completed Section E for a  The following information (Items G4-G9) is produced.  Permit Number  G5. Date Permit Number	building located in Zone A (without a FEMA-issued of vided for community floodplain management purpose nit Issued 12/7/09  G6. Date Certificator of truction Substantial Improvement substantial Impro	ate Of Compliance/Occupancy Issued    Compliance   Occupancy Issued   Occupancy Issued

Replaces all previous editions

FEMA Form 81-31, Mar 09

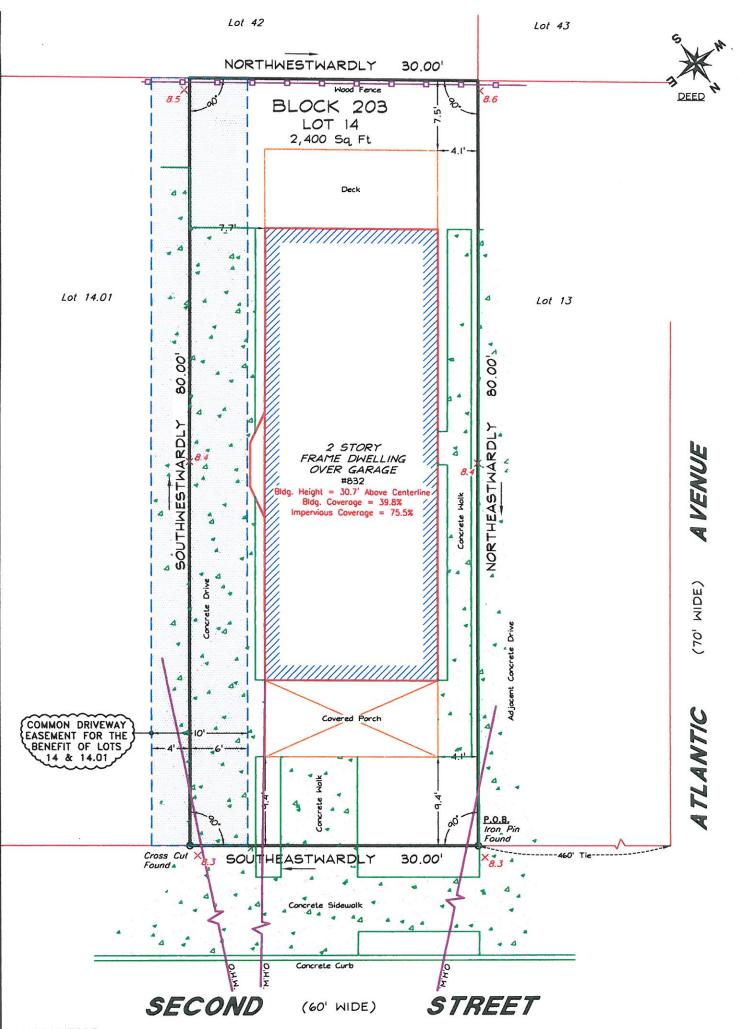

## REFERENCE:

ROJNO 12172

Added Elevations ..... 7-07-10

- -P.I.Q. DEED BOOK 2756, PAGE 744.
- -STEPHEN C. MARTINELLI LAND SURVEYING L.L.C. RESERVES THE RIGHT TO AMEND THIS SURVEY UPON RECEIPT OF A CURRENT ACCURATE TITLE REPORT.

THE ORIGINAL OF THIS DRAWING IS THE PROPERTY OF STEPHEN C. MARTINELLI LAND SURVEYING L.L.C.

ONLY COPIES FROM THE ORIGINAL MAP OF THIS PLAT, CLEARLY MARKED WITH THE LAND SURVEYOR'S EMBOSSED SEAL SHALL BE CONSIDERED TO BE VALID.

SCALE: |" = 10 FINAL SURVEY DATE: 7-01-10 SITUATE IN BLOCK 203 LOT 14
CITY OF OCEAN CITY
CAPE MAY CO., NJ DRAWN BY RM

LAND SURVEYING L.L.C. PLANNING

PHONE: (609) 390-9618 FAX: (609) 390-9534 1217 S. SHORE ROAD, SUITE 106 PALERMO, NEW JERSEY 08230

