

ELEVATION CERTIFICATE

Important: Read the instructions on pages 1-7.

SECTION A - PROPERTY OWNER INFORMATION		For Insurance Company Use:	
BUILDING OWNER'S NAME		Policy Number	
BUILDING STREET ADDRESS (Including Apt., Unit, Suite, and/or Bldg. No.) CR P.C. ROUTE AND BOX NO. 257-59 261-263 ASBURY AVE		Company NAIC Number	
CITY OCEAN CITY	STATE NJ	ZIP CODE	
PROPERTY DESCRIPTION (Lot and Block Numbers, Tax Parcel Number, Legal Description, etc.) TAX MAP 01 Block 21			
BUILDING USE (e.g., Residential, Non-residential, Accessory, etc.) Use Comments section if necessary. REGISTRATION			
LATITUDE/LONGITUDE (OPTIONAL)		HORIZONTAL DATUM SOURCE	
(2-23-23 or 2-23-23)		☐ GPS (Type): ☐ NAD 1927 ☐ NAD 1983 ☐ USGS Quad Map ☐ Other	

SECTION B - FLOOD INSURANCE RATE MAP (FIRM) INFORMATION

B1. NFIP COMMUNITY NAME & COMMUNITY NUMBER OCEAN CITY 345310		B2. COUNTY NAME CAPE MAY	B3. STATE NJ
B4. MAP AND PANE NUMBER 0001	B5. SUFFIX C	B6. FIRM INDEX DATE 7.15.92	B7. FIRM PANE EFFECTIVE/REVISED DATE 9/5/84
B8. FLOOD ZONE(S) A7		B9. BASE FLOOD ELEVATION(S) (Zone A0, use depth of flooding) 9 EIGV	

B10. Indicate the source of the Base Flood Elevation (BFE) data or base flood depth entered in B9.

☐ FIS Profile ☒ FIRM ☐ Community Determined ☐ Other (Describe):B11. Indicate the elevation datum used for the BFE in B9: ☒ NGVD 1929 ☐ NAVD 1988 ☐ Other (Describe):B12. Is the building located in a Coastal Barrier Resources System (CBRS) area or Otherwise Protected Area (OPA)? ☐ Yes ☒ No
Designation Date: NA

SECTION C - BUILDING ELEVATION INFORMATION (SURVEY REQUIRED)

C1. Building elevations are based on: ☐ Construction Drawings ☐ Building Under Construction ☒ Finished Construction
*A new Elevation Certificate will be required when construction of the building is complete.

C2. Building Diagram Number 8 (Select the building diagram most similar to the building for which this certificate is being completed - see pages 6 and 7. If no diagram accurately represents the building, provide a sketch or photograph.)

C3. Elevations - Zones A1-A30, AE, AH, A (with BFE), VE, V1-V30, V (with BFE), AR, AR/A, AR/AE, AR/A1-A30, AR/AH, AR/AO
Complete items C3a-i below according to the building diagram specified in item C2. State the datum used. If the datum is different from the datum used for the BFE in Section B, convert the datum to that used for the BFE. Show field measurements and datum conversion calculation. Use the space provided or the Comments area of Section D or Section G, as appropriate, to document the datum conversion.
Datum NGVD 2-9 Conversion/Comments NONE

Elevation reference mark used: RM 1 Does the elevation reference mark used appear on the FIRM? ☒ Yes ☐ No

☐ a) Top of bottom floor (including basement or enclosure)	<u>6.3</u> (ft)(m)
☐ b) Top of next higher floor	<u>11.1</u> (ft)(m)
☐ c) Bottom of lowest horizontal structural member (V zones only)	<u>NA</u> ft(m)
☐ d) Attached garage (top of slab)	<u>6.3</u> (ft)(m)
☐ e) Lowest elevation of machinery and/or equipment servicing the building	<u>11.0</u> (ft)(m)
☐ f) Lowest adjacent grade (LAG)	<u>6.1</u> (ft)(m)
☐ g) Highest adjacent grade (HAG)	<u>6.3</u> (ft)(m)
☐ h) No. of permanent openings (flood vents) within 1 ft. above adjacent grade	<u>6</u>
☐ i) Total area of all permanent openings (flood vents) in C3h	<u>1860</u> sq. in. (sq. cm)

License Number, Embossed Seal, Signature, and Date

SECTION D - SURVEYOR, ENGINEER, OR ARCHITECT CERTIFICATION

This certification is to be signed and sealed by a land surveyor, engineer, or architect authorized by law to certify elevation information.
I certify that the information in Sections A, B, and C on this certificate represents my best efforts to interpret the data available.
I understand that any false statement may be punishable by fine or imprisonment under 18 U.S. Code, Section 1001.

CERTIFIER'S NAME	THOMAS P. KARR	LICENSE NUMBER	63 31269
TITLE	LAND SURVEYOR (OWNER)	COMPANY NAME	KARR LAND SURVEYING
ADDRESS	35C S. JHOZE RD.	CITY	MARMORA
		STATE	NJ
		ZIP CODE	08223
SIGNATURE	Thomas P. Karr	DATE	12/18/00
		TELEPHONE	609-390-7736

IMPORTANT: In these spaces, copy the corresponding information from Section A.		For Insurance Company Use:
BUILDING STREET ADDRESS (Including Apt., Unit, Suite, and/or Bldg. No.) OR P.O. ROUTE AND BOX NO. 261-263 ASBURY AVE		Policy Number
CITY: OCEAN CITY NJ	STATE: NJ	Company NAIC Number
ZIP CODE: 08226		

SECTION D - SURVEYOR, ENGINEER, OR ARCHITECT CERTIFICATION (CONTINUED)

Copy both sides of this Elevation Certificate for (1) community official, (2) insurance agent/company, and (3) building owner.

COMMENTS

☐ Check here if attachments

SECTION E - BUILDING ELEVATION INFORMATION (SURVEY NOT REQUIRED) FOR ZONE AO AND ZONE A (WITHOUT BFE)

For Zone AO and Zone A (without BFE), complete Items E1. through E4. If the Elevation Certificate is intended for use as supporting information for a LOMA or LOMR-F, Section C must be completed.

- E1. Building Diagram Number _____ (Select the building diagram most similar to the building for which this certificate is being completed - see pages 6 and 7. If no diagram accurately represents the building, provide a sketch or photograph.)
- E2. The top of the bottom floor (including basement or enclosure) of the building is _____ ft.(m) _____ in.(cm) _____ above or _____ below (check one) the highest adjacent grade. (Use natural grade, if available.)
- E3. For Building Diagrams 6-8 with openings (see page 7), the next higher floor or elevated floor (elevation b) of the building is _____ ft.(m) _____ in.(cm) above the highest adjacent grade. Complete Items C3.h and C3.i on front of form.
- E4. For Zone AO only: If no flood depth number is available, is the top of the bottom floor elevated in accordance with the community's floodplain management ordinance? ☐ Yes ☐ No ☐ Unknown. The local official must certify this information in Section G.

SECTION F - PROPERTY OWNER (OR OWNER'S REPRESENTATIVE) CERTIFICATION

The property owner or owner's authorized representative who completes Sections A, B, C (Items C3.h and C3.i only), and E for Zone A (without a FEMA-issued or community-issued BFE) or Zone AO must sign here. The statements in Sections A, B, C, and E are correct to the best of my knowledge.

PROPERTY OWNER'S OR OWNER'S AUTHORIZED REPRESENTATIVE'S NAME			
ADDRESS	CITY	STATE	ZIP CODE
SIGNATURE	DATE	TELEPHONE	
COMMENTS			

☐ Check here if attachments

SECTION G - COMMUNITY INFORMATION (OPTIONAL)

The local official who is authorized by law or ordinance to administer the community's floodplain management ordinance can complete Sections A, B, C (or E), and G of this Elevation Certificate. Complete the applicable item(s) and sign below.


- G1. ☐ The information in Section C was taken from other documentation that has been signed and embossed by a licensed surveyor, engineer, or architect who is authorized by state or local law to certify elevation information. (Indicate the source and date of the elevation data in the Comments area below.)
- G2. ☐ A community official completed Section E for a building located in Zone A (without a FEMA-issued or community-issued BFE) or Zone AO.
- G3. ☐ The following information (Items G4-G9) is provided for community floodplain management purposes.

G4. PERMIT NUMBER 00-1278	G5. DATE PERMIT ISSUED 8/8/00	G6. DATE CERTIFICATE OF COMPLIANCE/OCCUPANCY ISSUED 1/2/01
G7. This permit has been issued for: ☐ New Construction ☐ Substantial Improvement		
G8. Elevation of as-built lowest floor (including basement) of the building is: _____ ft.(m) Datum: _____		
G9. BFE or (in Zone AO) depth of flooding at the building site is: _____ ft.(m) Datum: _____		
LOCAL OFFICIAL'S NAME	TITLE	
COMMUNITY NAME	TELEPHONE	
SIGNATURE	DATE	
COMMENTS		

☐ Check here if attachments

Dec 23 11 50 AM '68

A hand-drawn compass rose with eight directions labeled: N, NE, E, SE, S, SW, W, NW. A shaded wedge points towards the NW direction, labeled "NORTH (MAGNETIC)".

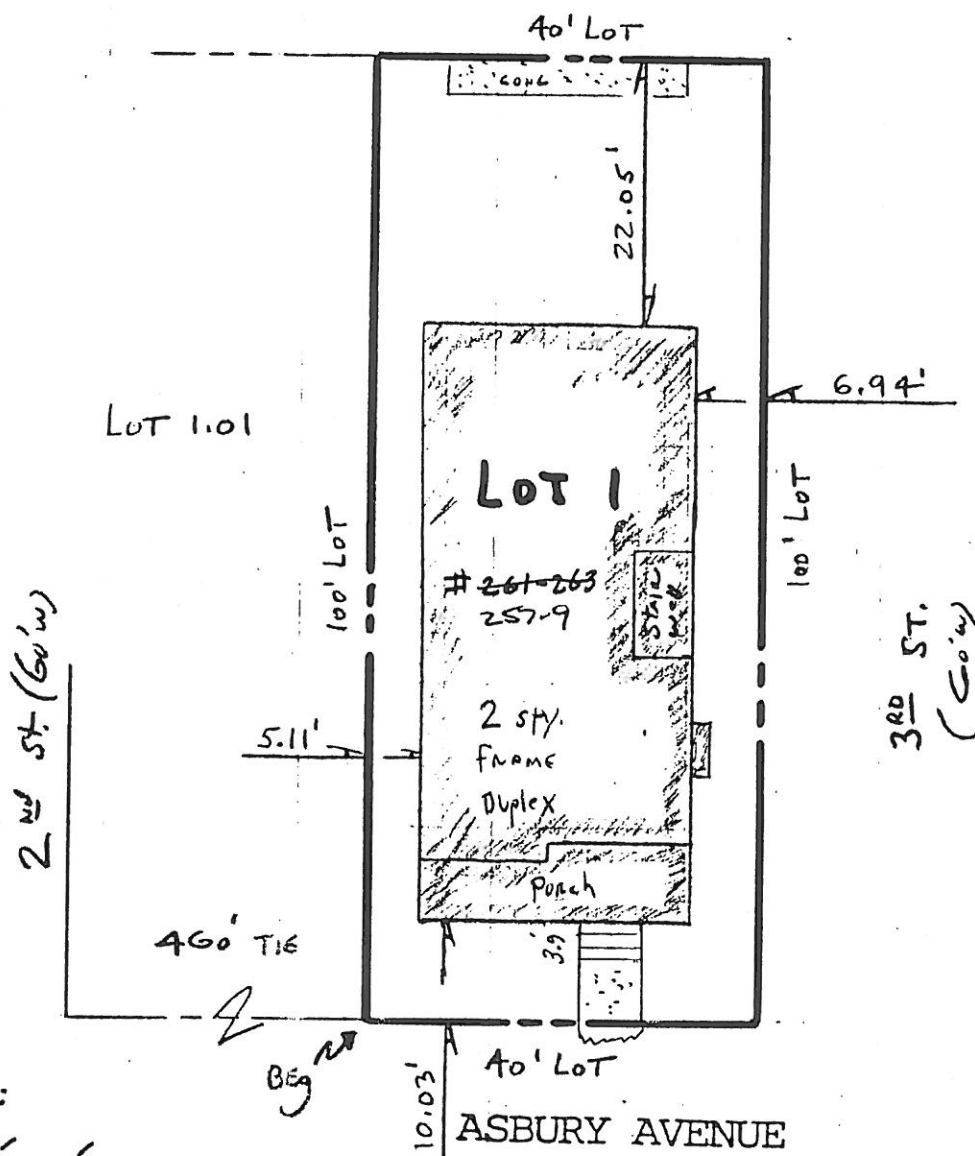

40' X 100' LOT

ELEV ARE NGVD'29

ASBURY 613

DIFF 30.63 feet

LIMIT OF FOUNDATION 36.50 %
BLDG PORCHES AND CONC 47.04 %

FINAL ASBUILT

KARR  LAND SURVEYING		PLAN OF SURVEY	
P.O. BOX 89 OCEANVIEW, N.J. 08230		BLOCK <u>210</u>	LOT <u>1</u>
PHONE 609 390 7936 FAX 390 7937		OCEAN CITY	
THOMAS P. KARR NJ PROFESSIONAL LAND SURVEYOR NJ SURVEYORS LICENSE # 31269		COUNTY OF <u>Cape May</u>	
location: route 9 MARLORA NJ		NEW JERSEY	
TYPE THREE SURVEY		DATE OF PLAN	Drawn By <u>JK</u>
THIS IS NOT AN ALTA STANDARD SURVEY		<u>12/18/00</u>	Chk'd By <u>JK</u>
REVISIONS	Date	SCALE	1" = 20'.....
		PROJECT NO.	<u>00213</u>