

FEDERAL EMERGENCY MANAGEMENT AGENCY
NATIONAL FLOOD INSURANCE PROGRAM

O.M.B. No. 3067-0077
Expires July 31, 2002

ELEVATION CERTIFICATE

Important: Read the Instructions on pages 1 - 7.

SECTION A - PROPERTY OWNER INFORMATION

BUILDING OWNER'S NAME		For Insurance Company Use:	
BUILDING STREET ADDRESS (Including Apt., Unit, Suite, and/or Bldg. No.) OR P.O. ROUTE AND BOX NO. 249 - 251 ASDUNY AVE		Policy Number	
CITY OCEAN CITY	STATE NJ	Company NAIC Number	
PROPERTY DESCRIPTION (Lot and Block Numbers, Tax Parcel Number, Legal Description, etc.) TAX MAP LOT 2 Block 210		ZIP CODE 08226	
BUILDING USE (e.g., Residential, Non-Residential, Addition, Accessory, etc. Use a Comments area, if necessary.) RESIDENTIAL			
LATITUDE/LONGITUDE (OPTIONAL) (##°-##'-###" or ##°###'")		HORIZONTAL DATUM: SOURCE: ☐ GPS (Type): ☐ NAD 1927 ☐ NAD 1983 ☐ USGS Quad Map ☐ Other:	

SECTION B - FLOOD INSURANCE RATE MAP (FIRM) INFORMATION

B1. NFIP COMMUNITY NAME & COMMUNITY NUMBER OCEAN CITY 345310		B2. COUNTY NAME CAPE MAY		B3. STATE NJ	
B4. MAP AND PANEL NUMBER 0001	B5. SUFFIX C	B6. FIRM INDEX DATE 7.15.92	B7. FIRM PANEL EFFECTIVE/REVISED DATE 9/5/84	B8. FLOOD ZONE(S) A7	B9. BASE FLOOD ELEVATION(S) (Zone AO, use depth of flooding) NINE ELE

B10. Indicate the source of the Base Flood Elevation (BFE) data or base flood depth entered in B9.
☐ FIS Profile ☐ FIRM ☐ Community Determined ☐ Other (Describe):

B11. Indicate the elevation datum used for the BFE in B9: ☐ NGVD 1929 ☐ NAVD 1988 ☐ Other (Describe):

B12. Is the building located in a Coastal Barrier Resources System (CBRS) area or Otherwise Protected Area (OPA)? ☐ Yes ☒ No
Designation Date:

SECTION C - BUILDING ELEVATION INFORMATION (SURVEY REQUIRED)

C1. Building elevations are based on: ☐ Construction Drawings* ☐ Building Under Construction* ☒ Finished Construction
*A new Elevation Certificate will be required when construction of the building is complete.

C2. Building Diagram Number 8 (Select the building diagram most similar to the building for which this certificate is being completed - see pages 6 and 7. If no diagram accurately represents the building, provide a sketch or photograph.)

C3. Elevations - Zones A1-A30, AE, AH, A (with BFE), VE, V1-V30, V (with BFE), AR, AR/A, AR/AE, AR/A1-A30, AR/AH, AR/AO
Complete Items C3.a-i below according to the building diagram specified in Item C2. State the datum used. If the datum is different from the datum used for the BFE in Section B, convert the datum to that used for the BFE. Show field measurements and datum conversion calculation. Use the space provided or the Comments area of Section D or Section G, as appropriate, to document the datum conversion.
Datum NAVD Conversion/Comments

Elevation reference mark used RM 1 Does the elevation reference mark used appear on the FIRM? ☒ Yes ☐ No

☐ a) Top of bottom floor (including basement or enclosure)	<u>6.52</u> ft(m)
☐ b) Top of next higher floor	<u>11.42</u> ft(m)
☐ c) Bottom of lowest horizontal structural member (V zones only)	<u>NA</u> ft(m)
☐ d) Attached garage (top of slab)	<u>6.52</u> ft(m)
☐ e) Lowest elevation of machinery and/or equipment servicing the building (Describe in a Comments area.)	<u>11.60</u> ft(m)
☐ f) Lowest adjacent (finished) grade (LAG)	<u>6.2</u> ft(m)
☐ g) Highest adjacent (finished) grade (HAG)	<u>6.5</u> ft(m)
☐ h) No. of permanent openings (flood vents) within 1 ft. above adjacent grade	<u>6</u>
☐ i) Total area of all permanent openings (flood vents) in C3.h	<u>1788</u> sq. in. (sq. cm)

License Number, Embossed Seal, Signature, and Date

SECTION D - SURVEYOR, ENGINEER, OR ARCHITECT CERTIFICATION

This certification is to be signed and sealed by a land surveyor, engineer, or architect authorized by law to certify elevation information.
I certify that the information in Sections A, B, and C on this certificate represents my best efforts to interpret the data available.
I understand that any false statement may be punishable by fine or imprisonment under 18 U.S. Code, Section 1001.

CERTIFIER'S NAME Thomas P. KARR KARR LAND SURVEYING LICENSE NUMBER GS 31269

TITLE Prof. LAND SURVEYOR COMPANY NAME

ADDRESS PO BOX 89 CITY OCEAN CITY STATE NJ ZIP CODE 08230

SIGNATURE Thomas P. Karr DATE 4/16/01 TELEPHONE 609 390 7936

BUILDING STREET ADDRESS (Including, if, Unit, Suite, and/or Bldg. No.) OR P.O. ROUTE AND BOX NO. 249-251 Asbury Ave		Policy Number
CITY OCEAN CITY	STATE NJ	Company, NAIC Number
ZIP CODE 08226		

SECTION D - SURVEYOR, ENGINEER, OR ARCHITECT CERTIFICATION (CONTINUED)

Copy both sides of this Elevation Certificate for (1) community official, (2) insurance agent/company, and (3) building owner.

COMMENTS

SECTION E - BUILDING ELEVATION INFORMATION (SURVEY NOT REQUIRED) FOR ZONE AO AND ZONE A (WITHOUT BFE)

For Zone AO and Zone A (without BFE), complete Items E1. through E4. If the Elevation Certificate is intended for use as supporting information for a LCMA or LCMR-F, Section C must be completed.

- E1. Building Diagram Number ____ (Select the building diagram most similar to the building for which this certificate is being completed - see page 15 and 16. If no diagram accurately represents the building, provide a sketch or photograph.)
- E2. The top of the bottom floor (including basement or enclosure) of the building is ____ ft(m) ____ in(cm) ____ above or ____ below (check one) the highest adjacent grade. (Use natural grade, if available.)
- E3. For Building Diagrams 8-9 with openings (see page 16), the next higher finished floor (elevation b) of the building is ____ ft(m) ____ in(cm) above the highest adjacent grade. Complete Items C1h and C1i on front of form.
- E4. For Zone AO only, if no flood depth number is available, is the top of the bottom floor elevated in accordance with the community's floodplain management ordinances? ☐ Yes ☐ No ☐ Unknown. The local official must certify this information in Section G.

SECTION F - PROPERTY OWNER (OR OWNER'S REPRESENTATIVE) CERTIFICATION

The property owner or owner's authorized representative who completes Sections A, B, C (Items C1h and C1i only), and E for Zone A (without a FEMA-issued or community-issued BFE) or Zone AO must sign here. The statements in Sections A, B, C, and E are correct to the best of my knowledge.

PROPERTY OWNER'S OR OWNER'S AUTHORIZED REPRESENTATIVE'S NAME

ADDRESS	CITY	STATE	ZIP CODE
SIGNATURE	DATE	TELEPHONE	
COMMENTS			

SECTION G - COMMUNITY INFORMATION (OPTIONAL)

The local official who is authorized by law or ordinance to administer the community's floodplain management ordinance can complete Sections A, B, C (or E), and G of this Elevation Certificate. Complete the applicable item(s) and sign below.

- G1. ☐ The information in Section C was taken from other documentation that has been signed and endorsed by a licensed surveyor, engineer, or architect who is authorized by state or local law to certify elevation information. (Indicate the source and date of the elevation data in the Comments area below.)
- G2. ☐ A community official completed Section E for a building located in Zone A (without a FEMA-issued or community-issued BFE) or Zone AO.
- G3. ☐ The following information (Items G4-G9) is provided for community floodplain management purposes:

G4. PERMIT NUMBER 01-2169 01-2170	G5. DATE PERMIT ISSUED 12/7/00	G6. DATE CERTIFICATE OF COMPLIANCE/OCCUPANCY ISSUED 4/25/01
---	--	---


G7. This permit has been issued for: ☐ New Construction ☐ Substantial Improvement

G8. Elevation of as-built lowest floor (including basement) of the building is: ____ ft(m) Datum: ____

G9. BFE or (in Zone AO) depth of flooding at the building site is: ____ ft(m) Datum: ____

LOCAL OFFICIAL'S NAME	TITLE
COMMUNITY NAME	TELEPHONE
SIGNATURE	DATE
COMMENTS	

PUBLIC ALLEY (15'W)

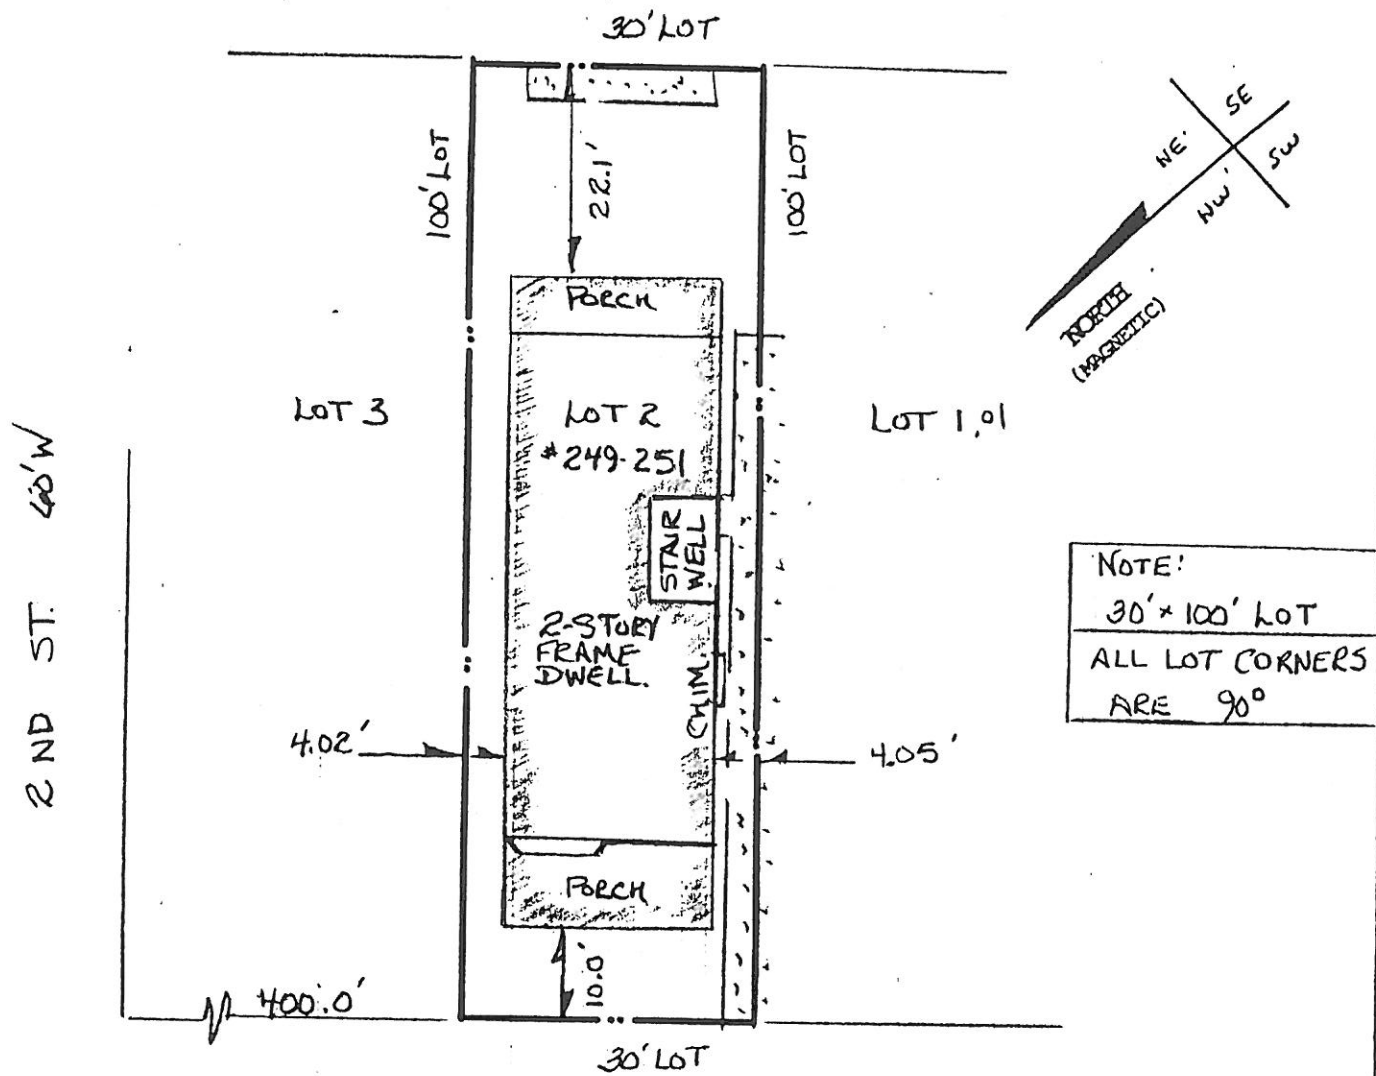

ASBURY AVENUE (65 feet wide)

ELEV'S ARE NGVD '29	
ROOF ELEV.	36.12
& ASBURY ELEV.	6.01
DIFF.	30.11

TOTAL LOT AREA: 3000 SF
LIMIT OF FOUNDATION 37.15 %
BLDG PORCHES AND CONC 57.73 %

FINAL ASBUILT

KARR LAND SURVEYING mailing address → R.O. BOX 89 OCEANVIEW N.J. 08230 PHONE 609 390 7936 FAX 390 7937 THOMAS P. KARR NJ PROFESSIONAL LAND SURVEYOR NJ SURVEYORS LICENSE # 31269 location: route 9 MARLORA NJ		PLAN OF SURVEY BLOCK# 210 LOT# 2 OCEAN CITY COUNTY OF CAPE MAY NEW JERSEY TYPE THREE SURVEY THIS IS NOT AN ALTA STANDARD SURVEY REVISIONS DATE OF PLAN 2-07-01 Drawn By JC Ch'd. By SCALE 1" = 20' PROJECT NO. 94115	
---	--	--	--