

ELEVATION CERTIFICATE

Expires May 31, 1996

FEDERAL EMERGENCY MANAGEMENT AGENCY
NATIONAL FLOOD INSURANCE PROGRAM

ATTENTION: Use of this certificate does not provide a waiver of the flood insurance purchase requirement. This form is used only to provide elevation information necessary to ensure compliance with applicable community floodplain management ordinances, to determine the proper insurance premium rate, and/or to support a request for a Letter of Map Amendment or Revision (LOMA or LOMR). Instructions for completing this form can be found on the following pages.

SECTION A PROPERTY INFORMATION		FOR INSURANCE COMPANY USE
BUILDING OWNER'S NAME		POLICY NUMBER
STREET ADDRESS (Including Apt., Unit, Suite and/or Bldg. Number) OR P.O. ROUTE AND BOX NUMBER 255-57 WEST AVENUE		COMPANY NAIC NUMBER
OTHER DESCRIPTION (Lot and Block Numbers, etc.) LOTS 2 AND 3 BLOCK 211 (TAX MAP)		
CITY (CAPE MAY COUNTY) OCEAN CITY	STATE N.J.	ZIP CODE 08226

SECTION B FLOOD INSURANCE RATE MAP (FIRM) INFORMATION

Provide the following from the proper FIRM (See Instructions):

1. COMMUNITY NUMBER 345310	2. PANEL NUMBER 0001	3. SUFFIX C	4. DATE OF FIRM INDEX 9/05/84	5. FIRM ZONE A7	6. BASE FLOOD ELEVATION (in AO Zones, use depth) EL. 9
-------------------------------	-------------------------	----------------	----------------------------------	--------------------	--

7. Indicate the elevation datum system used on the FIRM for Base Flood Elevations (BFE): ☒ NGVD '29 ☐ Other (describe on back)
8. For Zones A or V, where no BFE is provided on the FIRM, and the community has established a BFE for this building site, indicate the community's BFE: feet NGVD (or other FIRM datum—see Section B, Item 7).

SECTION C BUILDING ELEVATION INFORMATION

1. Using the Elevation Certificate Instructions, indicate the diagram number from the diagrams found on Pages 5 and 6 that best describes the subject building's reference level 8.
- 2(a). FIRM Zones A1-A30, AE, AH, and A (with BFE). The top of the reference level floor from the selected diagram is at an elevation of 0|0|0|9 feet NGVD (or other FIRM datum—see Section B, Item 7).
- (b). FIRM Zones V1-V30, VE, and V (with BFE). The bottom of the lowest horizontal structural member of the reference level from the selected diagram, is at an elevation of feet NGVD (or other FIRM datum—see Section B, Item 7).
- (c). FIRM Zone A (without BFE). The floor used as the reference level from the selected diagram is feet above ☐ or below ☐ (check one) the highest grade adjacent to the building.
- (d). FIRM Zone AO. The floor used as the reference level from the selected diagram is feet above ☐ or below ☐ (check one) the highest grade adjacent to the building. If no flood depth number is available, is the building's lowest floor (reference level) elevated in accordance with the community's floodplain management ordinance? ☐ Yes ☐ No ☐ Unknown
3. Indicate the elevation datum system used in determining the above reference level elevations: ☒ NGVD '29 ☐ Other (describe under Comments on Page 2). (NOTE: If the elevation datum used in measuring the elevations is different than that used on the FIRM [see Section B, Item 7], then convert the elevations to the datum system used on the FIRM and show the conversion equation under Comments on Page 2.)
4. Elevation reference mark used appears on FIRM: ☒ Yes ☐ No (See Instructions on Page 4)
5. The reference level elevation is based on: ☒ actual construction ☐ construction drawings
(NOTE: Use of construction drawings is only valid if the building does not yet have the reference level floor in place, in which case this certificate will only be valid for the building during the course of construction. A post-construction Elevation Certificate will be required once construction is complete.)
6. The elevation of the lowest grade immediately adjacent to the building is: 0|0|0|5 feet NGVD (or other FIRM datum—see Section B, Item 7).

SECTION D COMMUNITY INFORMATION

1. If the community official responsible for verifying building elevations specifies that the reference level indicated in Section C, Item 1 is not the "lowest floor" as defined in the community's floodplain management ordinance, the elevation of the building's "lowest floor" as defined by the ordinance is: feet NGVD (or other FIRM datum—see Section B, Item 7).
2. Date of the start of construction or substantial improvement _____.

SECTION E CERTIFICATION


This certification is to be signed by a land surveyor, engineer, or architect who is authorized by state or local law to certify elevation information when the elevation information for Zones A1-A30, AE, A1, A (with BFE), V1-V30, VE, and V (with BFE) is required. Community officials who are authorized by local law or ordinance to provide floodplain management information, may also sign the certification. In the case of Zones AO and A (without a FEMA or community issued BFE), a building official, a property owner, or an owner's representative may also sign the certification.

Reference level diagrams G, 7 and 8 - Distinguishing Features-If the certifier is unable to certify to breakaway/non-breakaway wall, enclosure size, location of servicing equipment, non use, wall openings, or unfinished area Feature(s), then list the Feature(s) not included in the certification under Comments below. The diagram number, Section C, Item 1, must still be entered.

I certify that the information in Sections B and C on this certificate represents my best efforts to interpret the data available. I understand that any false statement may be punishable by fine or imprisonment under 18 U.S. Code, Section 1001.

CERTIFIER'S NAME _____ LICENSE NUMBER (or Affiliant) _____
 TITLE THOMAS P. KARR _____ 31269
 COMPANY NAME _____
 ADDRESS PROFESSIONAL LAND SURVEYOR _____ KARR LAND SURVEYING
 CITY P.O. BOX 89 _____ STATE N.J. ZIP 08230
 SIGNATURE [Signature] _____ DATE 9/7/97 _____ PHONE 609-390-7936
 Copies should be made of this Certificate for: 1) community official, 2) insurance agent, company, and 3) building owner.

COMMENTS: _____

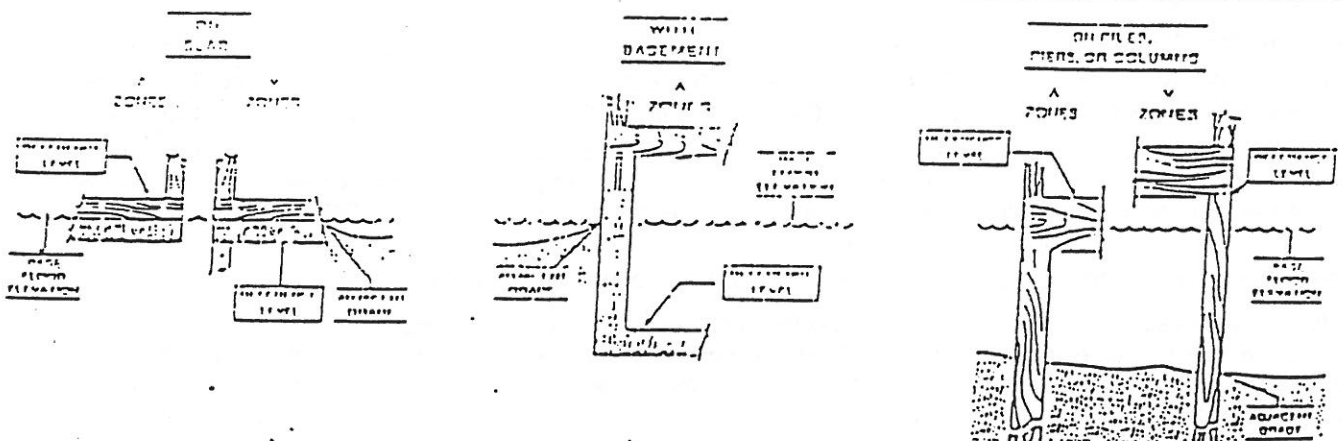

The diagrams above illustrate the points at which the elevations should be measured in A Zones and V Zones. Elevations for all A Zones should be measured at the top of the reference level floor. Elevations for all V Zones should be measured at the bottom of the lowest horizontal structural member.

CITY OF OCEAN CITY
CODE ENFORCEMENT

SEP 30 9 57 AM '97

TAX MAP North

15' W PUBLIC Alley

2nd Street (60'w)

LOT 4

LOTS 2 AND 3

1 story

COMM.

BUILDING

#255-257

LOT 1

NOTE:
Brick
Bldg on
ADJAC
LOT
CLEAN
0.1'

Tie 400'

(BEG)

60' LOT

WEST AVE.

(100'w)

OK.
Made
9/30/97

NOTE:

60' WIDE X 90' DEEP PROPERTY

ALL LOT CORNERS ARE 90°

ELEV ARE NGVD

Roof Peak ELEV 25.02

E WEST AVE ELEV 4.89

DIFF 20.13 Feet

FINAL / AS BUILT

PLAN OF SURVEY

BLOCK(S) 211

LOT(S) 2 AND 3

OCEAN CITY

COUNTY OF CAPE MAY

NEW JERSEY

TYPE THREE

Date 9.7.97

Drawn By: GES

Scale 1" = 20'

Chk'd By: TIK

REVISIONS

Date

PROJECT NO.

96379

KARR

LAND SURVEYING

P.O. BOX 89

OCEANVIEW, N.J. 08230

PHONE 609 390 7936

FAX 390 7937

Thomas P. Karr

THOMAS P. KARR

P.L.S. LICENSE NO. 31269