

VALLEY GAZETTE LEGAL NOTICES  
ATTEN VANESSA  
FAX 203 926 2092  
June 15, 2010

COPY RECEIVED  
DATE: 6/15/10  
TIME: 9:54 AM  
TOWN CLERK'S OFFICE

PLEASE PUBLISH THE FOLLOWING LEGAL NOTICE ON JUNE 23, 2010:


SEYMOUR PLANNING AND ZONING COMMISSION  
NOTICE OF DECISIONS

The following decisions were made and actions taken by the Seymour Planning and Zoning Commission at the regular meeting of June 10, 2010:

1. A change in the zoning classification of the property known as 755A South Main Street was changed from the present R-18 to the C-2 General Commercial District to be effective July 1, 2010. A map showing the area of the approved zone change is on file in the office of the Town Clerk.
2. A request to change the form of surety for the Bungay Terrace Estates Subdivision to conditional approval in lieu of final approval was approved.

MAP  
ATTACHED

SEYMOUR PLANNING AND ZONING COMMISSION  
Dan Della Volpe, Chairman

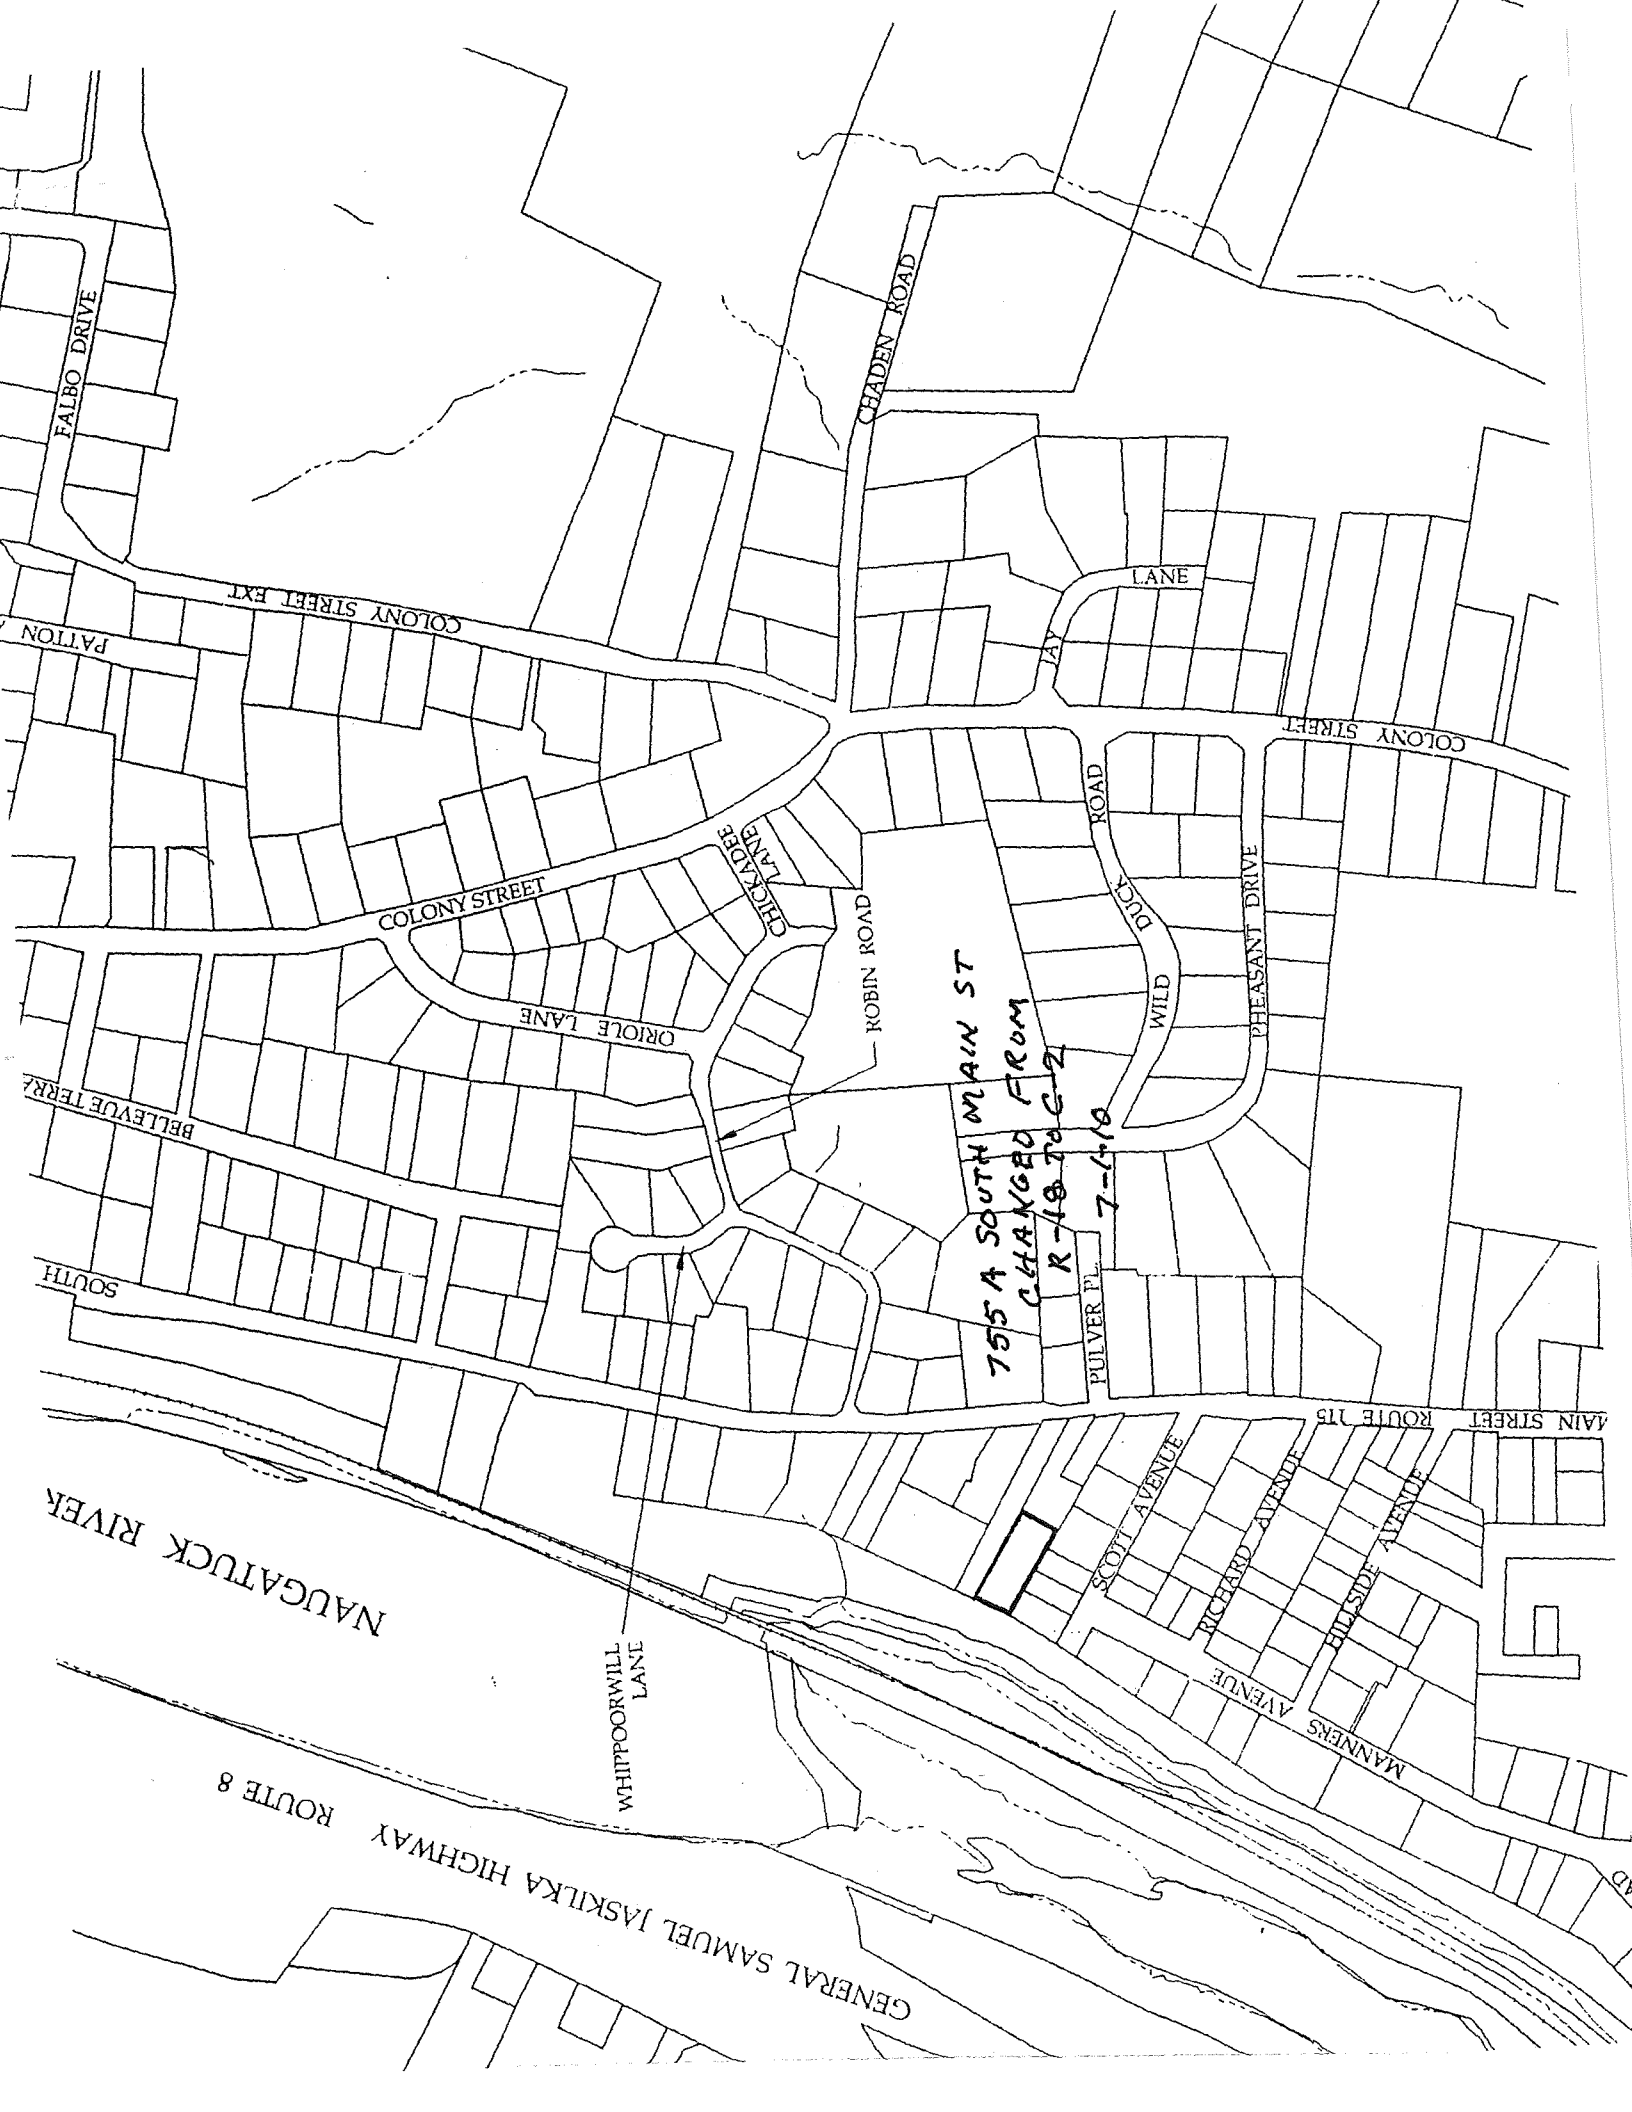

755 A SOUTH MAIN ST  
CHANGED FROM  
R-18 TO C-2

PULVER PL 7-410

NAUGATUCK RIVER

GENERAL SAMUEL JASKILKA HIGHWAY ROUTE 8