

COPY RECEIVED  
DATE: 12/17/08  
TIME: 9:15 AM  
TOWN CLERK'S OFFICE

VALLEY GAZETTE LEGAL NOTICES  
FAX 926 2092  
ATTEN DONNA  
December 17, 2008

PLEASE PUBLISH THE FOLLOWING LEGAL NOTICE **TWO TIMES**; PUBLISH THE FIRST NOTICE ON DECEMBER 24, 2008. PUBLISH THE SECOND NOTICE ON DECEMBER 31, 2008.


SEYMOUR PLANNING AND ZONING COMMISSION  
PUBLIC HEARING NOTICE

The Seymour Planning and Zoning Commission will hold a public hearing on an application to change the zoning classification of the property at 172 North Street from the present GI-2 General Industrial Zoning District to the proposed C-2 General Commercial Zoning District. The public hearing will be held on January 8, 2009 in the Norma Drummer Room, Seymour Town Hall starting at 7:15 PM. A map showing the area of the proposed zone map change is on file in the office of the Town Clerk.

COPY  
ATTACHED

SEYMOUR PLANNING AND ZONING COMMISSION  
Clifford Strumello, Jr., Chairman

DATE: 12/17/08  
9:15 AM

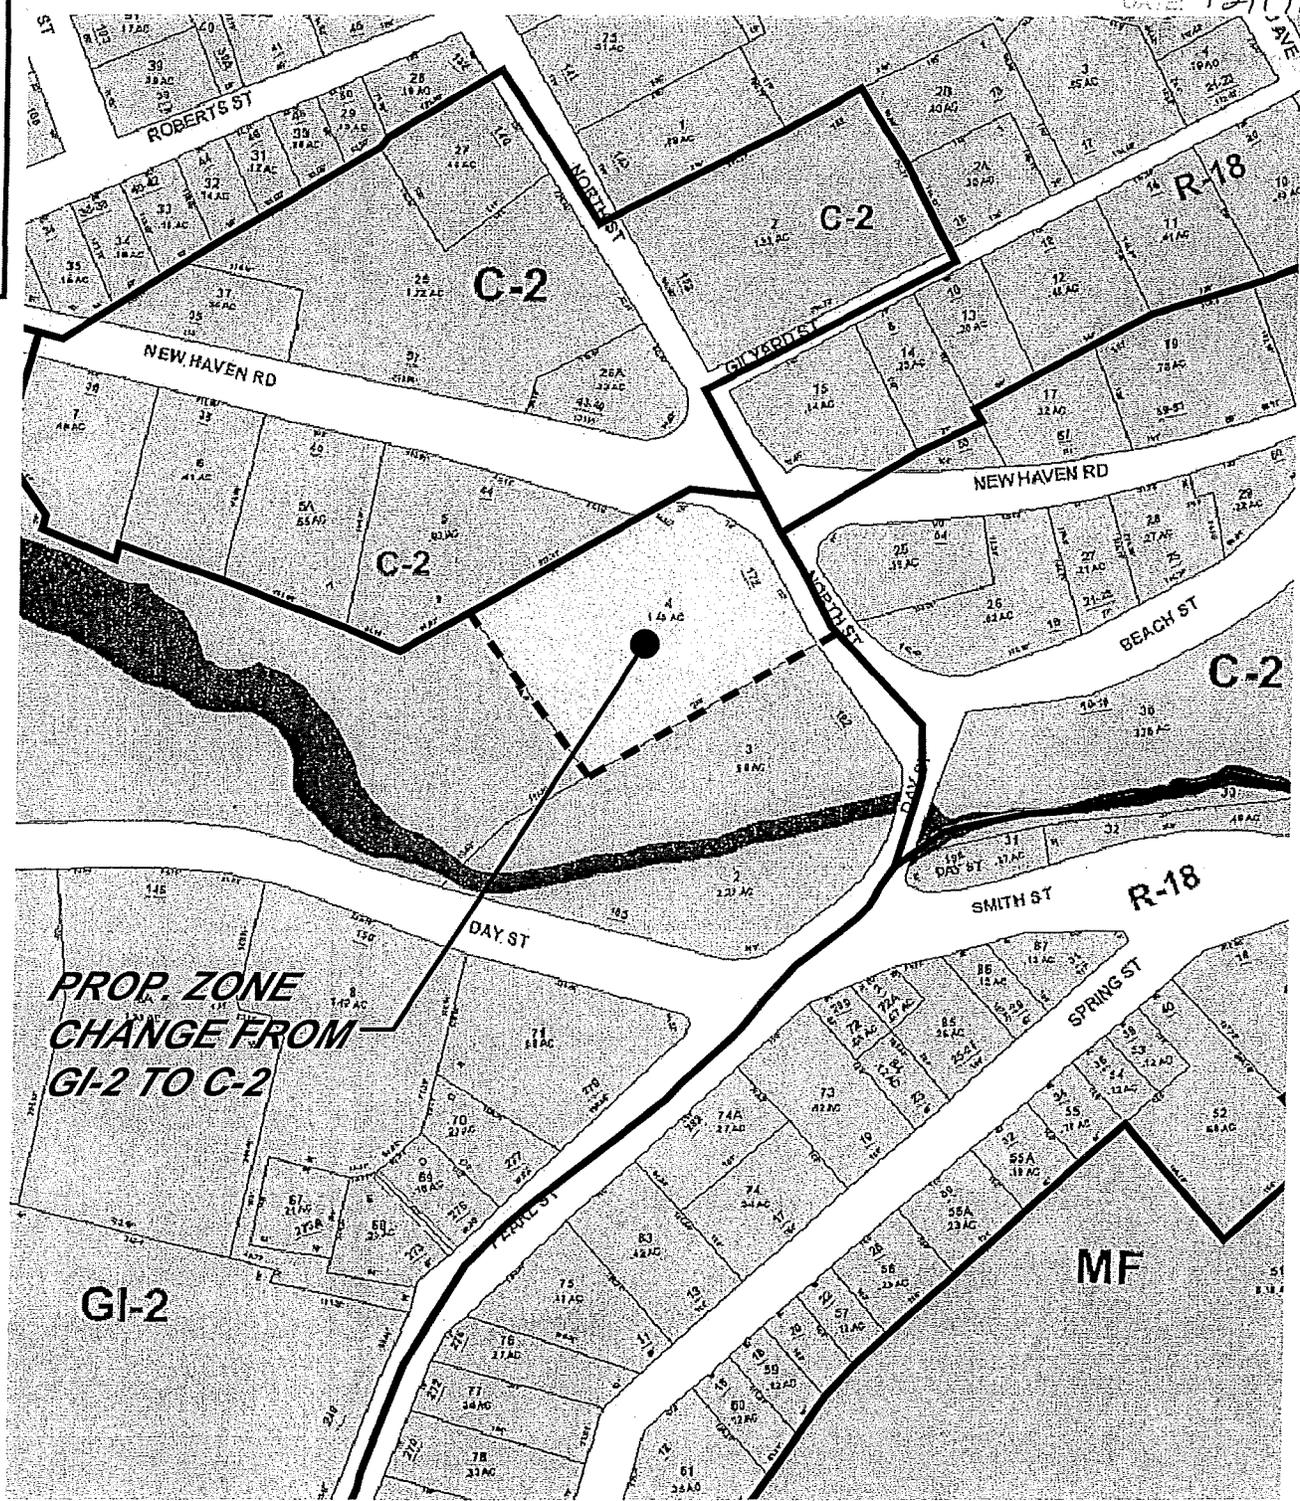

**PROP. ZONE  
CHANGE FROM  
GI-2 TO C-2**

1. MAP REFERENCE: Town of Seymour  
Geographic Information System (GIS),  
Date Printed: 01-Dec-2008

GRAPHIC SCALE:



REVISIONS		
NO.	DESCRIPTION	DATE

<b>PROP. ZONE CHANGE MAP</b>		Job No. 08-16
<b>NORTH 67 PLAZA VIADÉ DEVELOPMENT, LLC</b>		Scale: 1"=200'
172 NORTH STREET		Date: 12/1/08
SEYMOUR, CONNECTICUT		Designed: D.W.S.
DONALD W. SMITH, JR., P.E. CONSULTING ENGINEER		Drawn: K.D.K.
56 GREENWOOD CIRCLE SEYMOUR, CT. 888-4904		Sheet: 1 OF 1