

VOICES LEGAL NOTICES

FAX 201 262 6691

January 23, 2017

COPY RECEIVED  
DATE: 1/24/17  
TIME: 9:50 AM  
TOWN CLERK'S OFFICE

PLEASE PUBLISH THE FOLLOWING LEGAL NOTICE ON JANUARY 30, 2017

SEYMOUR PLANNING AND ZONING COMMISSION


NOTICE OF DECISIONS

The following decisions were made and actions taken by the Seymour Planning and Zoning Commission at a special meeting held on January 19, 2017:

1. A change in the zoning classification of the property at 30, 32 and 34 Smith Street from the present R-18 to the MF Multi Family residential district was approved to be effective February 15, 2017. A map showing the area of the zone change is on file with the Town Clerk: ATTACHED
2. A special permit for the conversion of the building at 34 Smith Street in to transitional housing and supportive services for six young adults under the ownership and control of the Seymour Housing Authority was approved.

SEYMOUR PLANNING AND ZONING COMMISSION

Joseph Ziehl, Chairman

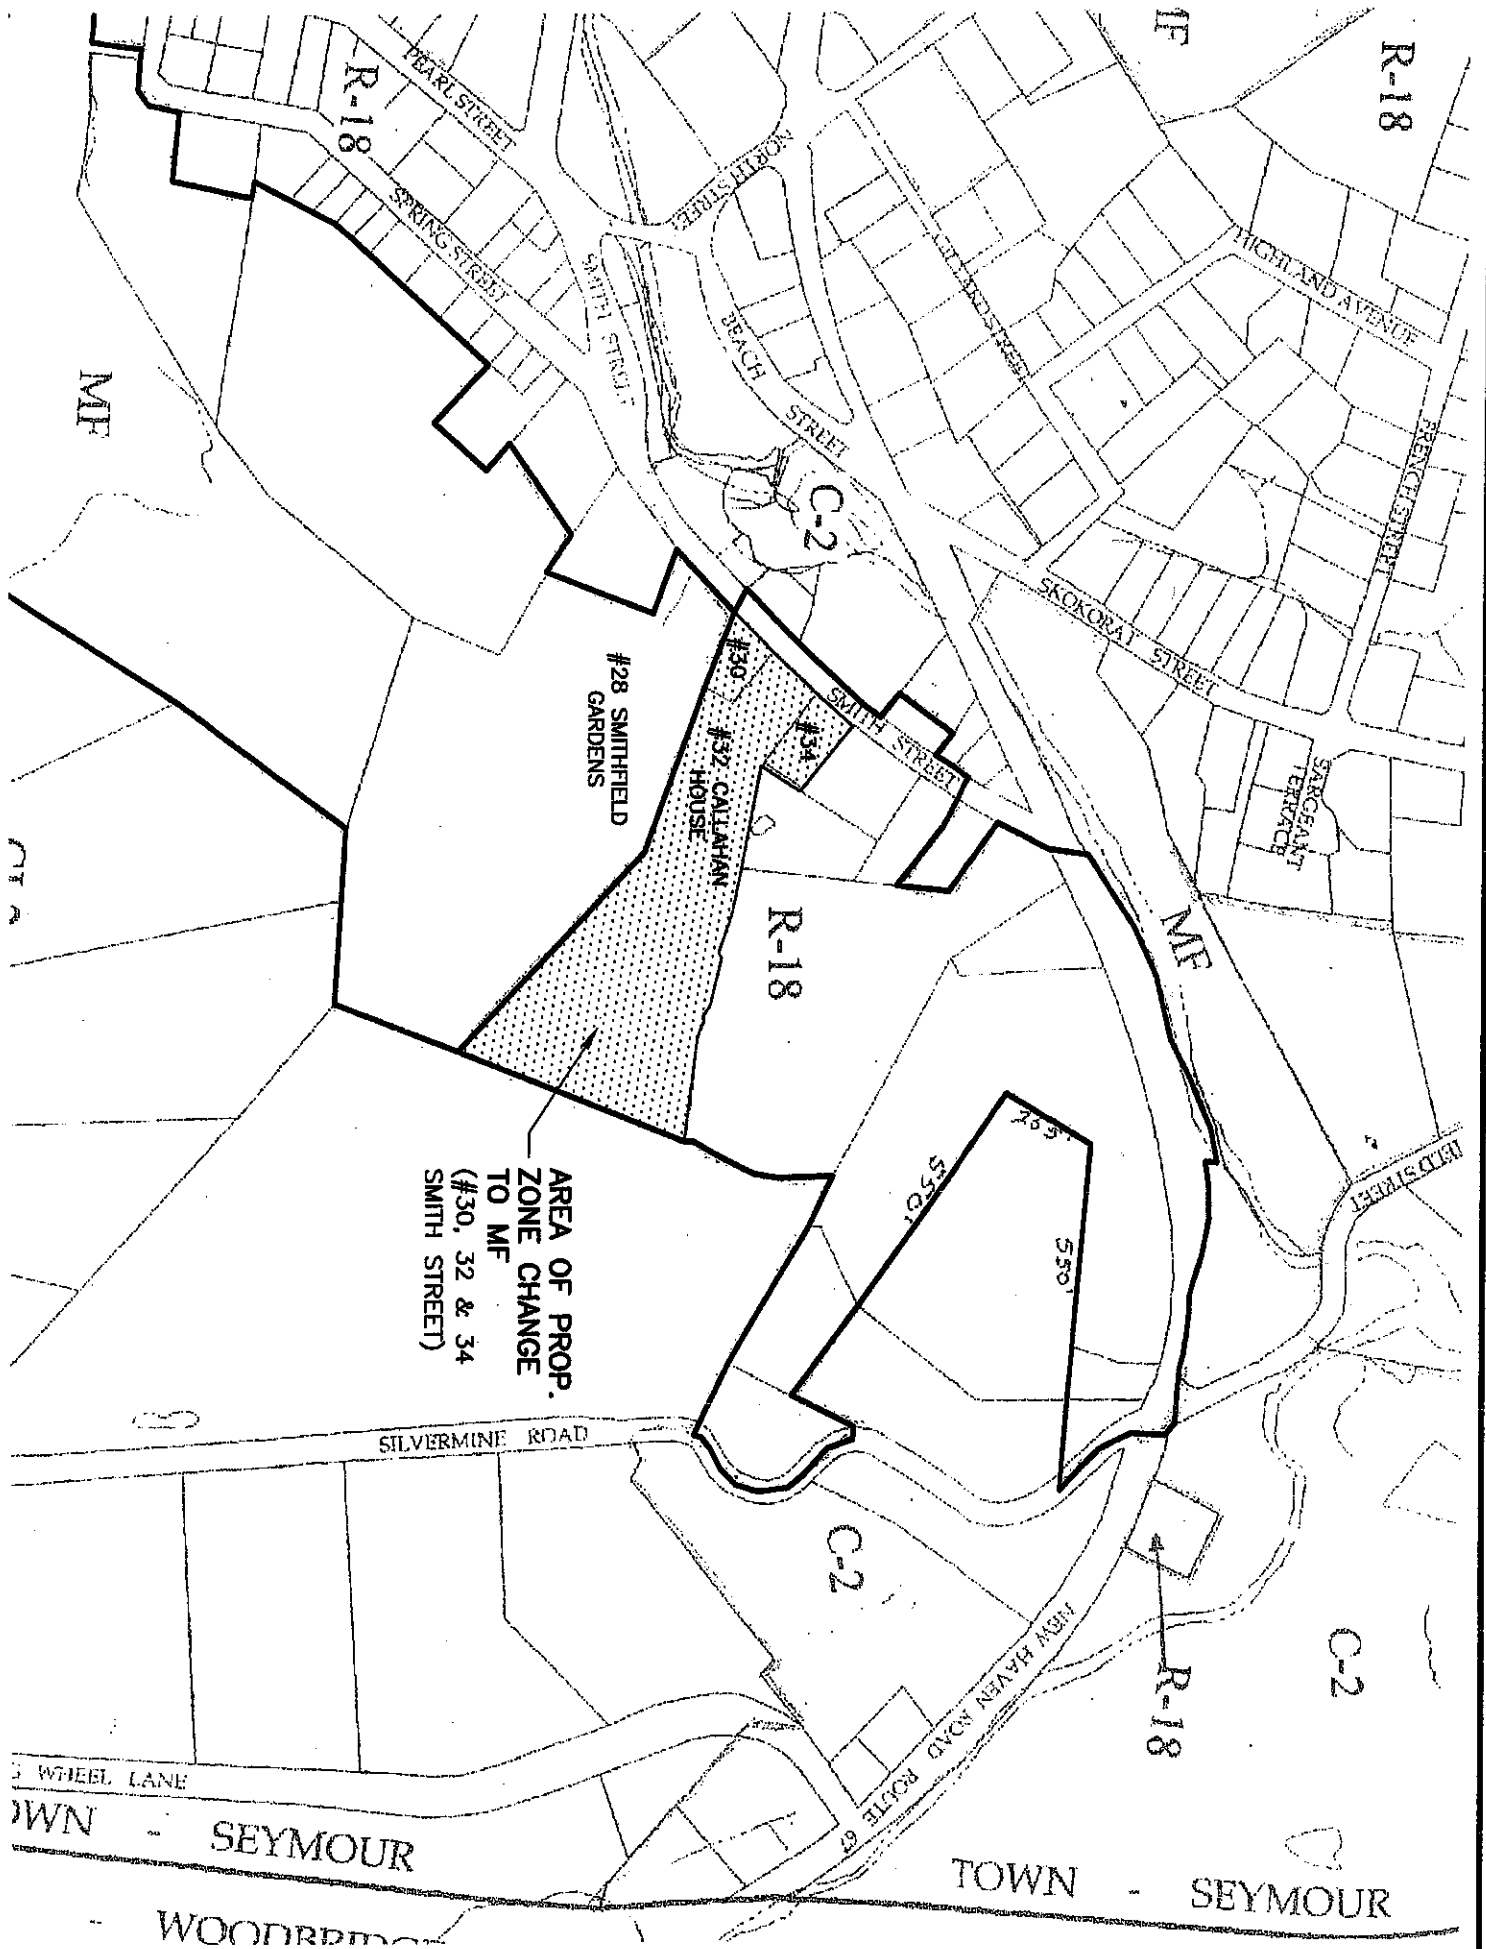

R-18

MF

R-18

C-2

#28 SMITHFIELD GARDENS

#30  

R-18

AREA OF PROP.  
ZONE CHANGE  
TO MF  
(#30, 32 & 34  
SMITH STREET)

MF

C-2

R-18

C-2

SILVERMINE ROAD

SEYMOUR

TOWN - SEYMOUR

WOODBRIDGE