

SECTION E CERTIFICATION

This certification is to be signed by a land surveyor, engineer, or architect who is authorized by state or local law to certify elevation information when the elevation information for Zones A1-A30, AE, AH, A (with BFE), V1-V30, VE, and V (with BFE) is required. Community officials who are authorized by local law or ordinance to provide floodplain management information, may also sign the certification. In the case of Zones AO and A (without a FEMA or community issued BFE), a building official, a property owner, or an owner's representative may also sign the certification.

Reference level diagrams 6, 7 and 8 - Distinguishing Features--If the certifier is unable to certify to breakaway/non-breakaway wall, enclosure size, location of servicing equipment, area use, wall openings, or unfinished area Feature(s), then list the Feature(s) not included in the certification under Comments below. The diagram number, Section C, Item 1, must still be entered.


I certify that the information in Sections B and C on this certificate represents my best efforts to interpret the data available. I understand that any false statement may be punishable by fine or imprisonment under 18 U.S. Code, Section 1001.

CERTIFIER'S NAME: THOMAS P. KARR LICENSE NUMBER (or Affix Seal): 31269
 TITLE: PROF. LAND SURVEYOR COMPANY NAME: KARR LAND SURVEYING
 ADDRESS: PO BOX 89 CITY: SEAVILLE STATE: NJ ZIP: 08360
 SIGNATURE: Thomas P. Karr DATE: 6/14/97 PHONE: 609 390 7936

Copies should be made of this Certificate for: 1) community official, 2) insurance agent/company, and 3) building owner.



COMMENTS: NOTE: REFERENCE LEVEL USED IS BOTTOM OF HEATER

MAR 31 10 28 AM '99
 CITY OF OCEAN CITY
 CODE ENFORCEMENT

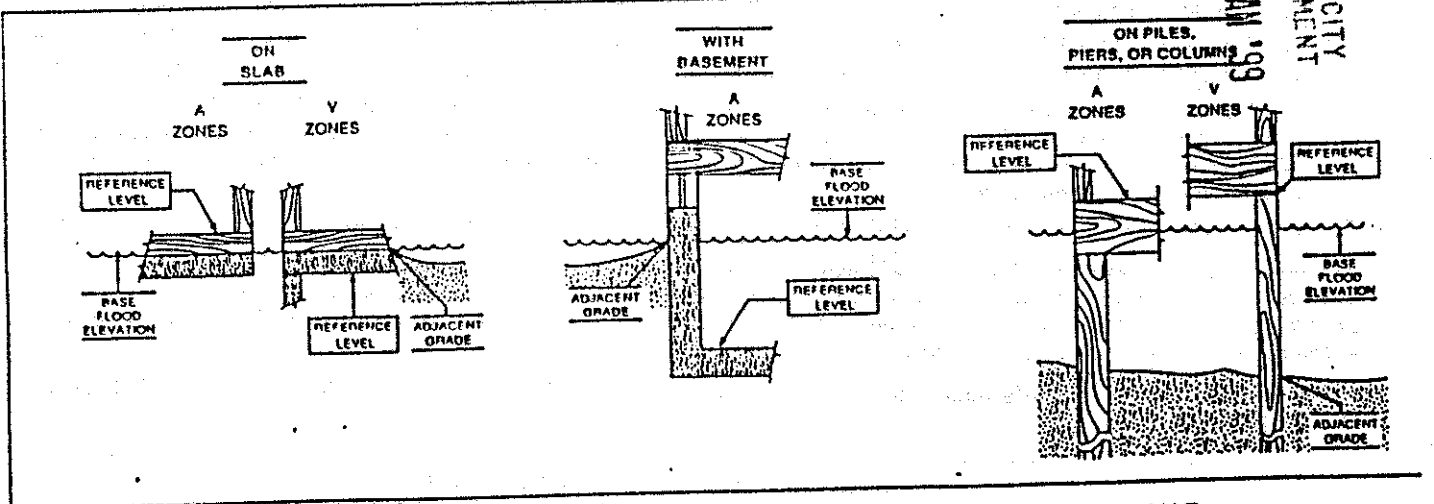

The diagrams above illustrate the points at which the elevations should be measured in A Zones and V Zones. Elevations for all A Zones should be measured at the top of the reference level floor. Elevations for all V Zones should be measured at the bottom of the lowest horizontal structural member.

NOTE:
 65' X 100' LOT
 ALL CORNERS
 ARE 90°

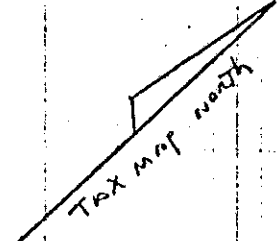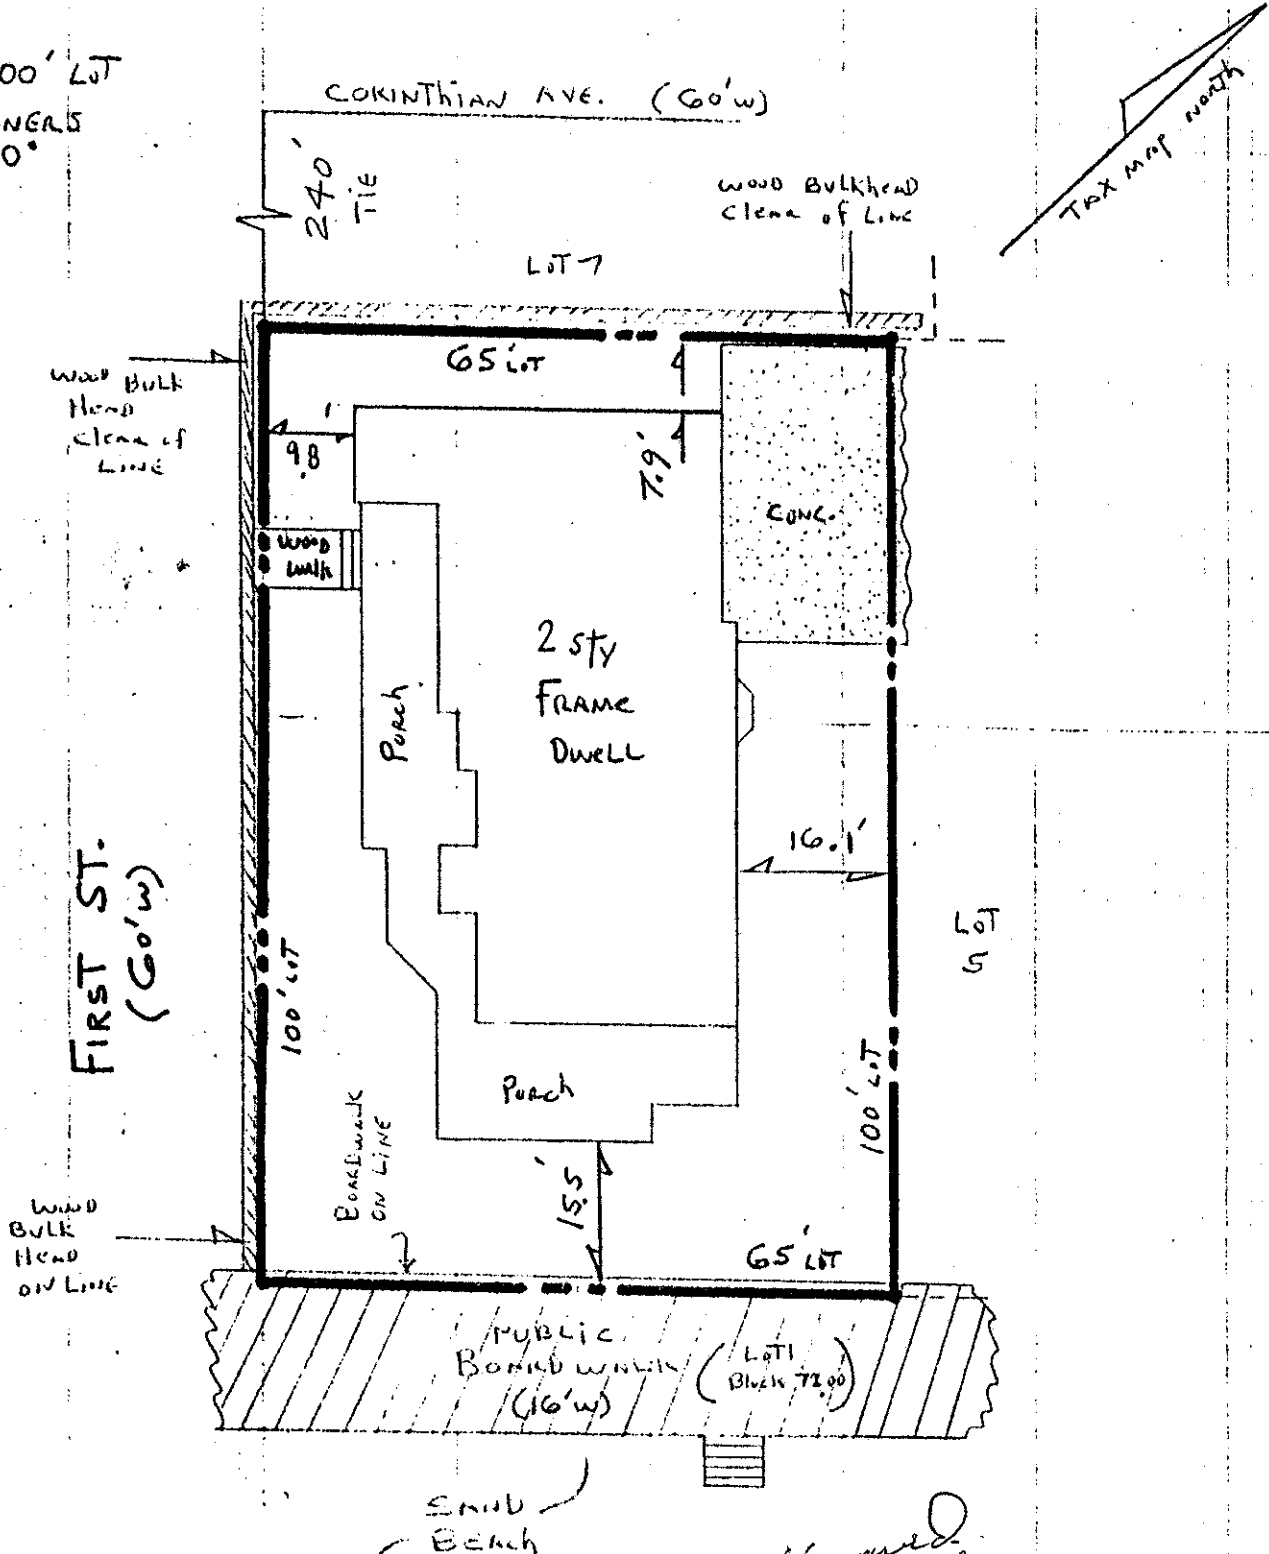

ELEV ARE NGVD

Roof PEAK ELEV 38.13

1st ST. ELEV 7.24

Diff 30.89 FEET

*Approved
 Jack
 3-30-99*

Final

KARR LAND SURVEYING

R.O. BOX 89
 OCEANVIEW, N.J. 08230
 609-390-7936 FAX • 609-390-7937

Thomas P. Karr
THOMAS P. KARR
 P.L.S. LICENSE NO. 31269

PLAN OF SURVEY

BLOCK(s) 3 LOT(s) 6

OCEAN CITY

COUNTY OF CAPE MAY

NEW JERSEY

TYPE THREE

Date 4.1.98

Drawn By GW

Scale 1" = 20'

Chk'd By TK

REVISIONS _____

Date _____

PROJECT NO. 92217