

APR 5 9 07 AM '01

FEDERAL EMERGENCY MANAGEMENT AGENCY
NATIONAL FLOOD INSURANCE PROGRAM

ELEVATION CERTIFICATE

Important: Read the instructions on pages 1 - 7.

SECTION A - PROPERTY OWNER INFORMATION For Insurance Company Use:

BUILDING OWNER'S NAME **BAY BREEZE, INC.** Policy Number
BUILDING STREET ADDRESS (Including Apt., Unit, Suite, and/or Bldg. No.) OR P.O. ROUTE AND BOX NO.
ADDRESS 827 FIRST STREET Company NAIC Number
CITY STATE ZIP CODE **OCEAN CITY, NEW JERSEY 08226**
PROPERTY DESCRIPTION (Lot and Block Numbers, Tax Parcel Number, Legal Description, etc.) **BLOCK 6 LOT 41**
BUILDING USE (e.g., Residential, Non-residential, Addition, Accessory, etc. Use Comments section if necessary.)
(RESIDENTIAL)
LATITUDE/LONGITUDE (OPTIONAL) HORIZONTAL DATUM: SOURCE: GPS (Type): (
##o-##-### or ##.####o) NAD 1927 NAD 1983 USGS Quad Map Other:

SECTION B - FLOOD INSURANCE RATE MAP (FIRM) INFORMATION

B1. NFIP COMMUNITY NAME & COMMUNITY NUMBER **OCEAN CITY, NJ 345310**
B2. COUNTY NAME **CAPE MAY** B3. STATE **NEW JERSEY**
B4. MAP AND PANEL NUMBER **345310 0001** B5. SUFFIX **C** B6. FIRM INDEX DATE **7-15-1992** B7. FIRM PANEL **0001**
EFFECTIVE/REVISED DATE **9-5-1984** B8. FLOOD ZONE(S) **A-7**
B9. BASE FLOOD ELEVATION(S) (Zone AO, use depth of flooding) **9.0**
B10. Indicate the source of the Base Flood Elevation (BFE) data or base flood depth entered in B9.
FIS Profile (FIRM) Community Determined Other (Describe):
B11. Indicate the elevation datum used for the BFE in B9: (NGVD 1929) NAVD 1988 Other
(Describe):

B12. Is the building located in a Coastal Barrier Resources System (CBRS) area or Otherwise Protected Area (OPA)? Yes (NO)
Designation Date

SECTION C - BUILDING ELEVATION INFORMATION (SURVEY REQUIRED)

- C1. Building elevations are based on: Construction Drawings* Building Under Construction*
(FINISHED CONSTRUCTION)
*A new Elevation Certificate will be required when construction of the building is complete.
C2. BUILDING DIAGRAM NUMBER **7 (SEE COMMENTS)** (Select the building diagram most similar to the building for which this certificate is being completed - see pages 6 and 7. If no diagram accurately represents the building, provide a sketch or photograph.)
C3. Elevations - Zones A1-A30, AE, AH, A (with BFE), VE, V1-V30, V (with BFE), AR, AR/A, AR/AE, AR/A1-A30, AR/AH, AR/AO

Complete Items C3a-i below according to the building diagram specified in Item C2. State the datum used. If the datum is different from the datum used for the BFE in Section B, convert the datum to that used for the BFE. Show field measurements and datum conversion calculation. Use the space provided or the Comments area of Section D or Section G, as appropriate, to document the datum conversion.

Datum (NGVD 1929) Conversion/Comments **NO CONVERSION**

Elevation reference mark used **TIDAL 3 10.33** Does the elevation reference mark used appear on the FIRM? **NO**

- | | |
|--|--------------|
| a) Top of bottom floor (including basement or enclosure) | 8.6 ft. |
| b) Top of next higher floor | 17.8 ft. |
| c) Bottom of lowest horizontal structural member (V zones only) | N.A. ft. |
| d) Attached garage (top of slab) | 8.6 ft. |
| e) Lowest elevation of machinery and/or equipment servicing the building A/C | 10.2 +/- ft. |
| f) Lowest adjacent grade (LAG) | 8.4 ft. |
| g) Highest adjacent grade (HAG) | 8.6 ft. |
| h) No. of permanent openings (flood vents) within 1 ft. above adjacent grade 8 | |
| i) Total area of all permanent openings (flood vents) in C3h_sq. in. 1728 | |

SECTION D - SURVEYOR, ENGINEER, OR ARCHITECT CERTIFICATION

This certification is to be signed and sealed by a land surveyor, engineer, or architect authorized by law to certify elevation information. I certify that the information in Sections A, B, and C on this certificate

represents my best efforts to interpret the data available. I understand that any false statement may be punishable by fine or imprisonment under 18 U.S. Code, Section 1001.

CERTIFIER'S NAME GORDON M. LUDWIG P.L.S. N.J. LICENSE NUMBER 33531
TITLE LAND SURVEYOR COMPANY NAME POINT TO POINT SURVEYING CO., INC.
ADDRESS CITY STATE ZIP CODE P.O. BOX 299 SOMERS POINT, NEW JERSEY 08244
SIGNATURE MAR. 2001 609-927-9295

IMPORTANT: In these spaces, copy the corresponding information from Section A. For Insurance

Company Use:
BUILDING STREET ADDRESS (Including Apt., Unit, Suite, and/or Bldg. No.) OR P.O. ROUTE AND BOX NO.
ADDRESS 827 FIRST STREET Policy Number
CITY STATE ZIP CODE OCEAN CITY, NJ 08226 Company NAIC Number

SECTION D - SURVEYOR, ENGINEER, OR ARCHITECT CERTIFICATION (CONTINUED)

Copy both sides of this Elevation Certificate for (1) community official, (2) insurance agent/company, and (3) building owner.

COMMENTS C3-A IS THE GARAGE FLOOR & ENT FOYER. C3-B IS THE FIRST FLOOR LIVING SPACE. (SIDE WALLS ARE FRAMED, NOT FOUNDATION WALLS) FOYER AREA = 36 S.F.+/-.

Check here if attachments

SECTION E - BUILDING ELEVATION INFORMATION (SURVEY NOT REQUIRED) FOR ZONE AO AND ZONE A (WITHOUT BFE)

For Zone AO and Zone A (without BFE), complete Items E1 through E4. If the Elevation Certificate is intended for use as supporting information for a LOMA or LOMR-F, Section C must be completed. E1. Building Diagram Number (Select the building diagram most similar to the building for which this certificate is being completed - see pages 6 and 7. If no diagram accurately represents the building, provide a sketch or photograph.) E2. The top of the bottom floor (including basement or enclosure) of the building is ft.(m) in.(cm) above or below (check one) the highest adjacent grade. E3. For Building Diagrams 6-8 with openings (see page 7), the next higher floor or elevated floor (elevation b) of the building is ft.(m) in.(cm) above the highest adjacent grade. E4. For Zone AO only: If no flood depth number is available, is the top of the bottom floor elevated in accordance with the community's floodplain management ordinance? Yes No Unknown. The local official must certify this information in Section G.

SECTION F - PROPERTY OWNER (OR OWNER'S REPRESENTATIVE) CERTIFICATION

The property owner or owner's authorized representative who completes Sections A, B, and E for Zone A (without a FEMA-issued or community-issued BFE) or Zone AO must sign here.

PROPERTY OWNER'S OR OWNER'S AUTHORIZED REPRESENTATIVE'S NAME

ADDRESS CITY STATE ZIP CODE

SIGNATURE DATE TELEPHONE

COMMENTS

Check here if attachments

SECTION G - COMMUNITY INFORMATION (OPTIONAL)

The local official who is authorized by law or ordinance to administer the community's floodplain management ordinance can complete Sections A, B, C (or E), and G of this Elevation Certificate. Complete the applicable item(s) and sign below.

- G1. The information in Section C was taken from other documentation that has been signed and embossed by a licensed surveyor, engineer, or architect who is authorized by state or local law to certify elevation information. (Indicate the source and date of the elevation data in the Comments area below.)
- G2. A community official completed Section E for a building located in Zone A (without a FEMA-issued or community-issued BFE) or Zone AO.
- G3. The following information (Items G4-G9) is provided for community floodplain management purposes.

G4. Permit Number

G5. Date Permit Issued

G6. DATE CERTIFICATE OF

COMPLIANCE/OCCUPANCY ISSUED

G7. This permit has been issued for: New Construction Substantial Improvement

G8. Elevation of as-built lowest floor (including basement) of the building is:

ft.(m) Datum:

G9. BFE or (in Zone AO) depth of flooding at the building site is:


ft.(m) Datum:

LOCAL OFFICIAL'S NAME TITLE

COMMUNITY NAME TELEPHONE

SIGNATURE DATE

COMMENTS

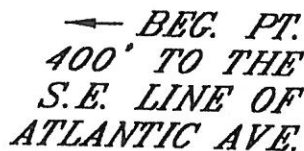

DATE: MAR 26 2001