




**SECTION E CERTIFICATION**

This certification is to be signed by a land surveyor, engineer, or architect who is authorized by state or local law to certify elevation information when the elevation information for Zones A1-A30, AE, AH, A (with BFE), V1-V30, VE, and V (with BFE) is required. Community officials who are authorized by local law or ordinance to provide floodplain management information, may also sign the certification. In the case of Zones AO and A (without a FEMA or community issued BFE), a building official, a property owner, or an owner's representative may also sign the certification.

Reference level diagrams 6, 7 and 8 - Distinguishing Features-If the certifier is unable to certify to breakaway/non-breakaway wall, enclosure size, location of servicing equipment, area use, wall openings, or unfinished area Feature(s), then list the Feature(s) not included in the certification under Comments below. The diagram number, Section C, Item 1, must still be entered.


*I certify that the information in Sections B and C on this certificate represents my best efforts to interpret the data available. I understand that any false statement may be punishable by fine or imprisonment under 18 U.S. Code, Section 1001.*

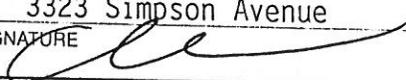
CERTIFIER'S NAME		LICENSE NUMBER (or Affix Seal)	
David C. Kruger		N.J.P.L.S. # 30406	
TITLE		COMPANY NAME	
Prof. Land Surveyor		David C. Kruger Associates	
ADDRESS		CITY	STATE
3323 Simpson Avenue		Ocean City	N.J.
SIGNATURE		DATE	PHONE
		12/2/97	(609) 391-9393
		ZIP	08226

Copies should be made of this Certificate for: 1) community official, 2) insurance agent/company, and 3) building owner.

COMMENTS:

CITY OF OCEAN CITY  
 CODE ENFORCEMENT  
 DEC 11 2 15 PM '97

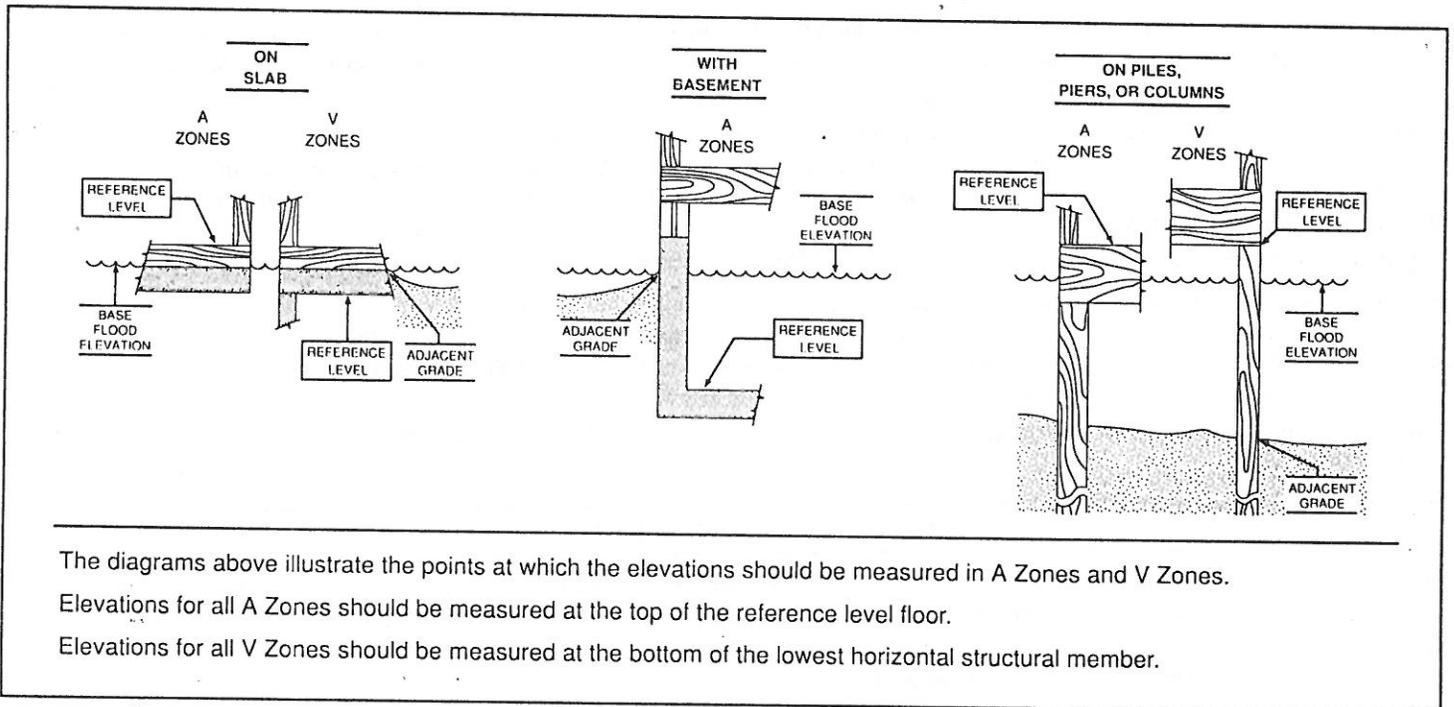

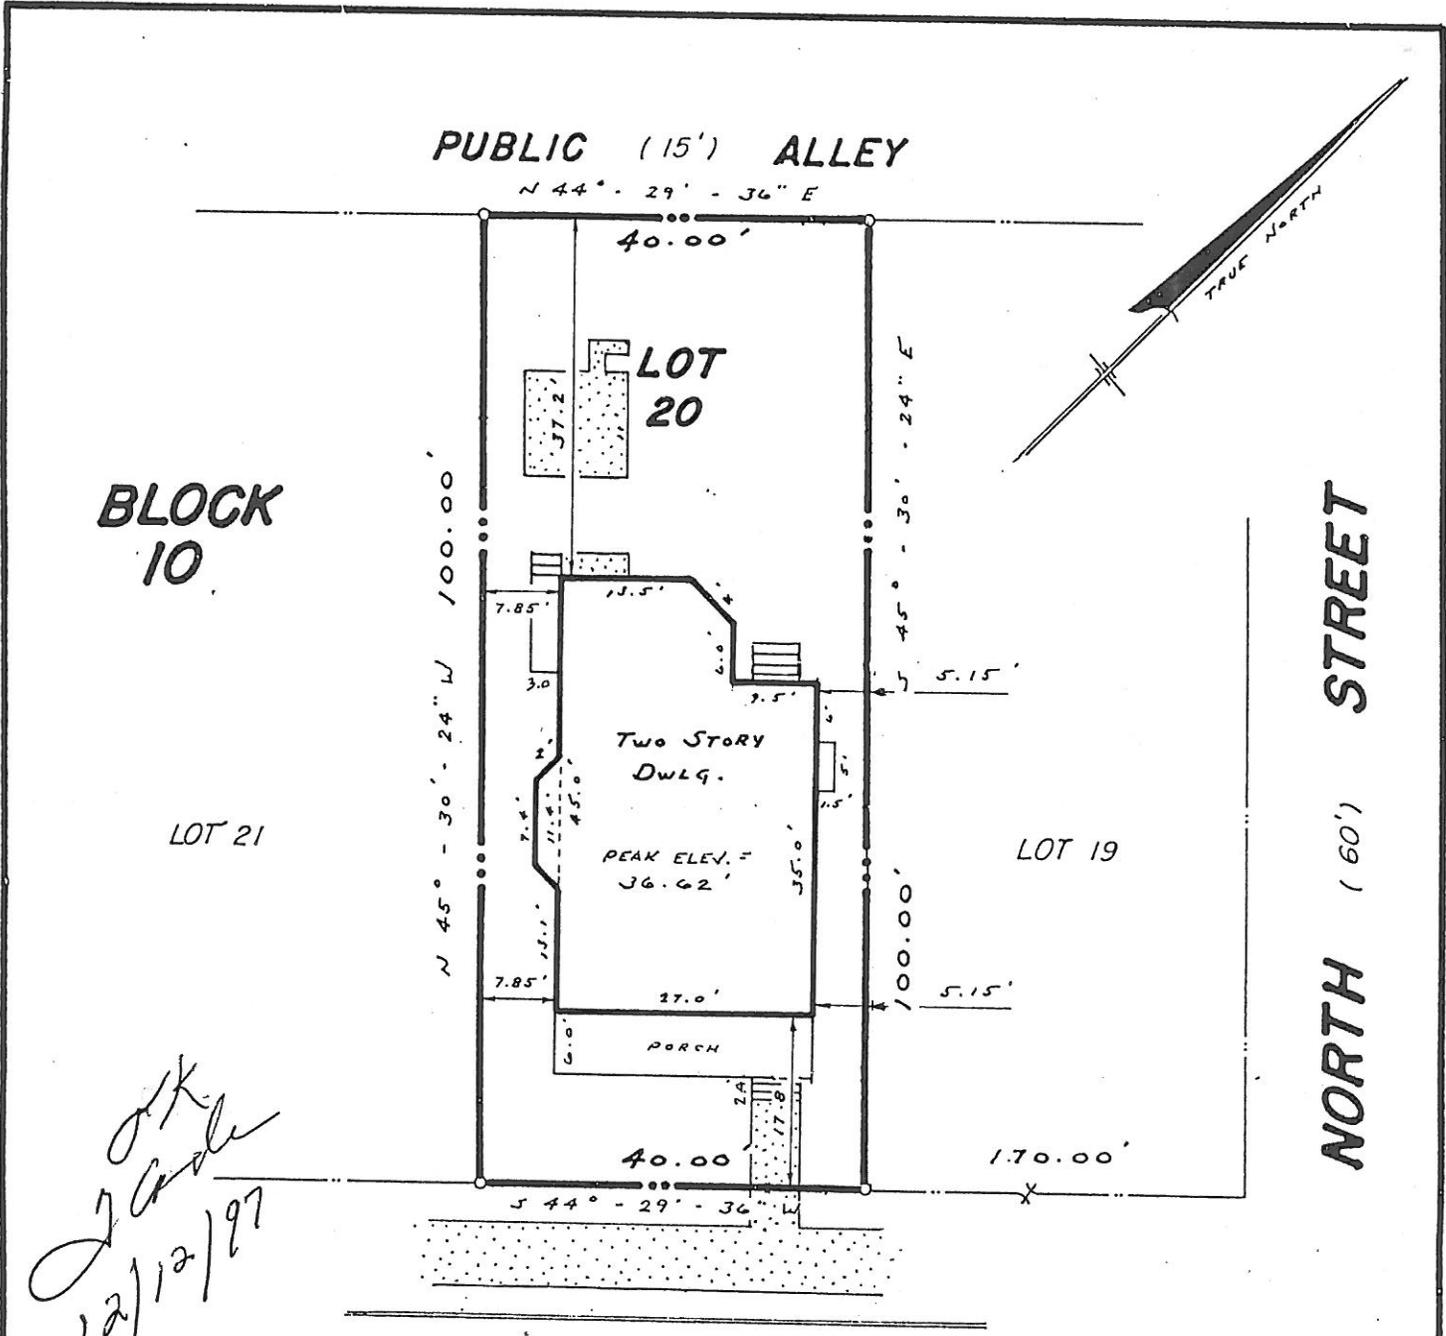

Issued to:

**EDWARD and LAURA MARCIANO**  
**SHORE TITLE AGENCY, INC**  
**NORWEST MORTGAGE, INC.**  
*it's successors and/or assigns*

NOTE: This survey is made subject to any rights, restrictions, easements, rights-of-way exceptions or covenants that an accurate and current title report may disclose.

Any insuror of title relying hereon and any other party in interest:

In consideration of the fee paid for making this survey, I hereby certify to its accuracy (except such easements, if any, that may exist below the surface of the land or on the surface of the lands and not visible) as an inducement for any insuror of title to insure the title to the lands and premises as shown therein. This certification is made only to above named parties for purchase and/or mortgage of herein delineated property by above named purchaser. No responsibility or liability is assumed by Surveyor for use of survey for any other purpose including but not limited to use of survey for survey affidavit, resale of property, or to any other person not listed in certification, either directly or indirectly.

**DAVID C. KRUGER**

N.J.P.L.S. License No. 30406

Not valid unless seal-embossed

<b>PLAN OF SURVEY</b>			
<b>LOT 20</b>		<b>BLOCK 10</b>	
CITY OF OCEAN CITY CAPE MAY, COUNTY, N.J.			
<b>DAVID C. KRUGER ASSOCIATES</b>			
Land Surveying • Planning			
3323 Simpson Avenue, Suite 6 • Ocean City, NJ			
		date 7-7-97	drawn P.T.
FINAL SURVEY	12-2-97	D.K.	scale 1" = 20'
checked			D.K.
revision:	date	by	book - pg. - Proj. 7055