ELEVATION CERTIFICATE

OMB No. 1660-0008


Federal Emergency Management Agency						Expires March 31, 2012
National Flood Insurance Program Important:	Read the in	structions of	on pa	ages 1-9.		41-070
SECT	ION A - PROI	PERTY INFO	ORM	ATION	For In	surance Company Use:
A1. Building Owner's Name OCEAN CITY PREMIER BUILDER	S/DEVELOPER	lS .				Number
A2. Building Street Address (including Apt., Unit, Suite, and/or B 19-21 CENTRAL ROAD	ldg. No.) or P.O	. Route and E	Box No	D.	Comp	any NAIC Number
City OCEAN CITY State NJ ZIP Code 08226						
A3. Property Description (Lot and Block Numbers, Tax Parcel Nu LOT 6 BLOCK 70.04	umber, Legal De	escription, etc	:.)	0		
A4. Building Use (e.g., Residential, Non-Residential, Addition, Ac A5. Latitude/Longitude: Lat. N 39* 17' 18.39" Long. W 74* 33' 44. A6. Attach at least 2 photographs of the building if the Certificate A7. Building Diagram Number 7 A8. For a building with a crawlspace or enclosure(s):	4.73"	o obtain flood	insur	ance.		D 1927 🔲 NAD 1983
	1,034 sq ft 2 sq in	a) b) c)	Squ No. with	uilding with an atta uare footage of atta of permanent floo iin 1.0 foot above a al net area of flood gineered flood ope	ached gara d openings adjacent g openings	age <u>440</u> sq ft sin the attached garage rade <u>3</u>
SECTION B - FLOOD IN	ISURANCE R	ATE MAP (FIRM) INFORMATIO	N	
	32. County Nam CAPE MAY	е			B3. State	
B4. Map/Panel Number B5. Suffix B6. FIRM Index Date 7-15-92	Effective/	IRM Panel Revised Date 1-5-84	•	B8. Flood Zone(s) A-7		ase Flood Elevation(s) (Zone O, use base flood depth) 9 FT
☐ FIS Profile ☐ FIRM ☐ Community Deten B11. Indicate elevation datum used for BFE in Item B9: ☐ NGVD B12. Is the building located in a Coastal Barrier Resources System Designation Date	1929	Other (Des NAVD 1986 TOtherwise F	B 1	Other (Describ		☐ Yes
SECTION C - BUILDING EL	EVATION IN	FORMATIO	N (SI	JRVEY REQUIR	ED)	THE STATE OF THE S
 Building elevations are based on: Construction Draw *A new Elevation Certificate will be required when construction Elevations – Zones A1-A30, AE, AH, A (with BFE), VE, V1-V30 below according to the building diagram specified in Item A7. Use Benchmark Utilized PRVTVertical Datum 1929 Conversion/Comments NONE 	of the building i	s complete. AR. AR/A. AF	R/AF.	Construction* AR/A1-A30, AR/AI		shed Construction Complete Items C2.a-h
			CI	neck the measurer	nent used.	
 a) Top of bottom floor (including basement, crawlspace, or er b) Top of the next higher floor c) Bottom of the lowest horizontal structural member (V Zone d) Attached garage (top of slab) e) Lowest elevation of machinery or equipment servicing the (Describe type of equipment and location in Comments) 	1 s only) <u>N</u> 8	7.9 \(\overline{\text{Z}}\).7 \(\overline{\text{Z}}\)	feet feet feet feet	meters (Puer meter	to Rico on to Rico on to Rico on	y) (y) (y)
 f) Lowest adjacent (finished) grade next to building (LAG) g) Highest adjacent (finished) grade next to building (HAG) h) Lowest adjacent grade at lowest elevation of deck or stairs structural support 	<u>8</u>	. <u>8</u>] feet	meters (Puerl	o Rico onl	y)
SECTION D - SURVEYOR,	ENGINEER.	OR ARCHIT	ECT	CERTIFICATIO	N	
This certification is to be signed and sealed by a land surveyor, eng						

information. I certify that the information of understand that any false statement may be Check here if comments are provided of	e punishable by fine or in		S. Code, Section 10	01.🛛
	lice	ensed land surveyor?	Yes □ No	9
Certifier's Name JAMES E. SCHWAB III		License Nu	mber 24GS033536	00
Title LAND SURVEYOR	Company Name SCI	WAB LAND SURVEYIN	G AND PLANNING,	LLC
Address 8 EAST 10 ^{1H} STREET	City OCEAN CITY	State NJ	ZIP Code	08226
Signature	11/14 (Date	Telephone	609-398-0565	

				For Lawrence Occasion, University
	s, copy the corresponding infor		Α.	For Insurance Company Use: Policy Number
19-21 CENTRAL ROAD	Apt., Unit, Suite, and/or Bldg. No.) or P	.O. Route and Box No.		
City OCEAN CITYState NJ ZIP C	Code 08226			Company NAIC Number
SECTIO	ON D - SURVEYOR, ENGINEER,	OR ARCHITECT CE	RTIFICATION (CON	TINUED)
Copy both sides of this Elevation Co	ertificate for (1) community official, (2)	insurance agent/compa	y, and (3) building own	er.
ARE NOT COMPLETELY PARTITION	OYER AREA OF GROUND LEVEL SL ONED OFF. C2B IS FIRST FLOOR.C PATED AS EQUIVALENT TO 200 SQ. 1.	2E IS HOT WATER HEA IN. NET FREE AREA EA	TERS IN UTILITY CLC	SET. ALL GARAGE VENTS ARE
Signature		Date		M. Oharli harri if attacherent
OFOTION E. PUN PINTE	LEVATION INFORMATION (SUR	VEV NOT BEQUIRE	N EOR ZONE AO AL	Check here if attachments
SECTION E - BUILDING EL	LEVATION INFORMATION (SUR	VET NOT REQUIRE) FOR ZONE AO AI	ND ZONE A (WITHOUT BFE)
and C. For Items E1-E4, use nature E1. Provide elevation information grade (HAG) and the lowest at a) Top of bottom floor (including b) Top of platform of machinery at the second part of the second platform of machinery at the second platform of machinery	ing basement, crawlspace, or enclosuring basement, crawlspace, or enclosure the permanent flood openings provided in s) of the building is [is feet met and/or equipment servicing the building of the number is available, is the top of the	correment used. In Puerloriate boxes to show who have is [re) is [re) is [re] in Section A Items 8 and feet meters above or boxes is fee bottom floor elevated	o Rico only, enter mete other the elevation is ab feet	rs. ove or below the highest adjacent above or below the HAG. above or below the LAG. Instructions), the next higher floor HAG. e or below the HAG.
ordinance? ☐ Yes ☐ No	☐ Unknown. The local official must	t certify this information	n Section G.	
SECTION	ON F - PROPERTY OWNER (OR	OWNER'S REPRES	ENTATIVE) CERTIFI	CATION
The property owner or owner's auth	norized representative who completes attements in Sections A, B, and E are	Sections A, B, and E for	Zone A (without a FEM	A-issued or community-issued BFE)
		Sorreot to and book or my	Kriowieuge.	
Property Owner's or Owner's Author		Solved to allo book of my	Knowledge.	
Property Owner's or Owner's Author		City	State	ZIP Code
Property Owner's or Owner's Author	rized Representative's Name			
	rized Representative's Name	City	State	
Property Owner's or Owner's Author Address Signature	rized Representative's Name	City	State	е
Property Owner's or Owner's Author Address Signature	orized Representative's Name	City Date	State Telephon	
Property Owner's or Owner's Author Address Signature Comments	orized Representative's Name	City Date NITY INFORMATION	State Telephon OPTIONAL)	e ☐ Check here if attachmer
Property Owner's or Owner's Author Address Signature Comments he local official who is authorized by and G of this Elevation Certificate. Comments	SECTION G - COMMUN y law or ordinance to administer the co	City Date NITY INFORMATION mmunity's floodplain main below. Check the me	State Telephon OPTIONAL) nagement ordinance casurement used in Item	Check here if attachmer ☐ Check here if attachmer In complete Sections A, B, C (or E), s G8 and G9.












CENTRAL ROAD (70' WIDE)

CENTERLINE + 7.12

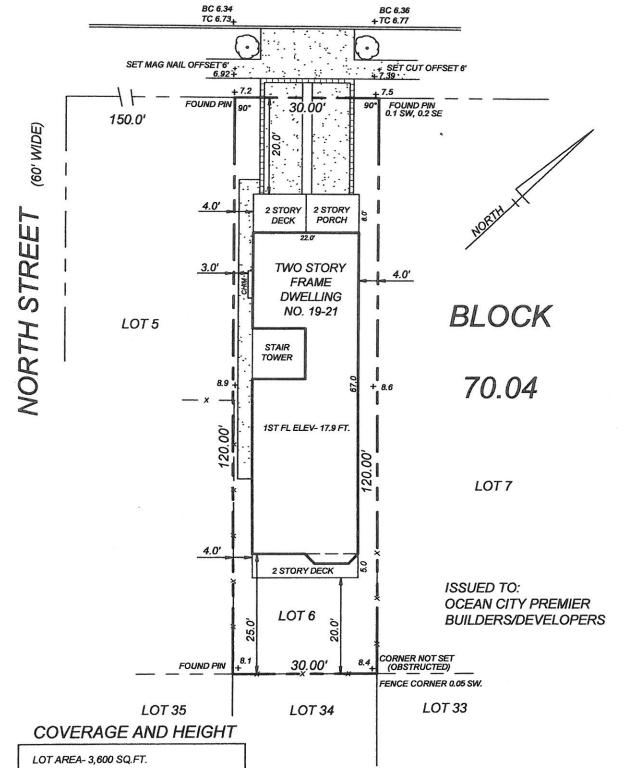

BUILDING AREA- 1,375 SQ.FT.,38.2 %

IMPERVIOUS AREA- 2,300 SQ.FT., 63.9%

PEAK ELEVATION-39.7 FT.

CENTERLINE ELEVATION- 7.12 FT.

BUILDING HEIGHT- 32.6 FT.

+ X.X = EXISTING NGVD 1929 ELEVATION THIS SURVEY IS FOR USE IN APPLYING FOR MUNICIPAL APPROVAL OF NEW CONSTRUCTION. THE SURVEYOR WILL ACCEPT NO RESPONSIBILITY FOR ITS USE FOR ANY OTHER PURPOSE.

FINAL CONSTRUCTION SURVEY ~NOT FOR CONVEYANCE~~~

LOT 6 BLOCK 70.04 Y OF OCEAN CITY CAPE MAY COUNTY, NJ DWN.BY :

DATE: NOV. 15, 2011 SCALE: 1"= 20"

SCHWAB LAND SURVEYING AND PLANNING, LLC

8 EAST 10TH STREET OCEAN CITY, NJ 08226

TELE 609-398-0565

FAX 398-1861

CERTIFICATE OF AUTHORIZATION NO. 24GA28101600

11-070 FILE :

FIELD BOOK : BK 57 PG 10



PROFESSIONAL LAND SURVEYOR NEW JERSEY LIC. 24GS03353600 PROFESSIONAL PLANNER NEW JERSEY LIC. 31LI00408600