FEDERAL EMERGENCY MANAGEMENT AGENCY
NATIONAL FLOOD INSURANCE PROGRAM

ELEVATION CERTIFICATE

O.M.B. No. 3067-0077
Expires December 31, 2005

5 CITY OF OCEAN CITY
CODE ENFORCEMENT
2006 FEB -4 P 3:28

Important: Read the instructions on pages 1 - 7.

SECTION A - PROPERTY OWNER INFORMATION

	For Insurance Company Use:
BUILDING OWNER'S NAME HART INVESTMENT PROPERTIES, LLC	Policy Number
BUILDING STREET ADDRESS (Including Apt., Unit, Suite, and/or Bldg. No.) OR P.O. ROUTE AND BOX NO. 60 STATION ROAD WEST	Company NAIC Number

CITY	STATE	ZIP CODE
OCEAN CITY	NJ	08226

PROPERTY DESCRIPTION (Lot and Block Numbers, Tax Parcel Number, Legal Description, etc.)
LOT 21 BLOCK 70.09

BUILDING USE (e.g., Residential, Non-residential, Addition, Accessory, etc. Use a Comments area, if necessary.)
RESIDENTIAL

LATITUDE/LONGITUDE (OPTIONAL) (##° - ##' - ##.##" or ##.#####°)
HORIZONTAL DATUM: ☐ NAD 1927 ☐ NAD 1983
SOURCE: ☐ GPS (Type):_____ ☐ USGS Quad Map ☐ Other: _____

SECTION B - FLOOD INSURANCE RATE MAP (FIRM) INFORMATION

B1. NFIP COMMUNITY NAME & COMMUNITY NUMBER	B2. COUNTY NAME	B3. STATE
345310 OCEAN CITY	CAPE MAY	NEW JERSEY

B4. MAP AND PANEL NUMBER	B5. SUFFIX	B6. FIRM INDEX DATE	B7. FIRM PANEL EFFECTIVE/REVISED DATE	B8. FLOOD ZONE(S)	B9. BASE FLOOD ELEVATION(S) (Zone AO, use depth of flooding)
345310-0001	C	7-15-92	9-5-84	A7	9 FT.

B10. Indicate the source of the Base Flood Elevation (BFE) data or base flood depth entered in B9.
☐ FIS Profile ☒ FIRM ☐ Community Determined ☐ Other (Describe): _____

B11. Indicate the elevation datum used for the BFE in B9: ☒ NGVD 1929 ☐ NAVD 1988 ☐ Other (Describe): _____

B12. Is the building located in a Coastal Barrier Resources System (CBRS) area or Otherwise Protected Area (OPA)? ☐ Yes ☒ No Designation Date_____

SECTION C - BUILDING ELEVATION INFORMATION (SURVEY REQUIRED)

C1. Building elevations are based on: ☐ Construction Drawings* ☐ Building Under Construction* ☒ Finished Construction
*A new Elevation Certificate will be required when construction of the building is complete.

C2. Building Diagram Number 8 (Select the building diagram most similar to the building for which this certificate is being completed - see pages 6 and 7. If no diagram accurately represents the building, provide a sketch or photograph.)

C3. Elevations – Zones A1-A30, AE, AH, A (with BFE), VE, V1-V30, V (with BFE), AR, AR/A, AR/AE, AR/A1-A30, AR/AH, AR/AO
Complete Items C3.~~a~~-i below according to the building diagram specified in Item C2. State the datum used. If the datum is different from the datum used for the BFE in Section B, convert the datum to that used for the BFE. Show field measurements and datum conversion calculation. Use the space provided or the Comments area of Section D or Section G, as appropriate, to document the datum conversion.

Datum SAME Conversion/Comments NONE

Elevation reference mark used PRVT Does the elevation reference mark used appear on the FIRM? ☐ Yes ☒ No

- o a) Top of bottom floor (including basement or enclosure) 7. 10 ft.(m)
- o b) Top of next higher floor 10 . 7 ft.(m)
- o c) Bottom of lowest horizontal structural member (V zones only) N/A . __ ft.(m)
- o d) Attached garage (top of slab) 7. 6 ft.(m)
- o e) Lowest elevation of machinery and/or equipment servicing the building (Describe in a Comments area) 10 . 5 ft.(m)
- o f) Lowest adjacent (finished) grade (LAG) 7 . 1 ft.(m)
- o g) Highest adjacent (finished) grade (HAG) 7. 3 ft.(m)
- o h) No. of permanent openings (flood vents) within 1 ft. above adjacent grade 17**
- o i) Total area of all permanent openings (flood vents) in C3.h 4,352** sq. in. (sq. cm)

License Number, Embossed Seal, Signature, and Date
2/3/06
GS33536

SECTION D - SURVEYOR, ENGINEER, OR ARCHITECT CERTIFICATION

This certification is to be signed and sealed by a land surveyor, engineer, or architect authorized by law to certify elevation information.
I certify that the information in Sections A, B, and C on this certificate represents my best efforts to interpret the data available.
I understand that any false statement may be punishable by fine or imprisonment under 18 U.S. Code, Section 1001.

CERTIFIER'S NAME		LICENSE NUMBER
JAMES E. SCHWAB III		GS 33,536
TITLE: LAND SURVEYOR	COMPANY NAME: SCHWAB LAND SURVEYING AND PLANNING, LLC	
ADDRESS: 8 EAST 10TH STREET	CITY: OCEAN CITY	STATE: NJ / ZIP CODE: 08226
SIGNATURE	DATE: 2/3/06	TELEPHONE: 609-398-0565

IMPORTANT: In these spaces, copy the corresponding information from Section A.			For Insurance Company Use:
BUILDING STREET ADDRESS (Including Apt., Unit, Suite, and/or Bldg. No.) OR P.O. ROUTE AND BOX NO. 60 STATION ROAD WEST			Policy Number
CITY OCEAN CITY	STATE NJ	ZIP CODE 08226	Company NAIC Number

SECTION D - SURVEYOR, ENGINEER, OR ARCHITECT CERTIFICATION (CONTINUED)

Copy both sides of this Elevation Certificate for (1) community official, (2) insurance agent/company, and (3) building owner.

COMMENTS
C3a IS CRAWL SPACE. C3b IS FIRST FLOOR, C3E IS HVAC PLATFORM.
**C3i IS GROSS VENT AREA. FOUR OF THE SEVENTEEN VENTS ARE LOCATED IN THE GARAGE WITH A GROSS VENT
AREA OF 1,024 SQ. IN. . BUILDING FOUNDATION AREA IS 1,396 SQ. FT.

☐ Check here if attachments

SECTION E - BUILDING ELEVATION INFORMATION (SURVEY NOT REQUIRED) FOR ZONE AO AND ZONE A (WITHOUT BFE)

For Zone AO and Zone A (without BFE), complete Items E1 through E4. If the Elevation Certificate is intended for use as supporting information for a LOMA or LOMR-F, Section C must be completed.

E1. Building Diagram Number _(Select the building diagram most similar to the building for which this certificate is being completed – see pages 6 and 7. If no diagram accurately represents the building, provide a sketch or photograph.)

E2. The top of the bottom floor (including basement or enclosure) of the building is __ ft.(m) __in.(cm) ☐ above or ☐ below (check one) the highest adjacent grade. (Use natural grade, if available).

E3. For Building Diagrams 6-8 with openings (see page 7), the next higher floor or elevated floor (elevation b) of the building is __ ft.(m) __in.(cm) above the highest adjacent grade. Complete items C3.h and C3.i on front of form.

E4. The top of the platform of machinery and/or equipment servicing the building is __ ft.(m) __in.(cm) ☐ above or ☐ below (check one) the highest adjacent grade. (Use natural grade, if available).

E5. For Zone AO only: If no flood depth number is available, is the top of the bottom floor elevated in accordance with the community's floodplain management ordinance?
☐ Yes ☐ No ☐ Unknown. The local official must certify this information in Section G.

SECTION F - PROPERTY OWNER (OR OWNER'S REPRESENTATIVE) CERTIFICATION

The property owner or owner's authorized representative who completes Sections A, B, C (Items C3.h and C3.i only), and E for Zone A (without a FEMA-issued or community-issued BFE) or Zone AO must sign here. *The statements in Sections A, B, C, and E are correct to the best of my knowledge.*

PROPERTY OWNER'S OR OWNER'S AUTHORIZED REPRESENTATIVE'S NAME

ADDRESS | CITY | STATE | ZIP CODE

SIGNATURE | DATE | TELEPHONE

COMMENTS

☐ Check here if attachments

SECTION G - COMMUNITY INFORMATION (OPTIONAL)

The local official who is authorized by law or ordinance to administer the community's floodplain management ordinance can complete Sections A, B, C (or E), and G of this Elevation Certificate. Complete the applicable item(s) and sign below.

G1. ☐ The information in Section C was taken from other documentation that has been signed and embossed by a licensed surveyor, engineer, or architect who is authorized by state or local law to certify elevation information. (Indicate the source and date of the elevation data in the Comments area below.)

G2. ☐ A community official completed Section E for a building located in Zone A (without a FEMA-issued or community-issued BFE) or Zone AO.

G3. ☐ The following information (Items G4-G9) is provided for community floodplain management purposes.

G4. PERMIT NUMBER	G5. DATE PERMIT ISSUED	G6. DATE CERTIFICATE OF COMPLIANCE/OCCUPANCY ISSUED
20051436	7/14/05	2/14/06

G7. This permit has been issued for: ☐ New Construction ☐ Substantial Improvement

G8. Elevation of as-built lowest floor (including basement) of the building is: ____.__ft.(m) Datum: ____

G9. BFE or (in Zone AO) depth of flooding at the building site is: ____.__ft.(m) Datum: ____

LOCAL OFFICIAL'S NAME | TITLE

COMMUNITY NAME | TELEPHONE

SIGNATURE | DATE

COMMENTS

☐ Check here if attachments

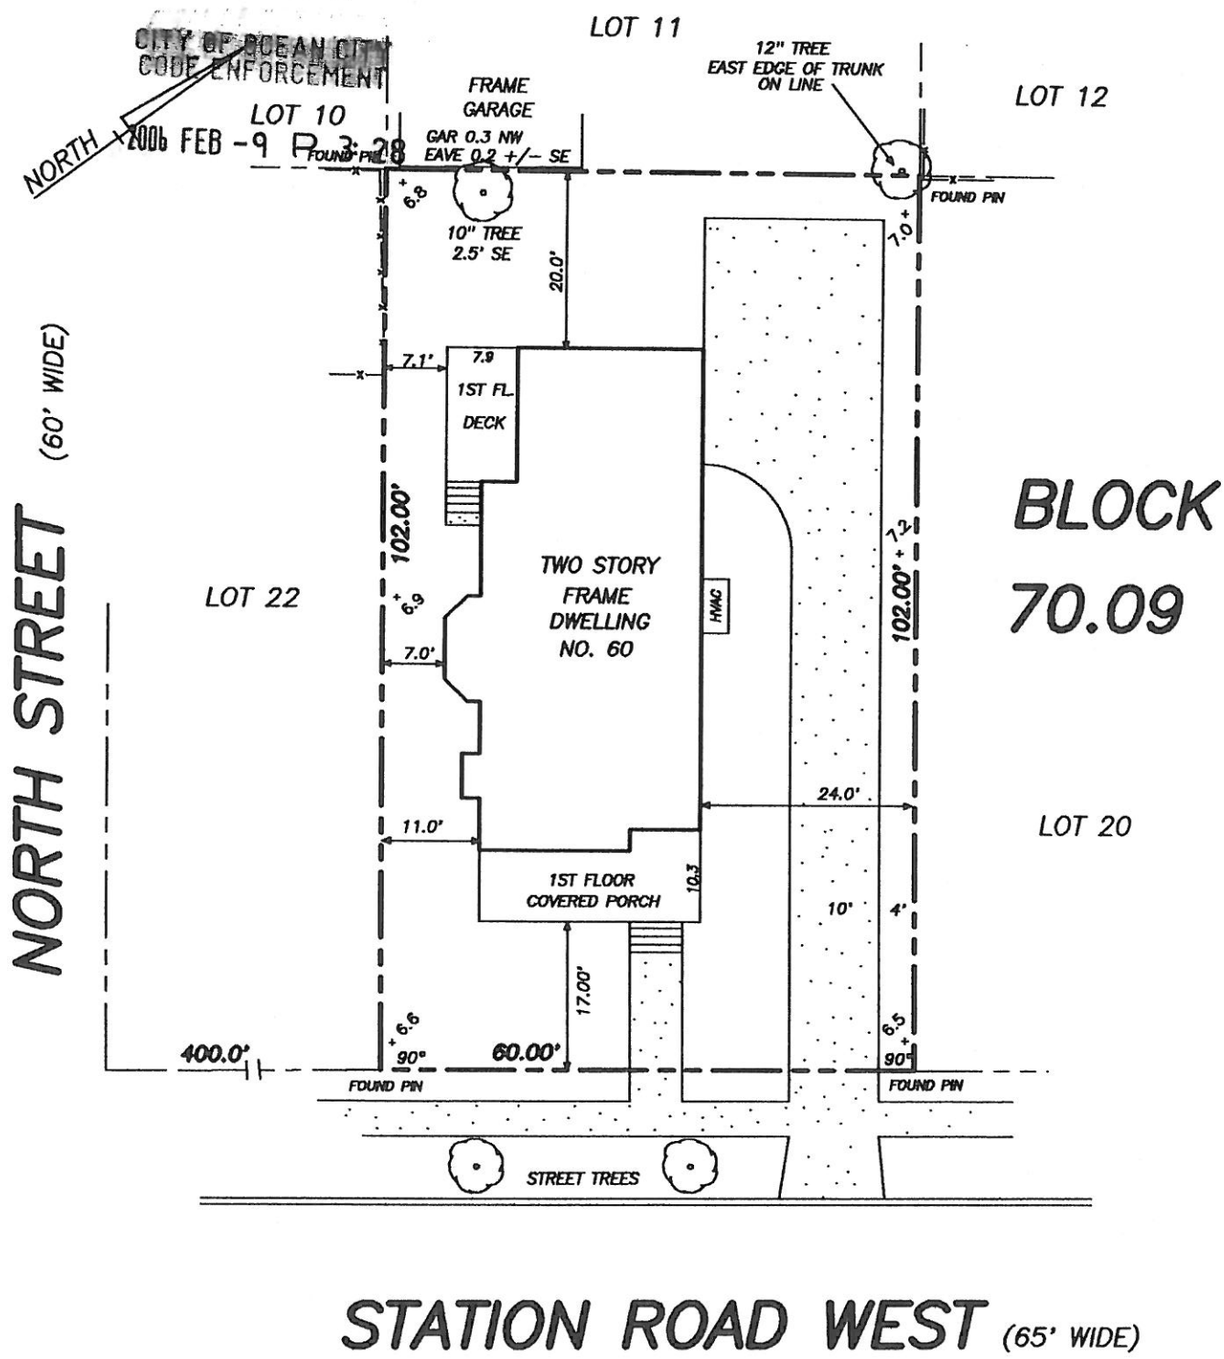

+X.X= EXISTING NGVD 1929 ELEVATION

COVERAGE AND HEIGHT

LOT AREA– 6,120 SF.
BUILDING AREA– 1,563 SF., 25.5%
IMPERVIOUS AREA– 3,145 SF, 51.4%
ATTIC AREA OVER 5 FT– 266 SF., 17% OF 2ND FLOOR AREA
CENTERLINE ELEVATION– 6.27 FT.
PEAK ELEVATION– 39.2 FT.
BUILDING HEIGHT– 32.9 FT.

THIS SURVEY IS FOR USE IN APPLYING FOR MUNICIPAL APPROVAL OF NEW CONSTRUCTION. THE SURVEYOR WILL NOT ACCEPT RESPONSIBILTY FOR ITS USE FOR ANY OTHER PURPOSE.

ISSUED TO:
HAMILTON CONSTRUCTION

FINAL CONSTRUCTION SURVEY
~~~ NOT FOR CONVEYANCE ~~~

LOT 21 BLOCK 70.09
CITY OF OCEAN CITY
CAPE MAY COUNTY, NJ

DATE: JAN. 30, 2006 SCALE: 1"= 20' DWN. BY: JES

2/3/06

JAMES E SCHWAB III
PROFESSIONAL LAND SURVEYOR
NEW JERSEY LICENSE NUMBER 33,536

SCHWAB LAND SURVEYING AND PLANNING, LLC.
8 EAST 10TH STREET
OCEAN CITY, NEW JERSEY 08226
TELE 609-398-0565 FAX 398-1861
CERTIFICATE OF AUTHORIZATION NO. 24GA28101600

FILE: 05-090 FIELD BOOK: ~~~
~~~