

ELEVATION CERTIFICATE

Important: Read the instructions on pages 1-7.

SECTION A - PROPERTY OWNER INFORMATION		For Insurance Company Use:	
BUILDING OWNER'S NAME Palmer Developers, LLC		Policy Number	
BUILDING STREET ADDRESS (including Apt., Unit, Suite, and/or Bldg. No.) OR P.O. ROUTE AND BOX NO. 217 Atlantic Blvd.		Company NAIC Number	
CITY Ocean City	STATE NJ	ZIP CODE 08226	
PROPERTY DESCRIPTION (Lot and Block Numbers, Tax Parcel Number, Legal Description, etc.) Lot 2, Block 70.17			
BUILDING USE (e.g., Residential, Non-residential, Addition, Accessory, etc. Use a Comments area, if necessary.) residential			
LATITUDE/LONGITUDE (OPTIONAL) (##° - ##' - ###.###" or ##.#####")		HORIZONTAL DATUM: <input type="checkbox"/> NAD 1927 <input type="checkbox"/> NAD 1983	
		SOURCE: <input type="checkbox"/> GPS (Type): _____ <input type="checkbox"/> USGS Quad Map <input type="checkbox"/> Other: _____	

SECTION B - FLOOD INSURANCE RATE MAP (FIRM) INFORMATION


B1. NFIP COMMUNITY NAME & COMMUNITY NUMBER Ocean City 345310		B2. COUNTY NAME Cape May		B3. STATE NJ	
B4. MAP AND PANEL NUMBER 345310 0001	B5. SUFFIX C	B6. FIRM INDEX DATE 7/15/92	B7. FIRM PANEL EFFECTIVE/REVISED DATE 9/5/84	B8. FLOOD ZONE(S) A7	B9. BASE FLOOD ELEVATION(S) (Zone AO, use depth of flooding) g

- B10. Indicate the source of the Base Flood Elevation (BFE) data or base flood depth entered in B9.
 FIS Profile FIRM Community Determined Other (Describe): _____
- B11. Indicate the elevation datum used for the BFE in B9: NGVD 1929 NAVD 1988 Other (Describe): _____
- B12. Is the building located in a Coastal Barrier Resources System (CBRS) area or Otherwise Protected Area (OPA)? Yes No Designation Date _____

SECTION C - BUILDING ELEVATION INFORMATION (SURVEY REQUIRED)


- C1. Building elevations are based on: Construction Drawings* Building Under Construction* Finished Construction
 *A new Elevation Certificate will be required when construction of the building is complete.
- C2. Building Diagram Number 8 (Select the building diagram most similar to the building for which this certificate is being completed - see pages 6 and 7. If no diagram accurately represents the building, provide a sketch or photograph.)
- C3. Elevations - Zones A1-A30, AE, AH, A (with BFE), VE, V1-V30, V (with BFE), AR, AR/A, AR/AE, AR/A1-A30, AR/AH, AR/AO
 Complete Items C3.-a-i below according to the building diagram specified in Item C2. State the datum used. If the datum is different from the datum used for the BFE in Section B, convert the datum to that used for the BFE. Show field measurements and datum conversion calculation. Use the space provided or the Comments area of Section D or Section G, as appropriate, to document the datum conversion.
 Datum NGVD 29 Conversion/Comments _____
- Elevation reference mark used T-2 Does the elevation reference mark used appear on the FIRM? Yes No
- o a) Top of bottom floor (including basement or enclosure) 8.3 ft.(m)
 - o b) Top of next higher floor 10.5 ft.(m)
 - o c) Bottom of lowest horizontal structural member (V zones only) N/A ft.(m)
 - o d) Attached garage (top of slab) 7.7 ft.(m)
 - o e) Lowest elevation of machinery and/or equipment servicing the building (Describe in a Comments area) 10.1 ft.(m)
 - o f) Lowest adjacent (finished) grade (LAG) 7.0 ft.(m)
 - o g) Highest adjacent (finished) grade (HAG) 7.5 ft.(m)
 - o h) No. of permanent openings (flood vents) within 1 ft. above adjacent grade 23
 - o i) Total area of all permanent openings (flood vents) in C3.h 3,795 sq. in. (sq. cm)

License Number, Embossed Seal, Signature, and Date

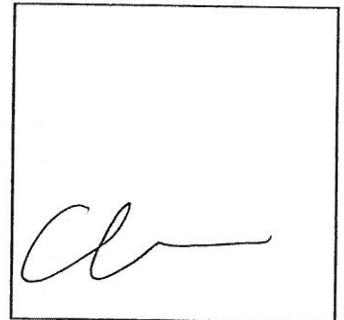

SECTION D - SURVEYOR, ENGINEER, OR ARCHITECT CERTIFICATION

This certification is to be signed and sealed by a land surveyor, engineer, or architect authorized by law to certify elevation information.
 I certify that the information in Sections A, B, and C on this certificate represents my best efforts to interpret the data available.
 I understand that any false statement may be punishable by fine or imprisonment under 18 U.S. Code, Section 1001.

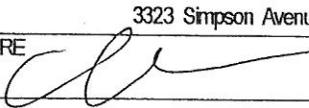CERTIFIER'S NAME David C. Kruger		LICENSE NUMBER NJ Lic. No. 30406	
TITLE Professional Land Surveyor	COMPANY NAME David C. Kruger Associates		
ADDRESS 3323 Simpson Avenue	CITY Ocean City	STATE NJ	ZIP CODE 08226
SIGNATURE 	DATE 4-1-05	TELEPHONE (609) 391-9393	

IMPORTANT: In these spaces, copy the corresponding information from Section A.			For Insurance Company Use:
BUILDING STREET ADDRESS (Including Apt., Unit, Suite, and/or Bldg. No.) OR P.O. ROUTE AND BOX NO. 217 Atlantic Blvd.			Policy Number
CITY Ocean City	STATE NJ	ZIP CODE 08226	Company NAIC Number

SECTION D - SURVEYOR, ENGINEER, OR ARCHITECT CERTIFICATION (CONTINUED)

Copy both sides of this Elevation Certificate for (1) community official, (2) insurance agent/company, and (3) building owner.

COMMENTS

Check here if attachments

SECTION E - BUILDING ELEVATION INFORMATION (SURVEY NOT REQUIRED) FOR ZONE AO AND ZONE A (WITHOUT BFE)

For Zone AO and Zone A (without BFE), complete items E1 through E4. If the Elevation Certificate is intended for use as supporting information for a LOMA or LOMR-F, Section C must be completed.

- E1. Building Diagram Number __ (Select the building diagram most similar to the building for which this certificate is being completed – see pages 6 and 7. If no diagram accurately represents the building, provide a sketch or photograph.)
- E2. The top of the bottom floor (including basement or enclosure) of the building is __ ft.(m) __ in.(cm) above or below (check one) the highest adjacent grade. (Use natural grade, if available).
- E3. For Building Diagrams 6-8 with openings (see page 7), the next higher floor or elevated floor (elevation b) of the building is __ ft.(m) __ in.(cm) above the highest adjacent grade. Complete items C3.h and C3.i on front of form.
- E4. The top of the platform of machinery and/or equipment servicing the building is __ ft.(m) __ in.(cm) above or below (check one) the highest adjacent grade. (Use natural grade, if available).
- E5. For Zone AO only: If no flood depth number is available, is the top of the bottom floor elevated in accordance with the community's floodplain management ordinance?
 Yes No Unknown. The local official must certify this information in Section G.

SECTION F - PROPERTY OWNER (OR OWNER'S REPRESENTATIVE) CERTIFICATION

The property owner or owner's authorized representative who completes Sections A, B, C (Items C3.h and C3.i only), and E for Zone A (without a FEMA-issued or community-issued BFE) or Zone AO must sign here. *The statements in Sections A, B, C, and E are correct to the best of my knowledge.*

PROPERTY OWNER'S OR OWNER'S AUTHORIZED REPRESENTATIVE'S NAME

ADDRESS CITY STATE ZIP CODE

SIGNATURE DATE TELEPHONE

COMMENTS

Check here if attachments

SECTION G - COMMUNITY INFORMATION (OPTIONAL)

The local official who is authorized by law or ordinance to administer the community's floodplain management ordinance can complete Sections A, B, C (or E), and G of this Elevation Certificate. Complete the applicable item(s) and sign below.

- G1. The information in Section C was taken from other documentation that has been signed and embossed by a licensed surveyor, engineer, or architect who is authorized by state or local law to certify elevation information. (Indicate the source and date of the elevation data in the Comments area below.)
- G2. A community official completed Section E for a building located in Zone A (without a FEMA-issued or community-issued BFE) or Zone AO.
- G3. The following information (Items G4-G9) is provided for community floodplain management purposes.

G4. PERMIT NUMBER 20030356	G5. DATE PERMIT ISSUED 2/26/03	G6. DATE CERTIFICATE OF COMPLIANCE/OCCUPANCY ISSUED 9/22/05
-------------------------------	-----------------------------------	--

- G7. This permit has been issued for: New Construction Substantial Improvement
- G8. Elevation of as-built lowest floor (including basement) of the building is: _____ ft.(m) Datum: _____
- G9. BFE or (in Zone AO) depth of flooding at the building site is: _____ ft.(m) Datum: _____

LOCAL OFFICIAL'S NAME TITLE

COMMUNITY NAME TELEPHONE

SIGNATURE DATE

COMMENTS

Check here if attachments

CENTERLINE 7.09'

WEST ATLANTIC (100') BOULEVARD

2005 SEP 14 A.D.

FND. DRILL HOLE
⊕ 10'

FND. DRILL HOLE
⊕ 10'

ARC = 65.00'

R = 786.488'

ARC = 145.00'

LANDING (50') ROAD

LOT 1

120.00' (RADIAL)

TWO STORY DWLG.

BLOCK 70.17

120.00' (RADIAL)

LOT 3

LOT 2

OPEN PORCH

27.6'


FENCE ON LINE

ARC = 55.08'

R = 666.488'

LOT 23

LOT 22

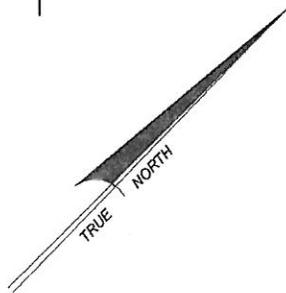

Issued to:

- PALMER DEVELOPERS, LLC.

In consideration of the fee paid for making this survey, I declare that this plan is based on a field survey made by me or under my immediate supervision and to the best of my professional knowledge and belief correctly represents the conditions found as of the date of the field survey shown hereon; except such easements and or structures, if any, that may exist below, on, or above the surface of the lands and not visible.

This declaration is given solely to the above named parties for this transaction only and is not transferable. Surveyor assumes no liability or responsibility for the unauthorized use of this survey for any other purpose, including, but not limited to use of this survey for survey affidavit or resale of property to any party not named herein, either directly or indirectly.

Only signed and sealed copies of this survey shall be considered to be valid. If this survey does not contain a raised seal, it is not an authorized document and may have been altered.

DAVID C. KRUGER

NJ Professional Land Surveyor License No. 30406
NJ Professional Planner License No. 3246

BUILDING ELEVATIONS (NGVD '29) / COVERAGE

ROOF PEAK	= 36.68
BUILDING COVERAGE	= 29.5 %
IMPERVIOUS COVERAGE	= 40.8 %

PLAN OF SURVEY

LOT 2



BLOCK 70.17

CITY OF OCEAN CITY
CAPE MAY COUNTY, NJ

DAVID C. KRUGER ASSOCIATES

Land Surveying — Planning
3323 Simpson Avenue Ocean City, New Jersey

date 3-24-05	drawn PT
scale 1" = 20'	checked DK
revision	date
PROJ. # 8095	