U.S. DEPARTMENT OF HOMELAND SECURITY Federal Emergency Management Agency National Flood Insurance Program

Signature

FEMA Form 81-31 February 2006

ELEVATION CERTIFICATE

Important: Read the instructions on pages 1-8

OMB No. 1660-0008 Expires February 28. 2009

Renlaces all previous editions

HDG # 19538.02	Bk/Pg 1010/4	D SECTION	A - PROPERTY INFO	RMATION 🗸	For Insurance Company Use:				
A1. Building Owner's Name					Policy Number				
A2. Building Street Address (i 319 E. Inlet Road	Company NAIC Number								
City Ocean City State NJ ZIP Code 08226									
A3. Property Description (Lot Lot 8, Block 70.24	and Block Numbers, Tax	Parcel Number,	Legal Description, etc.)						
A4. Building Use (e.g., Residential, Non-Residential, Addition, Accessory, etc.) A5. Latitude/Longitude: Lat. N 39° 17' 28.6" Long. W 74° 33' 24.6" A6. Attach at least 2 photographs of the building if the Certificate is being used to obtain flood insurance. A7. Building Diagram Number 8 A8. For a building with a crawl space or enclosure(s), provide a) Square footage of crawl space or enclosure(s) No. of permanent flood openings in the crawl space or enclosure(s) walls within 1.0 foot above adjacent grade c) Total net area of flood openings in A8.b Section B - FLOOD INSURANCE RATE MAP (FIRM) INFORMATION									
B1. NFIP Community Name &			ounty Name	T	B3. State				
City of Ocean City 3453	10		May County		NJ				
B4. Map/Panel Number 345312 0001	D	RM Index ate 5/92	B7. FIRM Panel Effective/Revised Date 9/5/84	B8. Flood Zone(s) A7	B9. Base Flood Elevation(s) (Zone AO, use base flood depth) 10'				
B10. Indicate the source of the					1				
☐ FIS Profile ☐ FIRM ☐ Community Determined ☐ Other (Describe)									
B11. Indicate elevation datum used for BFE in Item B9: ☑ NGVD 1929 ☐ NAVD 1988 ☐ Other (Describe) B12. Is the building located in a Coastal Barrier Resources System (CBRS) area or Otherwise Protected Area (OPA)? ☐ Yes ☑ No Designation Date ☐ CBRS ☐ OPA									
SECTION C - BUILDING ELEVATION INFORMATION (SURVEY REQUIRED)									
C1. Building elevations are based on: Construction Drawings* Building Under Construction* Finished Construction *A new Elevation Certificate will be required when construction of the building is complete. C2. Elevations – Zones A1-A30, AE, AH, A (with BFE), VE, V1-V30, V (with BFE), AR, AR/A, AR/AE, AR/A1-A30, AR/AH, AR/AO. Complete Items C2.a-g below according to the building diagram specified in Item A7. Benchmark Utilized Vertical Datum Conversion/Comments Check the measurement used.									
a) Top of bottom floor (including	to Rico only)								
	í Li Li Š			feet meters (Puer feet meters (Puer	and the second s				
				feet meters (Puer	to Rico only)				
e) Lowest elevation of ma (Describe type of equi	ervicing the build	ing <u>12.52</u>	feet meters (Puer	to Rico only)					
f) Lowest adjacent (finishg) Highest adjacent (finish				feet meters (Puer neters (Puer neters (Puer					
SECTION D - SURVEYOR, ENGINEER, OR ARCHITECT CERTIFICATION									
This certification is to be signed and sealed by a land surveyor, engineer, or architect authorized by law to certify elevation information. I certify that the information on this Certificate represents my best efforts to interpret the data available. I understand that any false statement may be punishable by fine or imprisonment under 18 U.S. Code, Section 1001.									
□ Check here if comments are provided on back of form.					PLACE				
Certifier's Name Thomas A. Prendergast, PLS			License Numb	er NJ 37604	SEAL HERE				
Title P.L.S.	11/18/2009								
Address 101 East Eighth		Ocean City	/land Design Group State NJ Z	P Code 08226	Those Discolugat				
	-				1				


Telephone 609.398.4477

See reverse side for continuation

Date 11/18/09

MPORTANT: In these spa	aces, copy the corresponding	information from Section	A. F	or Insurance Company Use:
Building Street Address (includi 319 E. Inlet Road	ng Apt., Unit, Suite, and/or Bldg. No	o.) or P.O. Route and Box No.	F	Policy Number
City Ocean City State NJ ZIP	Code 08226		(Company NAIC Number
SE	CTION D - SURVEYOR, ENGIN	IEED OD ADCUITECT CE	TIFICATION (CONTI	MUED
	on Certificate for (1) community offici			
Comments		iai, (2) insurance agenizompan	y, and (3) building owner	•
C2a. Lowest Floor - Crawl Spa C2b. Next Higher Floor - Main C2e. Lowest Mechanicals - Ext	Floor - Elev 12.82			
Signature Thus A	Parliquet-	Date 11/18/09	4 .	☐ Check here if attachmer
SECTION E - BUILDING	ELEVATION INFORMATION	(SURVEY NOT REQUIRED	FOR ZONE AO AND	
E2. For Building Diagrams 6-t (elevation C2.b in the diagrams 6-t). Attached garage (top of sept. Top of platform of maching and platform of maching around the condition of th	ery and/or equipment servicing the lead of	ovided in Section A Items 8 and/ feet meters above or beld building is fee op of the bottom floor elevated in cial must certify this information	or 9 (see page 8 of Instruction ove or below the HA ow the HAG. of meters above accordance with the cor in Section G.	uctions), the next higher floor G. or below the HAG. nmunity's floodplain managemen
COLUMN TO SERVICE SERV	CTION F - PROPERTY OWNER			
r Zone AO must sign here. Th	authorized representative who comp re statements in Sections A, B, and b	E are correct to the best of my k	nowledge.	ssaed of confinding-issued BFE
roperty Owner's or Owner's Au	uthorized Representative's Name			
-	uthorized Representative's Name	City	State	ZIP Code
ddress		Date	Telephone	
ignature comments e local official who is authorize	SECTION G - CON	Date //MUNITY INFORMATION (0 the community's floodplain man	Telephone PTIONAL)	Check here if attachm
ddress signature comments e local official who is authorized G of this Elevation Certificate	SECTION G - CONd by law or ordinance to administer (complete the applicable item(s) a	Date MMUNITY INFORMATION (0 the community's floodplain man	Telephone PPTIONAL) agement ordinance can surement used in Items (Check here if attachmonomplete Sections A, B, C (or E)
e local official who is authorized G of this Elevation Certificate	SECTION G - CON	Date MMUNITY INFORMATION (0 the community's floodplain man and sign below. Check the measentation that has been signed an	DPTIONAL) agement ordinance can burement used in Items C	Check here if attachments of the complete Sections A, B, C (or E), S8. and G9.
e local official who is authorized G of this Elevation Certificate The information in Sect is authorized by law to	SECTION G - COM d by law or ordinance to administer to the applicable item(s) a sion C was taken from other docume certify elevation information. (Indication)	Date //MUNITY INFORMATION (0 the community's floodplain man and sign below. Check the meas entation that has been signed an ate the source and date of the el ated in Zone A (without a FEMA	DPTIONAL) agement ordinance can a surement used in Items of diseased by a licensed sievation data in the Comrissued or community-iss	Check here if attachments area below.)













Replaces all previous editions

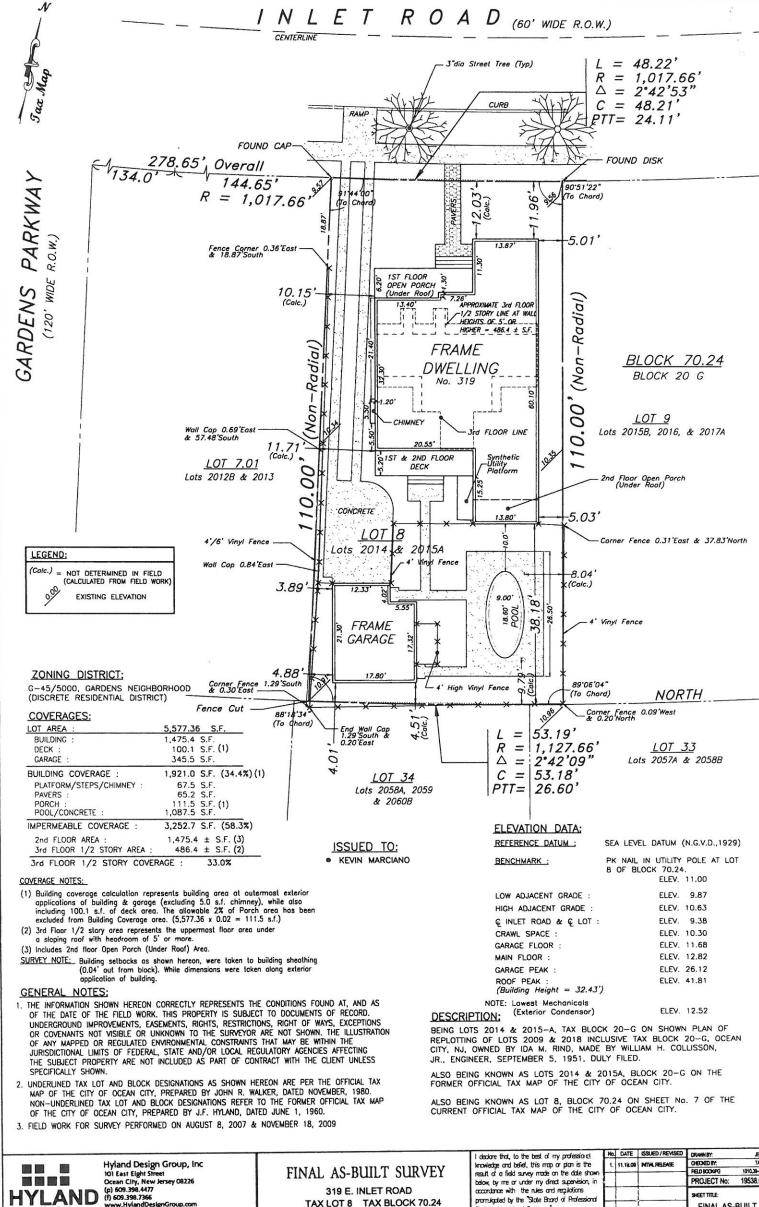

Hyland Design Group, Inc
101 East Eight Street
Ceen City, New Jersey 08226
(p) 609.398.4477
(p) 609.398.7968

The "Single Source Advartage"
EINAL AS-BUILT SURVEY

319 E. INLET ROAD
TAX LOT 8 TAX BLOCK 70.24

OCEAN CITY, CAPE MAY COUNTY
NEW JERSEY

COCPYRIGHT - Hyland Design Group, Inc
Only plans howing a ridsed professional setal are considered to be official and relied upon by the user. This plan has been prepared specifically for the client and project designated herein. No alterations, reproductions or use of any part design. 
