

## FEDERAL EMERGENCY MANAGEMENT AGENCY NATIONAL FLOOD INSURANCE PROGRAM


O.M.B. No. 3067-0077 Expires December 31, 2005

**ELEVATION CERTIFICATE** 

		Important: Re	ead the instructions on p	ages 1 - 7.						
BUILDING OWNER'S N	A 1 4 7	SECTION A	PROPERTY OWNER IN	FORMATION		For Insurance Company Use:				
JAGGLED L.L.C.	CHY	OF OCEAN CITY				Policy Number				
# 123 OCEAN ROAD	DRESS (Including	Apt., Unit, Suite, and/or I	Bldg. No.) OR P.O. ROUTE	AND BOX NO	).	Company NAIC Number				
CITY OCEAN CITY	2005 /	VPR 29 P 12: 0			ZIP C					
PROPERTY DESCRIPTI LOT 12.01 BLOCK 70.33	ON (Lot and Bloc	k Numbers, Tax Parcel N	NJ Number, Legal Description,	etc.)	O8226					
			ory, etc. Use a Comments		ary.)					
LATITUDE/LONGITUDE ( ##° - ##' - ##.##" or ##	(OPTIONAL)	HORIZON	ITAL DATUM; ☐ NAD 1983		E: GPS (Ty	pe): uad Map				
SECTION B - FLOOD INSURANCE RATE MAP (FIRM) INFORMATION										
B1. NFIP COMMUNITY NAME OCEAN CITY 345310	& COMMUNITY NUM	MBER B2	2. COUNTY NAME APE MAY			B3. STATE NJ				
B4. MAP AND PANEL NUMBER 345310 0001	B5. SUFFIX C	B6. FIRM INDEX DATE 7/15/92	B7. FIRM PANEL EFFECTIVE/REVISED D 9/5/84	ATE B8.1	FLOOD ZONE(S)	B9. BASE FLOOD ELEVATION(S) (Zone AO, use depth of flooding)				
B10. Indicate the source of the FIS Profile B11. Indicate the elevation date B12. Is the building located in a	∆J FIRM um used for the BFI a Coastal Barrier Re	ion (BFE) data or base floo Community Determ E in B9: NGVD 1929 esources System (CBRS) a	d depth entered in B9, nined	r (Describe): D 1988	Yes X No	9 Designation Date				
	SEC	LION C - BUILDING EL	EVATION INFORMATIO	N (SURVEY R	EQUIRED)	Decignation Date				
accurately represents the t C3. Elevations – Zones A1-A30	e will be required w 7 (Select the buildin Duilding, provide a s D, AE, AH, A (with B	then construction of the buil ng diagram most similar to ti ketch or photograph.) SFE), VE, V1-V30, V (with F	he building for which this certi	icate is being co	ND/AO					
Section B, convert the datu Section D or Section G, as Datum NGVD 29 Conven	iow according to the im to that used for the appropriate, to doc sion/Comments	e building diagram specified he BFE. Show field measur ument the datum conversion	l in Item C2. State the datum rements and datum conversion.	used. If the datur n calculation. Us	n is different from se the space prov	the datum used for the BFE in ided or the Comments area of				
a) Top of bottom floor (ir b) Top of next higher floo c) Bottom of lowest horiz d) Attached garage (top e) Lowest elevation of m servicing the building f) Lowest adjacent (finish	iculoing basement of contal structural mer of slab) achinery and/or equ (Describe in a Con	or enclosure) mber (V zones only) uipment	used appear on the FIRM?  11. 0ft.(m)  19.5ft.(m)  NAft.(m)  11. 0ft.(m)	□ Yes □ No	eal	Mark D Swarf pls #34844 4/10/5				
g) Highest adjacent (finis	hed) grade (HAG) nings (flood vents) v	within 1 ft. above adjacent of d vents) in C3.hsq. i	10 . <u>8 ft.(m)</u> 11 . <u>2 ft.(m)</u> grade <u>0</u> in. (sq. cm)	*	License Nu Sign					
	SEC	TION D - SURVEYOR,	ENGINEER, OR ARCHIT	ECT CERTIFIC	CATION					
This certification is to be sig I certify that the information I understand that any false of CERTIFIER'S NAME MARK	ned and sealed by in Sections A, B, a statement may be	y a land surveyor, engine and C on this certificate i	eer, or architect authorized	by law to certify to interpret the Code, Section 1	elevation infor					
TITLE LAND SURVEYOR			COMPANY NA	ME DEVAULS	URVEY					
ADDRESS 20 DEVAULS LANE SIGNATURE	16 //		CITY OCEAN VIEW DATE		STATE NJ TELEPHO	ZIP CODE 08230				
Wen	1X M	- and	4/10/05		609-624-0					

	, copy the corresponding information from S g Apt., Unit, Suite, and/or Bldg. No.) OR P.O. ROUTE AND B			For Insurance Company Use:	
# 123 OCEAN AVENUE	g Apt, Offit, Guille, allows Blog. No./ OK P.O. MOOTE AND B	JOX NO.		Policy Number	
CITY OCEAN CITY	STATE NJ	=	ZIP CODE 08266	Company NAIC Number	
S	SECTION D - SURVEYOR, ENGINEER, OR AF	RCHITECT CE	ERTIFICATION (CONTINUE	ED)	
Copy both sides of this Elevation Cer	tificate for (1) community official, (2) insurance agent/o	company, and (	3) building owner.		
COMMENTS THE SURVEYOR ASSUMES NO F	RESPONSIBLITY TO ANY INSUREE OF THIS BUIL	DING OTHER	THAN THE OWNER LISTED	ON THIS CERTIFICATE	
				Check here if attachmer	
SECTION E - BUILDI	NG ELEVATION INFORMATION (SURVEY NO	OT REQUIRE	D) FOR ZONE AO AND ZO		
	E), complete Items E1 through E4. If the Elevation Cer				
ection C must be completed.  1. Building Diagram Number _(Selecting represents the building, provide as	t the building diagram most similar to the building for v	which this certific	cate is being completed – see pa	ages 6 and 7. If no diagram accurate	
natural grade, if available). 3. For Building Diagrams 6-8 with ope	enings (see page 7), the next higher floor or elevated fl				
natural grade, if available).	ry and/or equipment servicing the building isft.(m)				
Yes No Unknown.	h number is available, is the top of the bottom floor ele The local official must certify this information in Section	on G.			
	SECTION F - PROPERTY OWNER (OR OWNE				
The property owner or owner's autho ssued BFE) or Zone AO must sign h	rized representative who completes Sections A, B, C ( ere. The statements in Sections A, B, C, and E are co	(Items C3.h and orrect to the bes	d C3.i only), and E for Zone A (w st of my knowledge.	ithout a FEMA-issued or community	
PROPERTY OWNER'S OR OWNER	R'S AUTHORIZED REPRESENTATIVE'S NAME				
ADDRESS		CITY	STA	TE ZIP CODE	
SIGNATURE		DATE	1	EPHONE	
COMMENTS					
	SECTION C. COMMUNITY IN	FORMATION	LOPTIONAL	Check here if attachmen	
ne local official who is authorized by I	SECTION G - COMMUNITY IN aw or ordinance to administer the community's floodpl			ions A. B. C. (or E) and G. of this Elas	
ertificate. Complete the applicable ite	em(s) and sign below.		<u>.</u>		
1. The information in Section C w	as taken from other documentation that has been sign	ned and embos	ssed by a licensed surveyor, eng	gineer, or architect who is authorized	
or local law to certify elevation  2	information. (Indicate the source and date of the eleved Section E for a building located in Zone A (without a	vation data in the	e Comments area below.)	10	
<ol> <li>The following information (Item</li> </ol>	ns G4-G9) is provided for community floodplain manag	reivia-issueu ( dement purpose	or community-issued BFE) or 20 es.	one AO.	
G4. PERMIT NUMBER	G5. DATE PERMIT ISSUED		G6. DATE CERTIFICATE OF COM	MPLIANCE/OCCUPANCY ISSUED	
7. This permit has been issued for:	New Construction Substantial Improvement		5/3/05		
<ol><li>Elevation of as-built lowest floor (in</li></ol>	cluding basement) of the building is:		ft.(m)	Datum:	
9. BFE or (in Zone AO) depth of flood	ling at the building site is:		ft.(m)	Datum:	
LOCAL OFFICIAL'S NAME		TITL	Е		
COMMUNITY NAME		TELE	EPHONE		
SIGNATURE		DATI	E		
COMMENTS					
		1 ***		Check here if attachmen	
MA Form 81-31, January 2003			<del></del>	Replaces all previous ed	

Replaces all previous editions

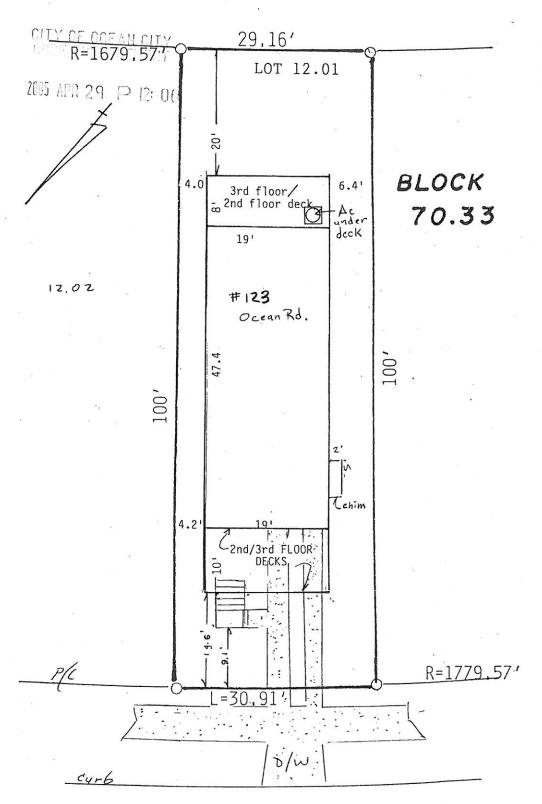

## OCEAN ROAD (60'WIDE)

BUILDING DESCRIPTION:
THREE STORY FRAME AND BLOCK DWELLING

Mark G. DeVaul N.J. Lic. No.

No. 34844

+10.1

FIRST FLOOR ELEVATION =11.0 CENTER LINE ELEVATION = 10.1 ROOF PEAK ELEVATION = 42.4 = 31.4 FEET ABOVE CENTER-LINE LOT COVER = 1,052 s.f. = 35 % IMPERVIOUS COVERAGE = 13445.f. = 44%

THIS SURVEY IS INTENDED FOR USE BY THE MUNICIPAL ZONING, PLANNING/CONSTRUCTION OFFICE AND NOT TO BE USED FOR CONVEYANCE. NO RESPONSIBILITY OR LIABILITY IS ASSUMED BY SURVEYOR FOR USE OF SURVEY FOR ANY OTHER PURPOSE.

FINAL SURVEY

## PLAN OF SURVEY BLOCK 70.33 LOT 12.01 CITY OF OCEAN CITY, CAPE MAY COUNTY, NEW JERSEY SCALE 1 INCH = 15 FEET APRIL 10 , 2005 LAND SURVEYORS DEVAUL SURVEYING 20 DEVAULS LANE, OCEAN VIEW, N.J. 08230 Mark J. DiVaul