

This form is to be used for: 1) Post-FIRM construction only when the base flood information is available for the building site; and 2) Pre-FIRM buildings rated using Post-FIRM rules. Instructions for completing this form can be found on the reverse side.

BUILDING OWNER'S NAME: 803 Seaview Avenue POLICY NUMBER: \_\_\_\_\_  
 STREET ADDRESS: \_\_\_\_\_  
 Apt.-/Unit-U Suite-S/Bldg.-B NO. ROUTE BOX NUMBER  
Block 70.45, Lot 1.01  
 OTHER DESCRIPTION (Block and lot numbers.. etc.)  
Ocean City, NJ 08226  
 CITY STATE ZIP CODE

*This form is to be completed by a land surveyor, engineer, or architect who is authorized by state law to certify elevation information when the elevation information for zones A1-A30, AE, AH, A(with BFE), V1-V30, VE, and V(with BFE) is required. In the case of zone AO, the building official, the property owner, or the owner's representative should complete the information in Section I and may also complete the certification. Community officials who are authorized by local law or ordinance to provide floodplain management information may also complete this form.*

**SECTION I BUILDING ELEVATION INFORMATION**

- Using the Flood Insurance Manual or the NFIP Flood Insurance Application—Part 2 Worksheet, indicate the proper diagram number 6
- FIRM Zones A1-A30, AE, AH, and A (with BFE). The top of the reference level floor from the selected diagram is at an elevation of 11.00 feet NGVD. (or other datum—see #5)
- FIRM Zones V1-V30, VE, and V (with BFE). The bottom of the lowest horizontal structural member of the reference level floor from the selected diagram is at an elevation of \_\_\_\_\_ feet NGVD (or other datum—see #5).
- FIRM Zone AO. The floor used as the reference level from the selected diagram is    feet above highest natural grade next to the building (also enter in line 8). This value must be equal to or greater than the AO Zone flood depth number listed below. If no flood depth number is available, is the building's lowest floor (or reference level) elevated in accordance with the community's floodplain management ordinances?  Yes  No  Unknown
- Indicate the elevation datum system used in determining the above reference level elevations:  NGVD  Other (describe on back)
- Indicate the elevation datum system used on the FIRM for base flood elevations:  NGVD  Other (describe on back)  
 (ATTENTION: If the elevation datum used in measuring the elevations is different than that used on the FIRM, then the elevations provided must be converted to the datum system used on the FIRM.)
- Is the reference level based on actual construction?  Yes  No\*  
 \* A "No" answer is only valid if the building does not have the reference level floor in place. Fill in the elevation based on construction drawings and do not complete question #8. If "No" is checked, this certification will be valid only for buildings in the course of construction. After construction of the reference level floor is completed, a post-construction elevation certificate will be required for continued flood insurance coverage.
- Provide the following measurements using the natural grade next to the building (round to the nearest foot).  
 a. The reference level is: 03 feet  above  below (check one) the highest grade.    feet  above  below (check one) the highest grade.  
03 feet  above  below (check one) the lowest grade.    feet  above  below (check one) the lowest grade.

**SECTION II FLOOD INSURANCE RATE MAP INFORMATION**

Provide the following from the proper FIRM (see instructions on back—Date of FIRM) and accompanying insurance application:

COMMUNITY NO.	PANEL NO.	SUFFIX	DATE OF FIRM	FIRM ZONE	BASE FLOOD ELEV. (In AO Zone, use depth)	COMMUNITY ESTIMATED BASE FLOOD ELEVATION ESTABLISHED FOR ZONE A OR ZONE V, IF AVAILABLE
345310	0001	C	9/5/84	A7	E1 10 ft. MSL	

Elevation reference mark used appears on FIRM  Yes  No (See reverse side for details)

**SECTION III CERTIFICATION**

*This certification is to be signed by a land surveyor, engineer, or architect who is authorized by state law to certify elevation information when the elevation information for zones A1-A30, AE, AH, A(with BFE), V1-V30, VE, and V(with BFE) is required. In the case of zone AO, the building official, the property owner, or the owner's representative can sign the certification. Community officials who are authorized by local law or ordinance to provide floodplain management information, may also sign the certification. I certify that the information on this certificate represents my best efforts to interpret the data available. I understand that any false statement may be punishable by fine or imprisonment under 18 U.S. Code, Section 1001.*


CERTIFIER'S NAME: William C. Burkett, Jr. LICENSE NUMBER (or Affix Seal): NJ 27194  
 TITLE: NJ Professional Land Surveyor COMPANY NAME: Burkett Associates, PA  
 ADDRESS: 323 Simpson Avenue CITY: Ocean City STATE: NJ ZIP: 08226  
 SIGNATURE: [Signature] DATE: 1/11/89 PHONE: (609) 398-2226

The insurance agent should attach the original copy of the completed form to the flood insurance policy application. The second copy should be supplied to the policyholder and the third copy retained by the agent. The fourth copy is for the local community permit office, if required.  
 THIS FORM MAY BE REPRODUCED.

FOR OPTIONAL COMMUNITY USE: Is the reference level also the lowest floor under the community's floodplain management ordinances?  
 YES  NO If NO the elevation of the lowest floor is \_\_\_\_\_ feet NGVD.

SEAVIEW ROAD (60' wide)

WAVERLY BLVD. (60' wide)

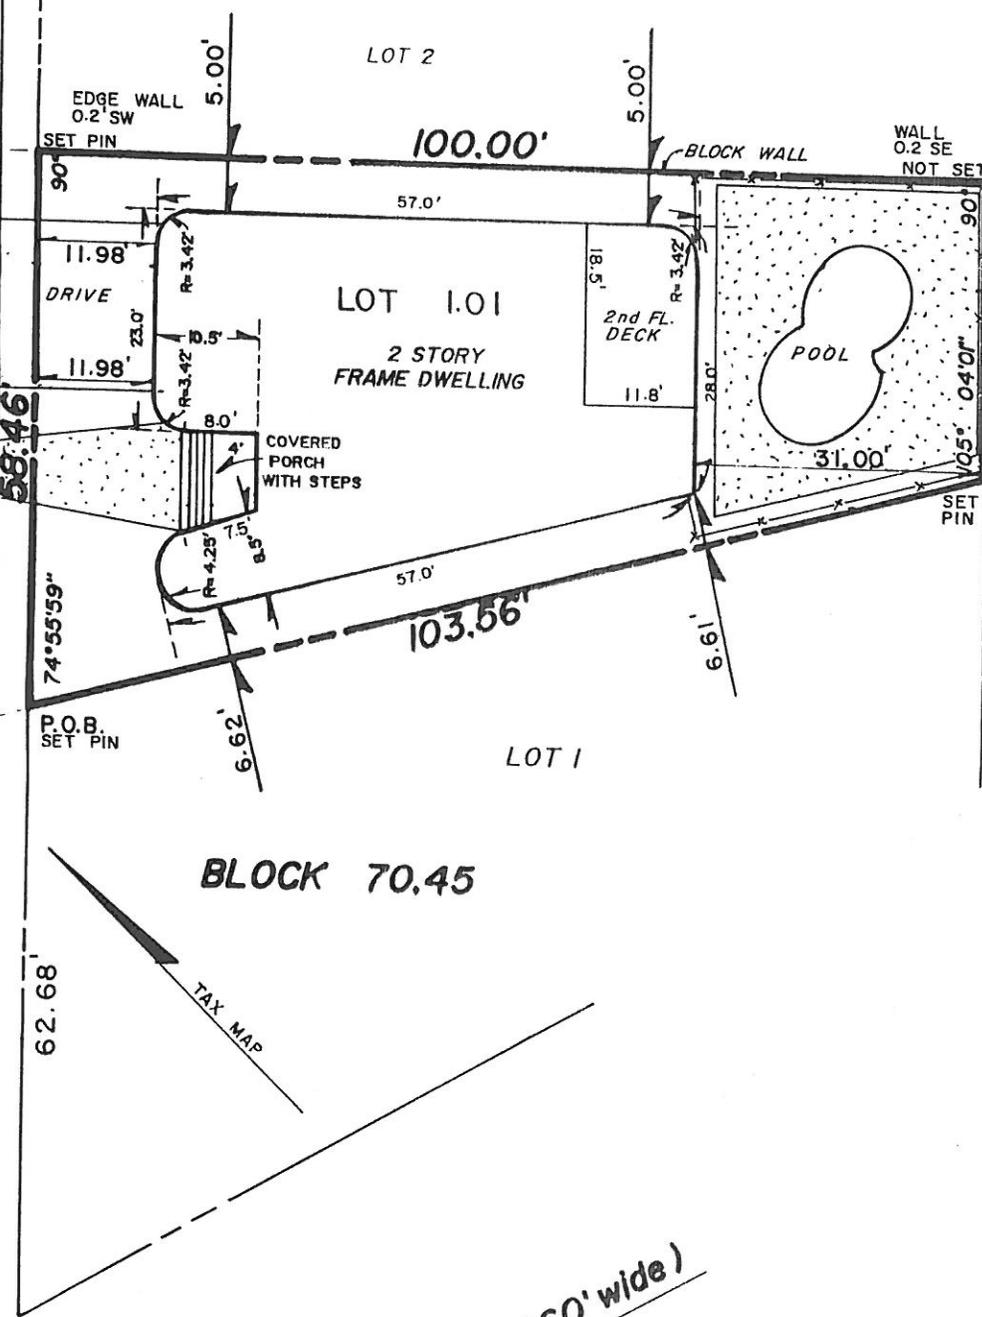

*Will C. Burkett Jr.*  
**WILLIAM C. BURKETT JR.**  
 N.J. LICENSED LAND SURVEYOR NO. 27194  
 N.J. PROFESSIONAL PLANNER NO. 2415

DRAWN BY: C.J.  
 DATE: 4/27/89  
 CHECKED BY: P.J.F.  
 SCALE: 1" = 20'-0"  
 BOOK \_\_\_\_\_ PG. \_\_\_\_\_

**SURVEY OF PROPERTY**  
 LOT 1.01  
 BLOCK 70.45  
 CITY OF OCEAN CITY, CAPE MAY COUNTY, N.J.

CONSULTING ENGINEERS  
 LAND SURVEYORS  
 ARCHITECTS  
**BURKETT ASSOCIATES, P.A.**  
 LANDSCAPE ARCHITECTS  
 PROFESSIONAL PLANNERS  
 3323 SIMPSON AVENUE  
 OCEAN CITY, NEW JERSEY

PROJ. NO. \_\_\_\_\_  
 W.O. NO. 7165  
 SHEET 1 OF 1  
 DWG. NO.: \_\_\_\_\_  
 S- 3498

ISSUED TO :  
 WARREN LANDI, Jr.  
 SHORELINE CONSTRUCTION

NOTES :  
 BEING PROPOSED LOT 1.01, BLOCK 70.45, AS SHOWN ON PLAN ENTITLED, " PLAN OF SUBDIVISION, LOT NO. 1, BLOCK NO. 70.45, CITY OF OCEAN CITY, CAPE MAY COUNTY, N.J. ", AS PREPARED BY BURKETT ASSOCIATES P.A., 3-16-88

TOTAL TRACT AREA = 4500 SQ. FT. ±

ELEVATIONS : ( N.G.V.D. 1929 )  
 Q SEAVIEW ROAD 8.08'  
 Q WAVERLY BLVD. 8.10'  
 AVERAGE GRADE 8.3'  
 TOP ROOF PEAK 34.13'  
 BOTTOM ROOF EAVE 28.55'  
 LOWEST FLOOR 11.07'

D.K.  
 D.S.E. 6/16/86