



BUILDING STREET ADDRESS (Including Apt., Unit, Suite, and/or Bldg. No.) OR P.O. ROUTE AND BOX NO.  
902 Seacliff Road

Policy Number

CITY  
Ocean City

STATE  
NJ

ZIP CODE

Company NAIC Number

**SECTION D - SURVEYOR, ENGINEER, OR ARCHITECT CERTIFICATION (CONTINUED)**

Copy both sides of this Elevation Certificate for (1) community official, (2) insurance agent/company, and (3) building owner.

**COMMENTS**

C3e= Air unit elevation is 21.50, Duct work elevation is 10.75

Check here if attachments

**SECTION E - BUILDING ELEVATION INFORMATION (SURVEY NOT REQUIRED) FOR ZONE AO AND ZONE A (WITHOUT BFE)**

For Zone AO and Zone A (without BFE), complete Items E1 through E4. If the Elevation Certificate is intended for use as supporting information for a LOMA or LOMR-F, Section C must be completed.

- E1. Building Diagram Number \_\_ (Select the building diagram most similar to the building for which this certificate is being completed – see pages 6 and 7. If no diagram accurately represents the building, provide a sketch or photograph.)
- E2. The top of the bottom floor (including basement or enclosure) of the building is \_\_ ft.(m) \_\_ in.(cm)  above or  below (check one) the highest adjacent grade. (Use natural grade, if available).
- E3. For Building Diagrams 6-8 with openings (see page 7), the next higher floor or elevated floor (elevation b) of the building is \_\_ ft.(m) \_\_ in.(cm) above the highest adjacent grade. Complete items C3.h and C3.i on front of form.
- E4. The top of the platform of machinery and/or equipment servicing the building is \_\_ ft.(m) \_\_ in.(cm)  above or  below (check one) the highest adjacent grade. (Use natural grade, if available).
- E5. For Zone AO only: If no flood depth number is available, is the top of the bottom floor elevated in accordance with the community's floodplain management ordinance?  
 Yes  No  Unknown. The local official must certify this information in Section G.

**SECTION F - PROPERTY OWNER (OR OWNER'S REPRESENTATIVE) CERTIFICATION**

The property owner or owner's authorized representative who completes Sections A, B, C (Items C3.h and C3.i only), and E for Zone A (without a FEMA-issued or community-issued BFE) or Zone AO must sign here. *The statements in Sections A, B, C, and E are correct to the best of my knowledge.*

PROPERTY OWNER'S OR OWNER'S AUTHORIZED REPRESENTATIVE'S NAME

ADDRESS

CITY

STATE

ZIP CODE

SIGNATURE

DATE

TELEPHONE

COMMENTS

Check here if attachments

**SECTION G - COMMUNITY INFORMATION (OPTIONAL)**

The local official who is authorized by law or ordinance to administer the community's floodplain management ordinance can complete Sections A, B, C (or E), and G of this Elevation Certificate. Complete the applicable item(s) and sign below.

- G1.  The information in Section C was taken from other documentation that has been signed and embossed by a licensed surveyor, engineer, or architect who is authorized by state or local law to certify elevation information. (Indicate the source and date of the elevation data in the Comments area below.)
- G2.  A community official completed Section E for a building located in Zone A (without a FEMA-issued or community-issued BFE) or Zone AO.
- G3.  The following information (Items G4-G9) is provided for community floodplain management purposes.

G4. PERMIT NUMBER 000116	G5. DATE PERMIT ISSUED 11/10/05	G6. DATE CERTIFICATE OF COMPLIANCE/OCCUPANCY ISSUED 12/15/06
-----------------------------	------------------------------------	---

G7. This permit has been issued for:  New Construction  Substantial Improvement

G8. Elevation of as-built lowest floor (including basement) of the building is:

\_\_\_ ft.(m)

Datum: \_\_\_

G9. BFE or (in Zone AO) depth of flooding at the building site is:

\_\_\_ ft.(m)

Datum: \_\_\_

LOCAL OFFICIAL'S NAME

TITLE

COMMUNITY NAME


TELEPHONE

SIGNATURE

DATE

COMMENTS


Check here if attachments

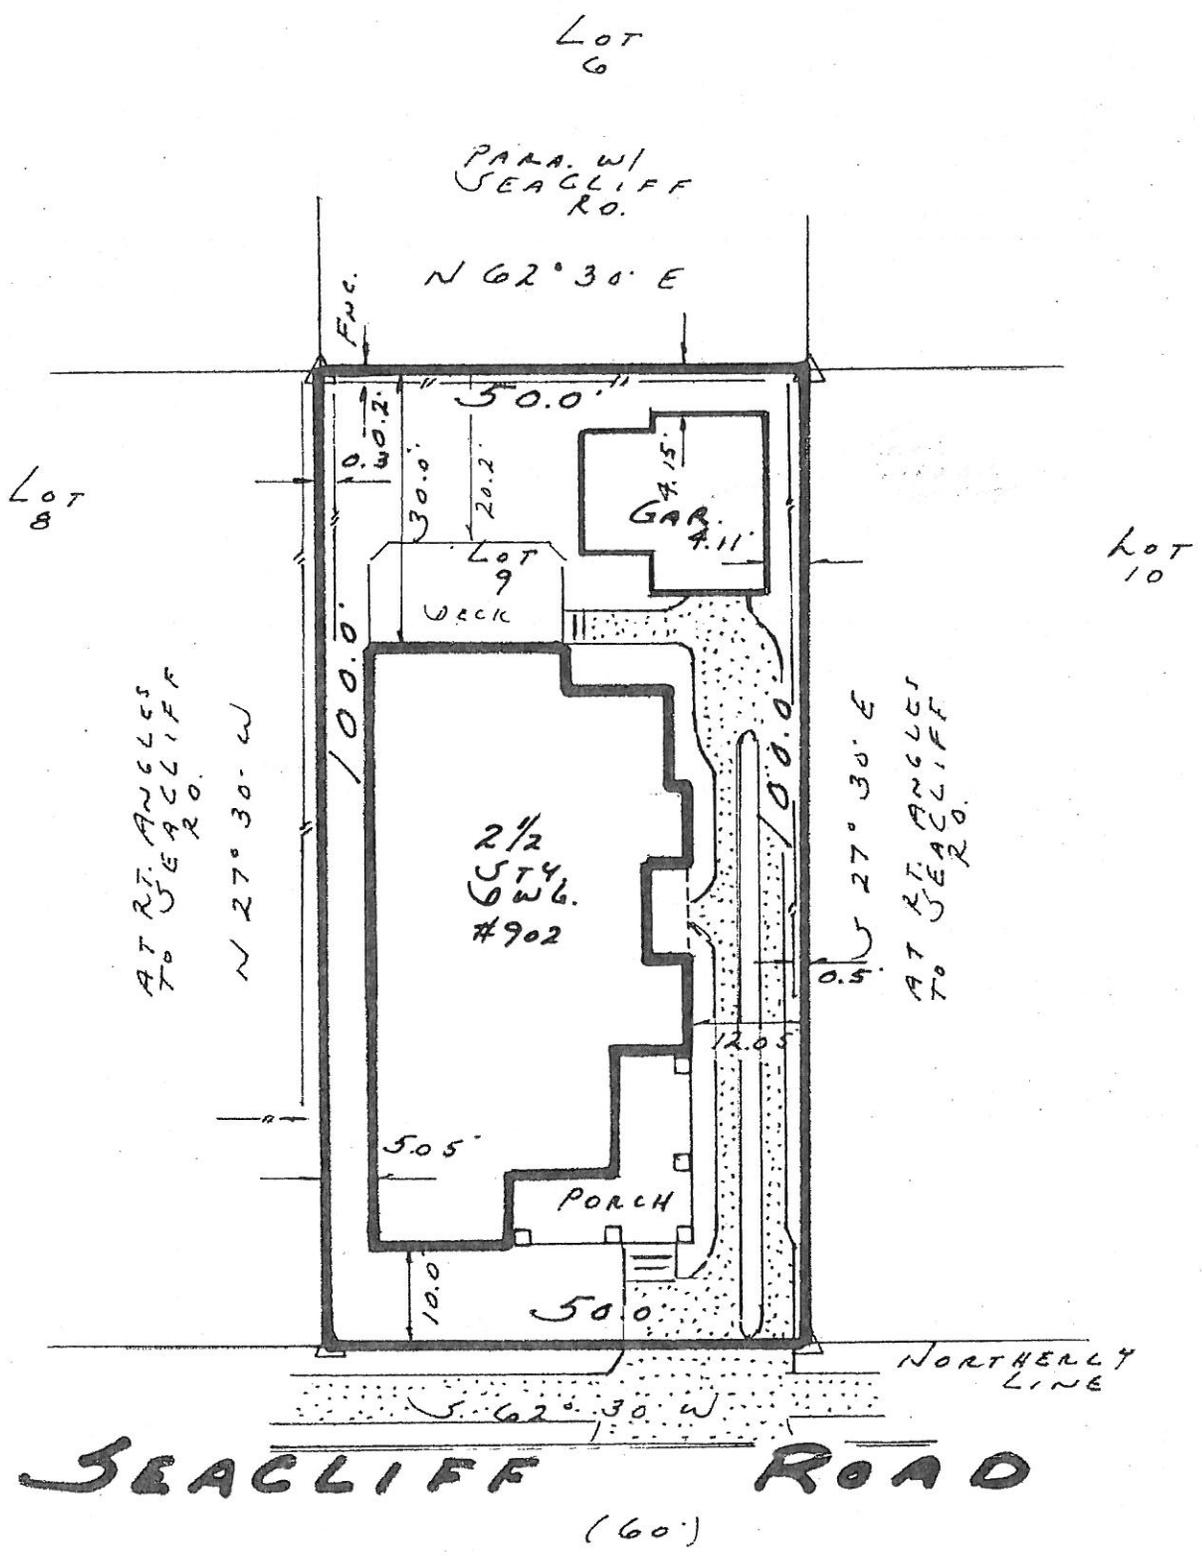

**COVERAGE AND HEIGHT**

Lot Area	- 5,000 sq. ft.
Building Area	' 33.6%
Garage Area	6.2%
Total Coverage	59%
3 <sup>rd</sup> Floor Area above 5'	- 754 sq. ft.
	51.4% of 2 <sup>nd</sup> Floor Area
Centerline Elevation	- 9.13 ft.
Bldg. Peak Elevation	- 42.06 ft.
Building Height	- 32.93 ft. above centerline
Garage Peak Elevation	- 23.85 ft.
Garage Height	- 14.72 ft. above centerline

UPDATED 11/22/06 - FINAL SW  
 UPDATED 4/10/06 - AS PER 20N  
 Δ = IRON BAR

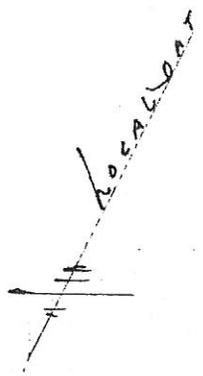

**GENERAL NOTES:**

As shown only for checking compliance with deed conditions and zoning regulations. Offsets shall not be used for any purposes. Surveyor shall not have any responsibility or liability for offsets shown other than as intended.  
 Property is subject to any documents of record, either recorded or unrecorded, including but not limited to easements, property line

In consideration of the mutual covenants and promises contained in the agreement between above named parties and the undersigned, the provisions of which are incorporated herein by reference, I declare that this plan is based on a field survey made on \_\_\_\_\_ by me or under my immediate supervision in accordance with N.J.A.C. 13:40-5.1, and to the best of my professional knowledge, information and belief.

**SURVEY OF**  
 SITUA  
 CITY OF O.  
 CAPE MAY C.