

# ELEVATION CERTIFICATE

Important: Read the instructions on pages 1-9.

OMB No. 1660-0008  
Expires March 31, 2012

## SECTION A - PROPERTY INFORMATION

A1. Building Owner's Name Pasquale W. Croce

For Insurance Company Use:

Policy Number

A2. Building Street Address (including Apt., Unit, Suite, and/or Bldg. No.) or P.O. Route and Box No.  
909 Seacliff Road

Company NAIC Number

City OCEAN CITY State NJ ZIP Code 08226

A3. Property Description (Lot and Block Numbers, Tax Parcel Number, Legal Description, etc.)  
Block 70.51 lot 1

A4. Building Use (e.g., Residential, Non-Residential, Addition, Accessory, etc.) Residential

A5. Latitude/Longitude: Lat. N 39.2940 Long. W 074.5536

Horizontal Datum: ☐ NAD 1927 ☒ NAD 1983

A6. Attach at least 2 photographs of the building if the Certificate is being used to obtain flood insurance.

A7. Building Diagram Number 8

A8. For a building with a crawlspace or enclosure(s):

- a) Square footage of crawlspace or enclosure(s) 2000 sq ft  
b) No. of permanent flood openings in the crawlspace or enclosure(s) within 1.0 foot above adjacent grade n/a  
c) Total net area of flood openings in A8.b n/a sq in  
d) Engineered flood openings? ☐ Yes ☒ No

A9. For a building with an attached garage:

- a) Square footage of attached garage 300 sq ft  
b) No. of permanent flood openings in the attached garage within 1.0 foot above adjacent grade n/a  
c) Total net area of flood openings in A9.b n/a sq in  
d) Engineered flood openings? ☐ Yes ☒ No

## SECTION B - FLOOD INSURANCE RATE MAP (FIRM) INFORMATION

B1. NFIP Community Name & Community Number  
City of Ocean City 345310

B2. County Name  
Cape May

B3. State  
NJ

B4. Map/Panel Number  
345310/0001

B5. Suffix  
C

B6. FIRM Index  
Date  
7/15/92

B7. FIRM Panel  
Effective/Revised Date  
9/5/84

B8. Flood  
Zone(s)  
A7

B9. Base Flood Elevation(s) (Zone  
AO, use base flood depth)  
10.0

B10. Indicate the source of the Base Flood Elevation (BFE) data or base flood depth entered in Item B9.

☐ FIS Profile ☒ FIRM ☐ Community Determined ☐ Other (Describe) \_\_\_\_\_

B11. Indicate elevation datum used for BFE in Item B9: ☒ NGVD 1929 ☐ NAVD 1988 ☐ Other (Describe) \_\_\_\_\_

B12. Is the building located in a Coastal Barrier Resources System (CBRS) area or Otherwise Protected Area (OPA)? ☐ Yes ☒ No  
Designation Date \_\_\_\_\_ ☐ CBRS ☐ OPA

## SECTION C - BUILDING ELEVATION INFORMATION (SURVEY REQUIRED)

C1. Building elevations are based on: ☐ Construction Drawings\* ☐ Building Under Construction\* ☒ Finished Construction  
\*A new Elevation Certificate will be required when construction of the building is complete.

C2. Elevations - Zones A1-A30, AE, AH, A (with BFE), VE, V1-V30, V (with BFE), AR, AR/A, AR/AE, AR/A1-A30, AR/AH, AR/AO. Complete Items C2.a-h below according to the building diagram specified in Item A7. Use the same datum as the BFE.

Benchmark Utilized n/a Vertical Datum NGVD29

Conversion/Comments \_\_\_\_\_

Check the measurement used.

- a) Top of bottom floor (including basement, crawlspace, or enclosure floor) 10.5 ☒ feet ☐ meters (Puerto Rico only)  
b) Top of the next higher floor 13.3 ☒ feet ☐ meters (Puerto Rico only)  
c) Bottom of the lowest horizontal structural member (V Zones only) n/a ☒ feet ☐ meters (Puerto Rico only)  
d) Attached garage (top of slab) 11.3 ☒ feet ☐ meters (Puerto Rico only)  
e) Lowest elevation of machinery or equipment servicing the building 11.5 ☒ feet ☐ meters (Puerto Rico only)  
(Describe type of equipment and location in Comments)  
f) Lowest adjacent (finished) grade next to building (LAG) 10.3 ☒ feet ☐ meters (Puerto Rico only)  
g) Highest adjacent (finished) grade next to building (HAG) 10.7 ☒ feet ☐ meters (Puerto Rico only)  
h) Lowest adjacent grade at lowest elevation of deck or stairs, including<sup>2</sup> structural support 10.0 ☒ feet ☐ meters (Puerto Rico only)

## SECTION D - SURVEYOR, ENGINEER, OR ARCHITECT CERTIFICATION

This certification is to be signed and sealed by a land surveyor, engineer, or architect authorized by law to certify elevation information. I certify that the information on this Certificate represents my best efforts to interpret the data available. I understand that any false statement may be punishable by fine or imprisonment under 18 U.S. Code, Section 1001.

☒ Check here if comments are provided on back of form.

Were latitude and longitude in Section A provided by a licensed land surveyor? ☒ Yes ☐ No

Certifier's Name Paul H. Koelling, PLS

License Number NJ 24GS 02177100

Title Licensed Land Surveyor

Company Name PAUL H. KOELLING & ASSOCIATES, LLC

Address 2161 Shore Road

City Linwood

State NJ

ZIP Code 08221

Signature

Date 5/14/09

Telephone (609)927-0279


PLACE  
SEAL  
HERE

<b>IMPORTANT: In these spaces, copy the corresponding information from Section A.</b>		<b>For Insurance Company Use</b>	
Building Street Address (including Apt., Unit, Suite, and/or Bldg. No.) or P.O. Route and Box No. 909 Seacliff Road		Policy Number	
City Ocean CityState NJ ZIP Code 08226		Company NAIC Number	

**SECTION D - SURVEYOR, ENGINEER, OR ARCHITECT CERTIFICATION (CONTINUED)**

Copy both sides of this Elevation Certificate for (1) community official, (2) insurance agent/company, and (3) building owner.

Comments Pool equipment elevation is 11.0

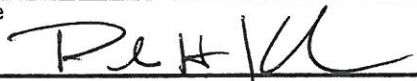Signature  Date 5/14/09 ☐ Check here if attachments

**SECTION E - BUILDING ELEVATION INFORMATION (SURVEY NOT REQUIRED) FOR ZONE AO AND ZONE A (WITHOUT BFE)**

For Zones AO and A (without BFE), complete Items E1-E5. If the Certificate is intended to support a LOMA or LOMR-F request, complete Sections A, B, and C. For Items E1-E4, use natural grade, if available. Check the measurement used. In Puerto Rico only, enter meters.

E1. Provide elevation information for the following and check the appropriate boxes to show whether the elevation is above or below the highest adjacent grade (HAG) and the lowest adjacent grade (LAG).

a) Top of bottom floor (including basement, crawlspace, or enclosure) is \_\_\_\_\_ ☐ feet ☐ meters ☐ above or ☐ below the HAG.

b) Top of bottom floor (including basement, crawlspace, or enclosure) is \_\_\_\_\_ ☐ feet ☐ meters ☐ above or ☐ below the LAG.

E2. For Building Diagrams 6-9 with permanent flood openings provided in Section A Items 8 and/or 9 (see pages 8-9 of Instructions), the next higher floor (elevation C2.b in the diagrams) of the building is \_\_\_\_\_ ☐ feet ☐ meters ☐ above or ☐ below the HAG.

E3. Attached garage (top of slab) is \_\_\_\_\_ ☐ feet ☐ meters ☐ above or ☐ below the HAG.

E4. Top of platform of machinery and/or equipment servicing the building is \_\_\_\_\_ ☐ feet ☐ meters ☐ above or ☐ below the HAG.

E5. Zone AO only: If no flood depth number is available, is the top of the bottom floor elevated in accordance with the community's floodplain management ordinance? ☐ Yes ☐ No ☐ Unknown. The local official must certify this information in Section G.

**SECTION F - PROPERTY OWNER (OR OWNER'S REPRESENTATIVE) CERTIFICATION**

The property owner or owner's authorized representative who completes Sections A, B, and E for Zone A (without a FEMA-issued or community-issued BFE) or Zone AO must sign here. *The statements in Sections A, B, and E are correct to the best of my knowledge.*

Property Owner's or Owner's Authorized Representative's Name \_\_\_\_\_

Address _____	City _____	State _____	ZIP Code _____
Signature _____	Date _____	Telephone _____	
Comments _____			

☐ Check here if attachments

**SECTION G - COMMUNITY INFORMATION (OPTIONAL)**

The local official who is authorized by law or ordinance to administer the community's floodplain management ordinance can complete Sections A, B, C (or E), and G of this Elevation Certificate. Complete the applicable item(s) and sign below. Check the measurement used in Items G8 and G9.

G1. ☐ The information in Section C was taken from other documentation that has been signed and sealed by a licensed surveyor, engineer, or architect who is authorized by law to certify elevation information. (Indicate the source and date of the elevation data in the Comments area below.)

G2. ☐ A community official completed Section E for a building located in Zone A (without a FEMA-issued or community-issued BFE) or Zone AO.

G3. ☐ The following information (Items G4-G9) is provided for community floodplain management purposes.

G4. Permit Number 20071298	G5. Date Permit Issued 8/22/07	G6. Date Certificate Of Compliance/Occupancy Issued 5/22/09
-------------------------------	-----------------------------------	--

G7. This permit has been issued for: ☐ New Construction ☐ Substantial Improvement

G8. Elevation of as-built lowest floor (including basement) of the building: \_\_\_\_\_ ☐ feet ☐ meters (PR) Datum \_\_\_\_\_


G9. BFE or (in Zone AO) depth of flooding at the building site: \_\_\_\_\_ ☐ feet ☐ meters (PR) Datum \_\_\_\_\_

G10. Community's design flood elevation \_\_\_\_\_ ☐ feet ☐ meters (PR) Datum \_\_\_\_\_

Local Official's Name _____	Title _____
Community Name _____	Telephone _____
Signature _____	Date _____
Comments _____	



SEACLIFF ROAD (60.)

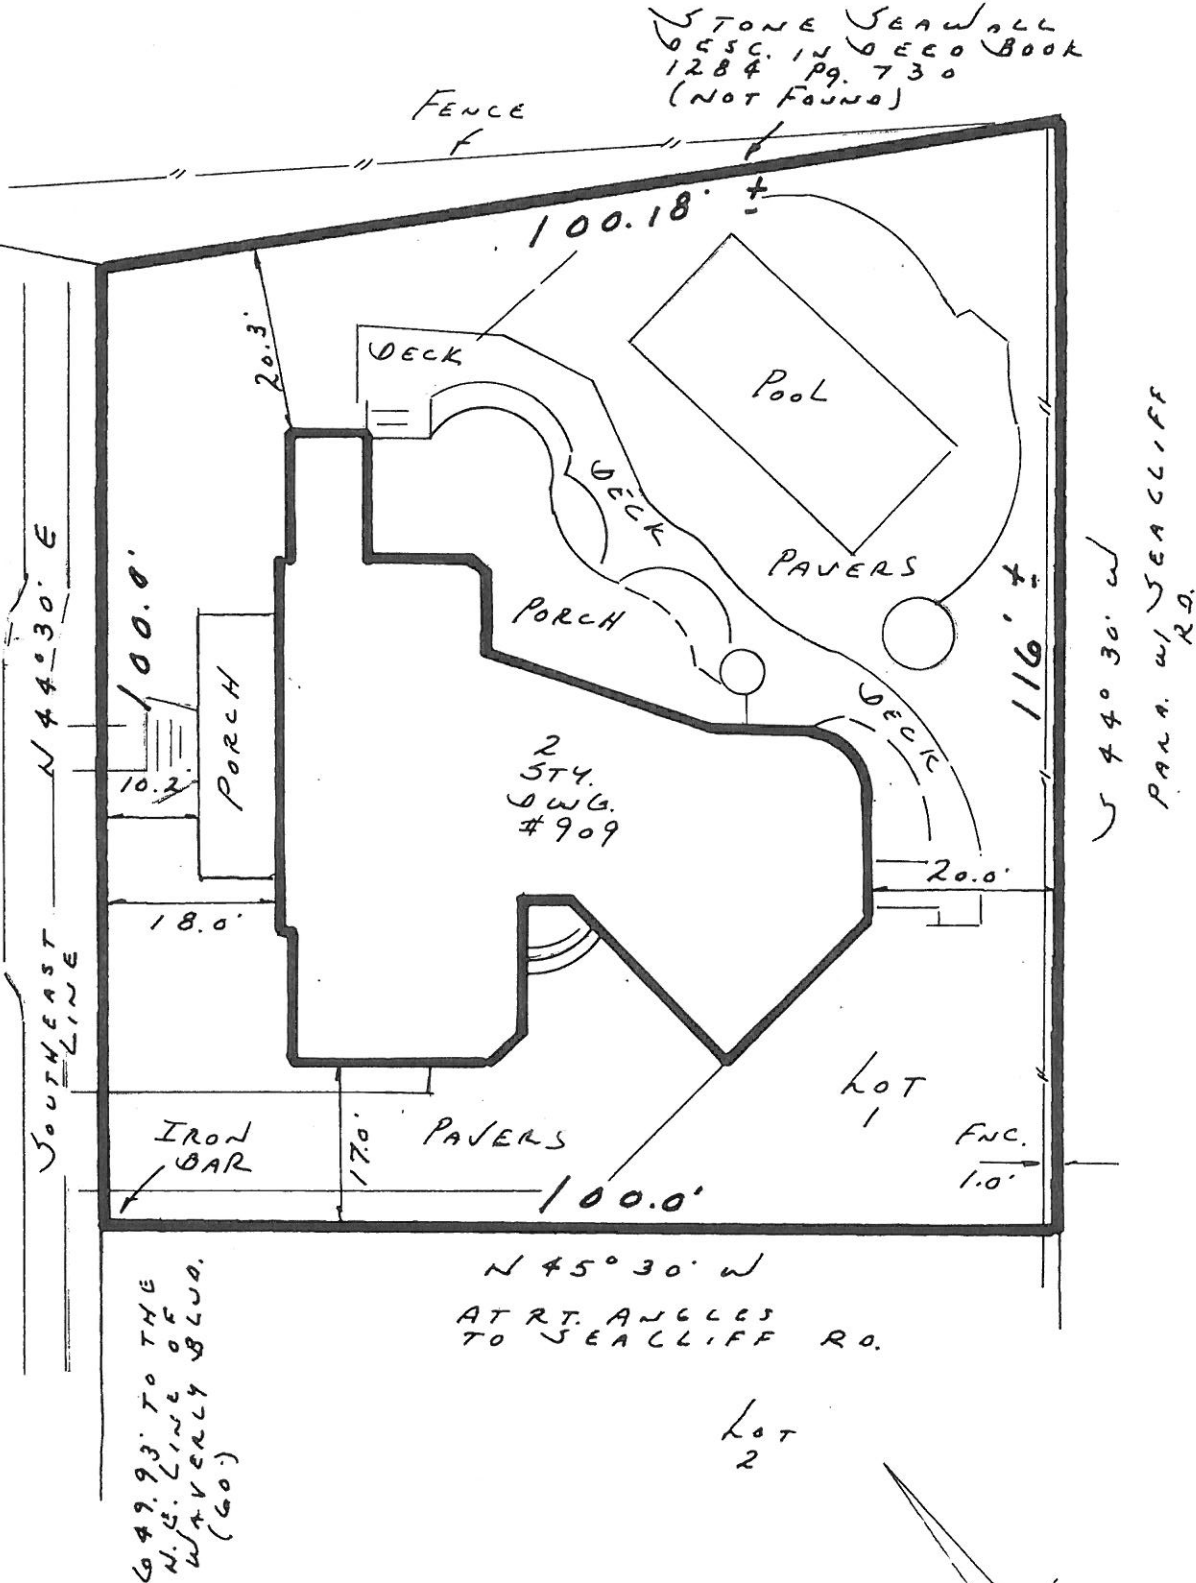

### NOTES

BLOG. COVERAGE = 30%  
TOTAL SITE COVERAGE = 59%

Pasquale W. Croce

### GENERAL NOTES:

This plan is prepared only for checking compliance with deed restrictions and zoning provisions and shall not be used for any other purposes. Surveyor shall not be liable for any errors or omissions in the plan or for any damages resulting therefrom.

This plan is subject to any documents of record, either recorded or unrecorded, which may affect the property shown hereon. Surveyor reserves the right to modify this plan if such information becomes available.



In consideration of the mutual covenants and promises contained in the agreement between the above named parties and the undersigned, the provisions of which are incorporated herein by reference, I declare that this plan is based on a field survey made on the date of the field survey, except such easements, if any, below the surface of the lands or on the surface of the lands and not visible, and to the best of my professional knowledge, information and belief.

a) correctly represents the conditions found at and as of the date of the field survey, except such easements, if any, below the surface of the lands or on the surface of the lands and not visible, and to the best of my professional knowledge, information and belief.

b) except as shown on the plan, there are no discrepancies between the boundary lines of the subject property as shown on the plan and as described in the legal description of record.

This plan is made to provide information to the title insurer so that it may insure title to the lands shown herein and for the mortgage holder named above. This declaration is given solely to the above

### SURVEY OF PL

SITUATE IN  
CITY OF OCEAN C  
COUNTY OF CAPE M

BLOCK 70.51 L

PAUL H. KOE