

FEDERAL EMERGENCY MANAGEMENT AGENCY
NATIONAL FLOOD INSURANCE PROGRAM

O.M.B. No. 3067-0077
Expires December 31, 2005

ELEVATION CERTIFICATE

Important: Read the instructions on pages 1 - 7.

SECTION A - PROPERTY OWNER INFORMATION

| | | | | | |
|--|--|--|----------------------------|--|--|
| BUILDING OWNER'S NAME RJR Development Company, LLC | | | For Insurance Company Use: | | |
| BUILDING STREET ADDRESS (Including Apt., Unit, Suite, and/or Bldg. No.) OR P.O. ROUTE AND BOX NO. 709 Gardens Parkway | | | Policy Number | | |
| CITY Ocean City | | | STATE NJ | ZIP CODE 08226 | |
| PROPERTY DESCRIPTION (Lot and Block Numbers, Tax Parcel Number, Legal Description, etc.) Lot 2, Block 70.55 | | | | | |
| BUILDING USE (e.g., Residential, Non-residential, Addition, Accessory, etc. Use a Comments area, if necessary.) residential | | | | | |
| LATITUDE/LONGITUDE (OPTIONAL) (##° - ##' - ###.###" or ##.#####°) | | HORIZONTAL DATUM: <input type="checkbox"/> NAD 1927 <input type="checkbox"/> NAD 1983 | | SOURCE: <input type="checkbox"/> GPS (Type): _____ <input type="checkbox"/> USGS Quad Map <input type="checkbox"/> Other: _____ | |

SECTION B - FLOOD INSURANCE RATE MAP (FIRM) INFORMATION

| | | | | | |
|---|-----------------|--------------------------------|---|-------------------------|--|
| B1. NFIP COMMUNITY NAME & COMMUNITY NUMBER Ocean City 345310 | | B2. COUNTY NAME Cape May | | B3. STATE NJ | |
| B4. MAP AND PANEL NUMBER 345310 0001 | B5. SUFFIX C | B6. FIRM INDEX DATE 7/15/92 | B7. FIRM PANEL EFFECTIVE/REVISED DATE 9/5/84 | B8. FLOOD ZONE(S) A7 | B9. BASE FLOOD ELEVATION(S) (Zone AO, use depth of flooding) 10' |

B10. Indicate the source of the Base Flood Elevation (BFE) data or base flood depth entered in B9.
 FIS Profile FIRM Community Determined Other (Describe): _____

B11. Indicate the elevation datum used for the BFE in B9: NGVD 1929 NAVD 1988 Other (Describe): _____

B12. Is the building located in a Coastal Barrier Resources System (CBRS) area or Otherwise Protected Area (OPA)? Yes No Designation Date _____

SECTION C - BUILDING ELEVATION INFORMATION (SURVEY REQUIRED)

C1. Building elevations are based on: Construction Drawings* Building Under Construction* Finished Construction
 *A new Elevation Certificate will be required when construction of the building is complete.

C2. Building Diagram Number 8 (Select the building diagram most similar to the building for which this certificate is being completed - see pages 6 and 7. If no diagram accurately represents the building, provide a sketch or photograph.)

C3. Elevations - Zones A1-A30, AE, AH, A (with BFE), VE, V1-V30, V (with BFE), AR, AR/A, AR/AE, AR/A1-A30, AR/AH, AR/AO
 Complete items C3.-a-i below according to the building diagram specified in item C2. State the datum used. If the datum is different from the datum used for the BFE in Section B, convert the datum to that used for the BFE. Show field measurements and datum conversion calculation. Use the space provided or the Comments area of Section D or Section G, as appropriate, to document the datum conversion.
 Datum NGVD 29 Conversion/Comments _____

Elevation reference mark used T-2 Does the elevation reference mark used appear on the FIRM? Yes No

- o a) Top of bottom floor (including basement or enclosure) 8. 8 ft.(m)
- o b) Top of next higher floor 11. 7 ft.(m)
- o c) Bottom of lowest horizontal structural member (V zones only) N/A. ft.(m)
- o d) Attached garage (top of slab) 8. 8 ft.(m)
- o e) Lowest elevation of machinery and/or equipment servicing the building (Describe in a Comments area) 10. 6 ft.(m)
- o f) Lowest adjacent (finished) grade (LAG) 8. 2 ft.(m)
- o g) Highest adjacent (finished) grade (HAG) 8. 7 ft.(m)
- o h) No. of permanent openings (flood vents) within 1 ft. above adjacent grade 21
- o i) Total area of all permanent openings (flood vents) in C3.h 4725* sq. in. (sq. cm)

License Number, Embossed Seal, Signature, and Date

SECTION D - SURVEYOR, ENGINEER, OR ARCHITECT CERTIFICATION

This certification is to be signed and sealed by a land surveyor, engineer, or architect authorized by law to certify elevation information.
 I certify that the information in Sections A, B, and C on this certificate represents my best efforts to interpret the data available.
 I understand that any false statement may be punishable by fine or imprisonment under 18 U.S. Code, Section 1001.

CERTIFIER'S NAME David C. Kruger LICENSE NUMBER NJ Lic. No. 30406

TITLE Professional Land Surveyor COMPANY NAME David C. Kruger Associates

ADDRESS 3323 Simpson Avenue CITY Ocean City STATE NJ ZIP CODE 08226

SIGNATURE DATE 04-10-2006 TELEPHONE (609) 391-9393

| | | | |
|--|-------------|-------------------|----------------------------|
| IMPORTANT: In these spaces, copy the corresponding information from Section A. | | | For Insurance Company Use: |
| BUILDING STREET ADDRESS (Including Apt., Unit, Suite, and/or Bldg. No.) OR P.O. ROUTE AND BOX NO. 709 Gardens Parkway | | | Policy Number |
| CITY Ocean City | STATE NJ | ZIP CODE 08226 | Company NAIC Number |

SECTION D - SURVEYOR, ENGINEER, OR ARCHITECT CERTIFICATION (CONTINUED)

Copy both sides of this Elevation Certificate for (1) community official, (2) insurance agent/company, and (3) building owner.

COMMENTS
FLOOD VENT AREA ON REVERSE SIDE = GROSS AREA

Check here if attachments

SECTION E - BUILDING ELEVATION INFORMATION (SURVEY NOT REQUIRED) FOR ZONE AO AND ZONE A (WITHOUT BFE)

For Zone AO and Zone A (without BFE), complete Items E1 through E4. If the Elevation Certificate is intended for use as supporting information for a LOMA or LOMR-F, Section C must be completed.

- E1. Building Diagram Number (Select the building diagram most similar to the building for which this certificate is being completed – see pages 6 and 7. If no diagram accurately represents the building, provide a sketch or photograph.)
- E2. The top of the bottom floor (including basement or enclosure) of the building is ___ ft.(m) ___ in.(cm) above or below (check one) the highest adjacent grade. (Use natural grade, if available).
- E3. For Building Diagrams 6-8 with openings (see page 7), the next higher floor or elevated floor (elevation b) of the building is ___ ft.(m) ___ in.(cm) above the highest adjacent grade. Complete items C3.h and C3.i on front of form.
- E4. The top of the platform of machinery and/or equipment servicing the building is ___ ft.(m) ___ in.(cm) above or below (check one) the highest adjacent grade. (Use natural grade, if available).
- E5. For Zone AO only: If no flood depth number is available, is the top of the bottom floor elevated in accordance with the community's floodplain management ordinance?
 Yes No Unknown. The local official must certify this information in Section G.

SECTION F - PROPERTY OWNER (OR OWNER'S REPRESENTATIVE) CERTIFICATION

The property owner or owner's authorized representative who completes Sections A, B, C (Items C3.h and C3.i only), and E for Zone A (without a FEMA-issued or community-issued BFE) or Zone AO must sign here. *The statements in Sections A, B, C, and E are correct to the best of my knowledge.*

PROPERTY OWNER'S OR OWNER'S AUTHORIZED REPRESENTATIVE'S NAME

ADDRESS CITY STATE ZIP CODE

SIGNATURE DATE TELEPHONE

COMMENTS

Check here if attachments

SECTION G - COMMUNITY INFORMATION (OPTIONAL)

The local official who is authorized by law or ordinance to administer the community's floodplain management ordinance can complete Sections A, B, C (or E), and G of this Elevation Certificate. Complete the applicable item(s) and sign below.

- G1. The information in Section C was taken from other documentation that has been signed and embossed by a licensed surveyor, engineer, or architect who is authorized by state or local law to certify elevation information. (Indicate the source and date of the elevation data in the Comments area below.)
- G2. A community official completed Section E for a building located in Zone A (without a FEMA-issued or community-issued BFE) or Zone AO.
- G3. The following information (Items G4-G9) is provided for community floodplain management purposes.

| | | |
|-------------------------------|-----------------------------------|---|
| G4. PERMIT NUMBER 20051538 | G5. DATE PERMIT ISSUED 8/25/05 | G6. DATE CERTIFICATE OF COMPLIANCE/OCCUPANCY ISSUED 12/19/07 |
|-------------------------------|-----------------------------------|---|

G7. This permit has been issued for: New Construction Substantial Improvement

G8. Elevation of as-built lowest floor (including basement) of the building is: _____ ft.(m) Datum: _____

G9. BFE or (in Zone AO) depth of flooding at the building site is: _____ ft.(m) Datum: _____

LOCAL OFFICIAL'S NAME TITLE

COMMUNITY NAME TELEPHONE


SIGNATURE DATE

COMMENTS

Check here if attachments

GAR

DUNDEE ROAD
6.87
(60')

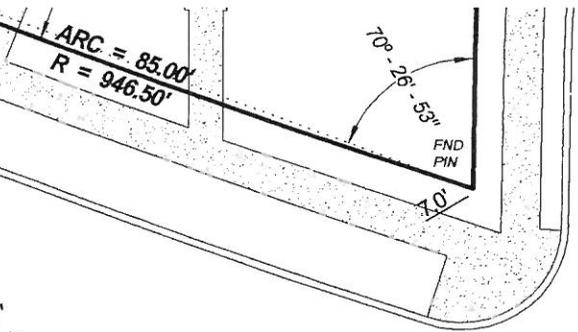

Issued to:

- RJR DEVELOPMENT COMPANY, LLC

BUILDING ELEVATIONS (NGVD '29) / COVERAGE

ROOF PEAK = 39.92'
 BUILDING COVERAGE (INCL. COV. PORCH) = 30.0 %
 HALF STORY COVERAGE = 37.8 %
 IMPERVIOUS COVERAGE = 40.1 %

7.3' = EXISTING SPOT ELEVATION

PLAN OF SURVEY

LOT 2 **BLOCK 70.55**

CITY OF OCEAN CITY
CAPE MAY COUNTY, NJ

DAVID C. KRUGER ASSOCIATES

Land Surveying — Planning
3323 Simpson Avenue Ocean City, New Jersey

In consideration of the fee paid for making this survey, I declare that this plan is based on a field survey made by me or under my immediate supervision and to the best of my professional knowledge and belief correctly represents the conditions found as of the date of the field survey shown hereon; except such easements and or structures, if any, that may exist below, on, or above the surface of the lands and not visible.

This declaration is given solely to the above named parties for this transaction only and is not transferable. Surveyor assumes no liability or responsibility for the unauthorized use of this survey for any other purpose, including, but not limited to use of this survey for survey affidavit or resale of property to any party not named herein, either directly or indirectly.

Only signed and sealed copies of this survey shall be considered to be valid. If this survey does not contain a raised seal, it is not an authorized document and may have been altered.

DAVID C. KRUGER

NJ Professional Land Surveyor License No. 30406
NJ Professional Planner License No. 3246

| | | | |
|-------|----------------|---------|----|
| date | 04 - 10 - 2006 | drawn | PT |
| scale | 1" = 20' | checked | DK |

| | | | |
|----------|------|---------|-----------------|
| revision | date | PROJ. # | 8436 - 2 |
|----------|------|---------|-----------------|

