W07409 FEDERAL EMERGENCY MANAGEMENT AGENCY NATIONAL FLOOD INSURANCE PROGRAM This form is to be used for 1) Post-FIRM construction only when the base flood information is available for the building site; and 2) Pre-FIRM buildings rated using Post-FIRM rules.

Instructions for completing this form can be found on the reverse side.

		42							
BUILDING OWNER'S NAME				POLICY NUMBER					
5 Brittany	Drive								
STREET ADDRESS							***************************************		
AptA/Unit-U Suite-S/BldgB NC				ROUTE BOX NUMBER				MBER	
Block 70.67									
OTHER DESCRIPTION		bers., etc.)							
Ocean City,	NJ 08226						STAT	E	ZIP CODE
This form is to be co information for zones owner, or the owner' authorized by local la	s A1-A30, AE, Al 's representative	H, A(with BFE), should comple to provide floo	, V1-V30, VE, and ete the information dplain manageme	I V(with BFE) is red in Section I and r ent information may	quired. In the may also cor also comple	e case of zone mplete the ce ete this form.	e AO the build	ing official.	the property
		SECT	TION I BUIL	DING ELEVATION	N INFORM	MATION			
 Using the Flood FIRM Zones A1- elevation of <u>1</u> FIRM Zones V1- 	-A30, AE, AH, 0 . 90 feet -V30, VE, and	and A (with E NGVD. (or ot V (with BFE)	BFE). The top o her datum-see . The bottom of	f the reference le #5) the lowest horiz	evel floor fr	om the sele	cted diagram	is at an	
the selected diagram is at an elevation offeet NGVD (or other datum—see #5). 4. FIRM Zone AO. The floor used as the reference level from the selected diagram isfeet above highest natural grade next to the building (also enter in line 8). This value must be equal to or greater than the AO Zone flood depth number listed below. If no flood depth number is available, is the building's lowest floor (or reference level) elevated in accordance with the community's									
flood depth num floodplain mana			ding's lowest flo		level) eleva	ated in acco	rdance with t	he commu	inity's
5. Indicate the elev	ation datum s				ce level ele	evations:X	NGVD Oth	ner (descri	ibe on back)
6. Indicate the elevation datum system used on the FIRM for base flood elevations: X NGVD Other (describe on back)									
(ATTENTION: must be conv	If the elevation erted to the datu	datum used in m system used	measuring the eld on the FIRM.)	evations is differen	t than that u	sed on the Fi	IRM, then the e	elevations p	rovided
tion drawings a construction. A continued floor 8. Provide the follor a. The reference	er is only valid and do not con after construction insurance con wing measure belowe belowed by the control of	if the building nplete question of the reference verage. ments using own (check on	g does not have on #8. If "No" is rence level floot the natural gradue) the highest of	the reference less checked, this confidence is completed, and the but to the but the b	certification a post-cons ilding (rour garage flo	will be valided truction elected to the new or (if application above by the box box by the box by the truction of the box by by the box by by the box by by the box by	d only for bui vation certificates arest foot). able) is: pelow (check of	Idings in tate will be	he course of required for ighest grade.
U3 feet A	above bel		e) the lowest g				elow (check of	one) the lo	west grade.
		SECTION	II FLOOD IN	ISURANCE RAT	E MAP INF	ORMATION	l		
Provide the following	ng from the pr	oper FIRM (s	ee Instructions	on back-Date of	FIRM) and	daccompany	ying insuranc	e applicati	on:
345310	PANEL NO. 0001	SUFFIX	DATE OF FIRM 9/5/84	FIRM ZONE	(In A0 Zon	OOD ELEV. e, use depth)	COMMUNITY E ELEVATION ES OR ZON	STIMATED I STABLISHED IE V, IF AVAI	FOR ZONE A
					1	f.t MSL			
Elevation reference	e mark used a	ppears on FI		No (See revers		details)			
TE: ""		land	SECTION			to lov: to	fu alonatica int	armation wit	on the
This certification is to elevation information property owner, or the floodplain management the data available. I	n for zones A1-A. ne owner's repre ent information.	30, AE, AH, A(sentative can s mav also sign	with BFE), V1-V30 sign the certification the certification. I), VE, and V(with B on. Community offic certify that the info	BFE) is requi cials who are ormation on	red. In the ca e authorized t this certificate	se of zone AO, by local law or e represents my	the buildin ordinance to best effort	g official, the looprovide
William C.	Burkett, 3	ſr.		NJ 27	194				
CERTIFIER'S NAME						JMBER (or Affix	(Seal)		
NJ Professi	onal Land	Surveyor				ciates,	PA		
TITLE				COMPANY NAME				0.0	006
3323 Simpso	n Avenue			Ocean CITY	City		NJ STATE	08: Z	226
1.7111/ 0	Drinkin					7/26/89	A	398-2	226
SIGNATURE	1 2 00					DATE	F	HONE	
The insurance age	nt should attach t policyholder and	he original copy the third copy re	tained by the agent	orm to the flood insurt. The fourth copy is	for the local of	pplication. The community perr	second copy sh mit office, if requ	ould be suppired.	olied to the

94 27 241

SURVEYOR NO. 24

N.J. LICENSED LAND PROFESSIONAL

20

g.

9

BOOK

JERSEY

OCEAN CITY, CAPE MAY COUNTY, NEW

9F

CITY

PROFESSIONAL PLANNERS

3323 SIMPSON AVENUE OCEAN CITY, NEW JERSEY

LANDSCAPE ARCHITECTS

CONSULTING ENGINEERS

LAND SURVEYORS

ARCHITECTS

PLANNER

C. BURKET

WILLIAM

83


/27/

9 B

DATE:

CHECKED SCALE:

BLOCK 70.67

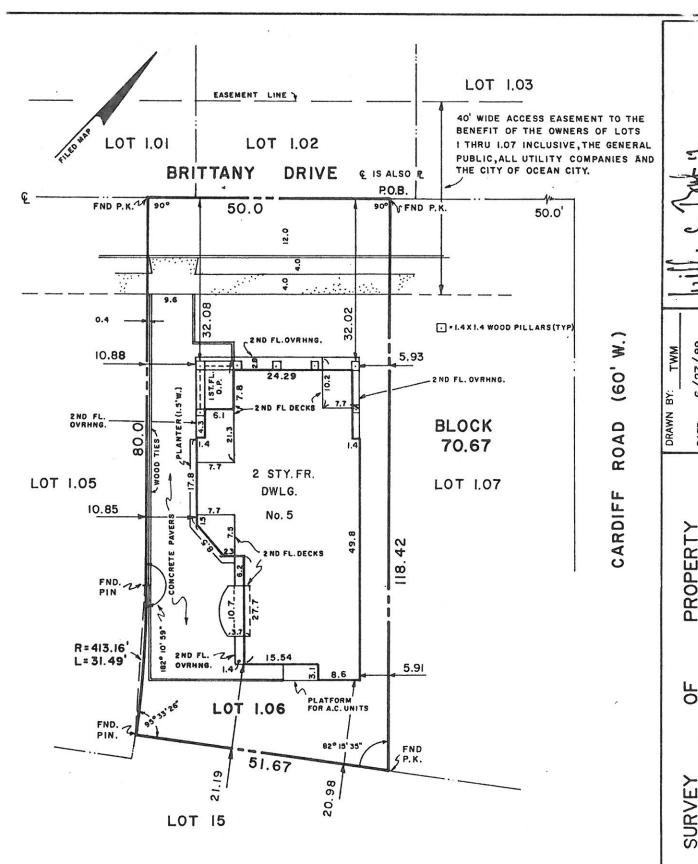

ELEVATIONS DATUM NGVD 1929

8.08 BRITTANY DRIVE TOP OF ROOF PEAK 37,20 BOTTOM OF ROOF EAVE 28.2 AVG. GRADE 8.4

ISSUED TO:

S.W.E. 9/5/89

LOW FLOOR

SEASIDE INVESTMENTS

Any insurer of title relying nersen and any other ty in interest:

In consideration of the fee paid for making this irvey I hereby certify to its accuracy (except such sements, if any, that may exist below the surface of e land or on the surface of the lands and not visible) an inducement for any insurer of title to insure the te to the lands and premises as shown therein. The certification is made only to above named parties or purchase and/or mortgage of herein delineated property by above named purchaser. No responsibility or bility is assumed by Surveyor for use of survey for any other purpose including but not limited to, use of urvey for survey affidavit, resale of property, or to any other person not listed in certification, either directly or indirectly.

BEING LOT 1.06, BLOCK 70.67 ON PLAN OF MAJOR SUBDIVISION, LOTS 1,1.01 AND 1.02, BLOCK 70.67, CITY OF OCEAN CITY, CAPE MAY COUNTY, NEW JERSEY BY MICHAEL W. HYLAND ASSOCIATES P. A. REVISED TO 7/23/87 DULY FILED

11.08

TOGETHER WITH AND SUBJECT TO A 40' WIDE ACCESS EASEMENT KNOWN AS BRITTANY DRIVE AS SHOWN ON THE ABOVE REFERENCED PLAN.

TOTAL TRACT AREA = 5763.8 ± S.F.

ASSOCIATES: P.A. PROJ. NO. 7409 W.O. NO. . SHEET . DWG. NO .: 3550