FEDERAL EMERGENCY MANAGEMENT AGENCY
NATIONAL FLOOD INSURANCE PROGRAM

ELEVATION CERTIFICATE

O.M.B. No. 3067-0077
Expires December 31, 2005

Important: Read the instructions on pages 1 - 7.

SECTION A - PROPERTY OWNER INFORMATION

For Insurance Company Use:

BUILDING OWNER'S NAME: SCOTT HALLIDAY

Policy Number:

BUILDING STREET ADDRESS (Including Apt., Unit, Suite, and/or Bldg. No.) OR P.O. ROUTE AND BOX NO.: 846 FIRST STREET

Company NAIC Number:

CITY: OCEAN CITY, STATE: NJ ZIP CODE: 08226

PROPERTY DESCRIPTION (Lot and Block Numbers, Tax Parcel Number, Legal Description, etc.)
BLOCK 102 LOT 22

BUILDING USE (e.g., Residential, Non-residential, Addition, Accessory, etc. Use a Comments area, if necessary.)
RESIDENTIAL

LATITUDE/LONGITUDE (OPTIONAL) (##° - ##' - ##.##" or ##.#####°)
HORIZONTAL DATUM: ☐ NAD 1927 ☐ NAD 1983
SOURCE: ☐ GPS (Type):____ ☐ USGS Quad Map ☐ Other: ____

SECTION B - FLOOD INSURANCE RATE MAP (FIRM) INFORMATION

B1. NFIP COMMUNITY NAME & COMMUNITY NUMBER	B2. COUNTY NAME	B3. STATE
345310 0001 C	CAPE MAY	NJ

B4. MAP AND PANEL NUMBER	B5. SUFFIX	B6. FIRM INDEX DATE	B7. FIRM PANEL EFFECTIVE/REVISED DATE	B8. FLOOD ZONE(S)	B9. BASE FLOOD ELEVATION(S) (Zone AO, use depth of flooding)
345310 0001	C	7/15/92	9/5/84	A7	10

B10. Indicate the source of the Base Flood Elevation (BFE) data or base flood depth entered in B9.
☐ FIS Profile ☒ FIRM ☐ Community Determined ☐ Other (Describe): ____

B11. Indicate the elevation datum used for the BFE in B9: ☒ NGVD 1929 ☐ NAVD 1988 ☐ Other (Describe): ____

B12. Is the building located in a Coastal Barrier Resources System (CBRS) area or Otherwise Protected Area (OPA)? ☐ Yes ☒ No Designation Date____

SECTION C - BUILDING ELEVATION INFORMATION (SURVEY REQUIRED)

C1. Building elevations are based on: ☐ Construction Drawings* ☐ Building Under Construction* ☒ Finished Construction
*A new Elevation Certificate will be required when construction of the building is complete.

C2. Building Diagram Number 8 (Select the building diagram most similar to the building for which this certificate is being completed - see pages 6 and 7. If no diagram accurately represents the building, provide a sketch or photograph.)

C3. Elevations – Zones A1-A30, AE, AH, A (with BFE), VE, V1-V30, V (with BFE), AR, AR/A, AR/AE, AR/A1-A30, AR/AH, AR/AO
Complete Items C3.-a-i below according to the building diagram specified in Item C2. State the datum used. If the datum is different from the datum used for the BFE in Section B, convert the datum to that used for the BFE. Show field measurements and datum conversion calculation. Use the space provided or the Comments area of Section D or Section G, as appropriate, to document the datum conversion.

Datum NGS Conversion/Comments ____

Elevation reference mark used _____ Does the elevation reference mark used appear on the FIRM? ☐ Yes ☒ No

o a) Top of bottom floor (including basement or enclosure)	8.5 ft.(m)
o b) Top of next higher floor	13.3 ft.(m)
o c) Bottom of lowest horizontal structural member (V zones only)	N/A ft.(m)
o d) Attached garage (top of slab)	8.5 ft.(m)
o e) Lowest elevation of machinery and/or equipment servicing the building (Describe in a Comments area)	13.3 ft.(m)
o f) Lowest adjacent (finished) grade (LAG)	8.3 ft.(m)
o g) Highest adjacent (finished) grade (HAG)	8.5 ft.(m)
o h) No. of permanent openings (flood vents) within 1 ft. above adjacent grade	12
o i) Total area of all permanent openings (flood vents) in C3.h	2592 sq. in. (sq. cm)

License Number, and Signature, and
THOMAS N. TOLBERT
NJ LIC. 38608

SECTION D - SURVEYOR, ENGINEER, OR ARCHITECT CERTIFICATION

This certification is to be signed and sealed by a land surveyor, engineer, or architect authorized by law to certify elevation information.
I certify that the information in Sections A, B, and C on this certificate represents my best efforts to interpret the data available.
I understand that any false statement may be punishable by fine or imprisonment under 18 U.S. Code, Section 1001.

CERTIFIER'S NAME: THOMAS N. TOLBERT LICENSE NUMBER: 38608

TITLE: PROFESSIONAL LAND SURVEYOR COMPANY NAME: DESIGN LAND SURVEYING

ADDRESS: 341 ROUTE 168 CITY: TURNERSVILLE STATE: NJ ZIP CODE: 08012

SIGNATURE: DATE: 1-20-04 TELEPHONE: 856-374-1134

REV: 3.25.04 (FINAL)

IMPORTANT: In these spaces, copy the corresponding information from Section A.	For Insurance Company Use:
BUILDING STREET ADDRESS (Including Apt., Unit, Suite, and/or Bldg. No.) OR P.O. ROUTE AND BOX NO. 846 FIRST STREET	Policy Number
CITY: OCEAN CITY, STATE: NJ ZIP CODE: 08226	Company NAIC Number

SECTION D - SURVEYOR, ENGINEER, OR ARCHITECT CERTIFICATION (CONTINUED)

Copy both sides of this Elevation Certificate for (1) community official, (2) insurance agent/company, and (3) building owner.

COMMENTS

☐ Check here if attachments

SECTION E - BUILDING ELEVATION INFORMATION (SURVEY NOT REQUIRED) FOR ZONE AO and ZONE A (WITHOUT BFE)

For Zone AO and Zone A (without BFE), complete Items E1 through E3. *If the Elevation Certificate is intended for use as supporting information for a LOMA or LOMR-F, Section C must be completed.*

E1. Building Diagram Number _____ (Select the building diagram most similar to the building for which this certificate is being completed – see pages 6 and 7. If no diagram accurately represents the building, provide a sketch or photograph.)

E2. The top of the bottom floor (including basement or enclosure) of the building is ☐☐ ft.(m) ☐☐ in.(cm) ☐ above or ☐ below (check one) the highest adjacent grade.

E3. For Zone AO only: If no flood depth number is available, is the top of the bottom floor elevated in accordance with the community's floodplain management ordinance? ☐ Yes ☐ No ☐ Unknown. The local official must certify this information in Section G.

SECTION F - PROPERTY OWNER (OR OWNER'S REPRESENTATIVE) CERTIFICATION

The property owner or owner's authorized representative who completes Sections A, B, and E for Zone A (without a FEMA-issued or community-issued BFE) or Zone AO must sign here.

PROPERTY OWNER'S OR OWNER'S AUTHORIZED REPRESENTATIVE'S NAME

ADDRESS | CITY | STATE | ZIP CODE

SIGNATURE | DATE | TELEPHONE

COMMENTS

☐ Check here if attachments

SECTION G - COMMUNITY INFORMATION (OPTIONAL)

The local official who is authorized by law or ordinance to administer the community's floodplain management ordinance can complete Sections A, B, C (or E), and G of this Elevation Certificate. Complete the applicable item(s) and sign below.

G1. ☐ The information in Section C was taken from other documentation that has been signed and embossed by a licensed surveyor, engineer, or architect who is authorized by state or local law to certify elevation information. (Indicate the source and date of the elevation data in the Comments area below.)

G2. ☐ A community official completed Section E for a building located in Zone A (without a FEMA-issued or community-issued BFE) or Zone AO.

G3. ☐ The following information (Items G4-G9) is provided for community floodplain management purposes.

G4. PERMIT NUMBER	G5. DATE PERMIT ISSUED	G6. DATE CERTIFICATE OF COMPLIANCE/OCCUPANCY ISSUED
03-2067/2068	10/26/03	3/31/04

G7. This permit has been issued for: ☐ New Construction ☐ Substantial Improvement

G8. Elevation of as-built lowest floor (including basement) of the building is: _____.___ ft.(m) Datum: _____

G9. BFE or (in Zone AO) depth of flooding at the building site is: _____.___ ft.(m) Datum: _____

LOCAL OFFICIAL'S NAME | TITLE

COMMUNITY NAME | TELEPHONE

SIGNATURE | DATE

COMMENTS

☐ Check here if attachments

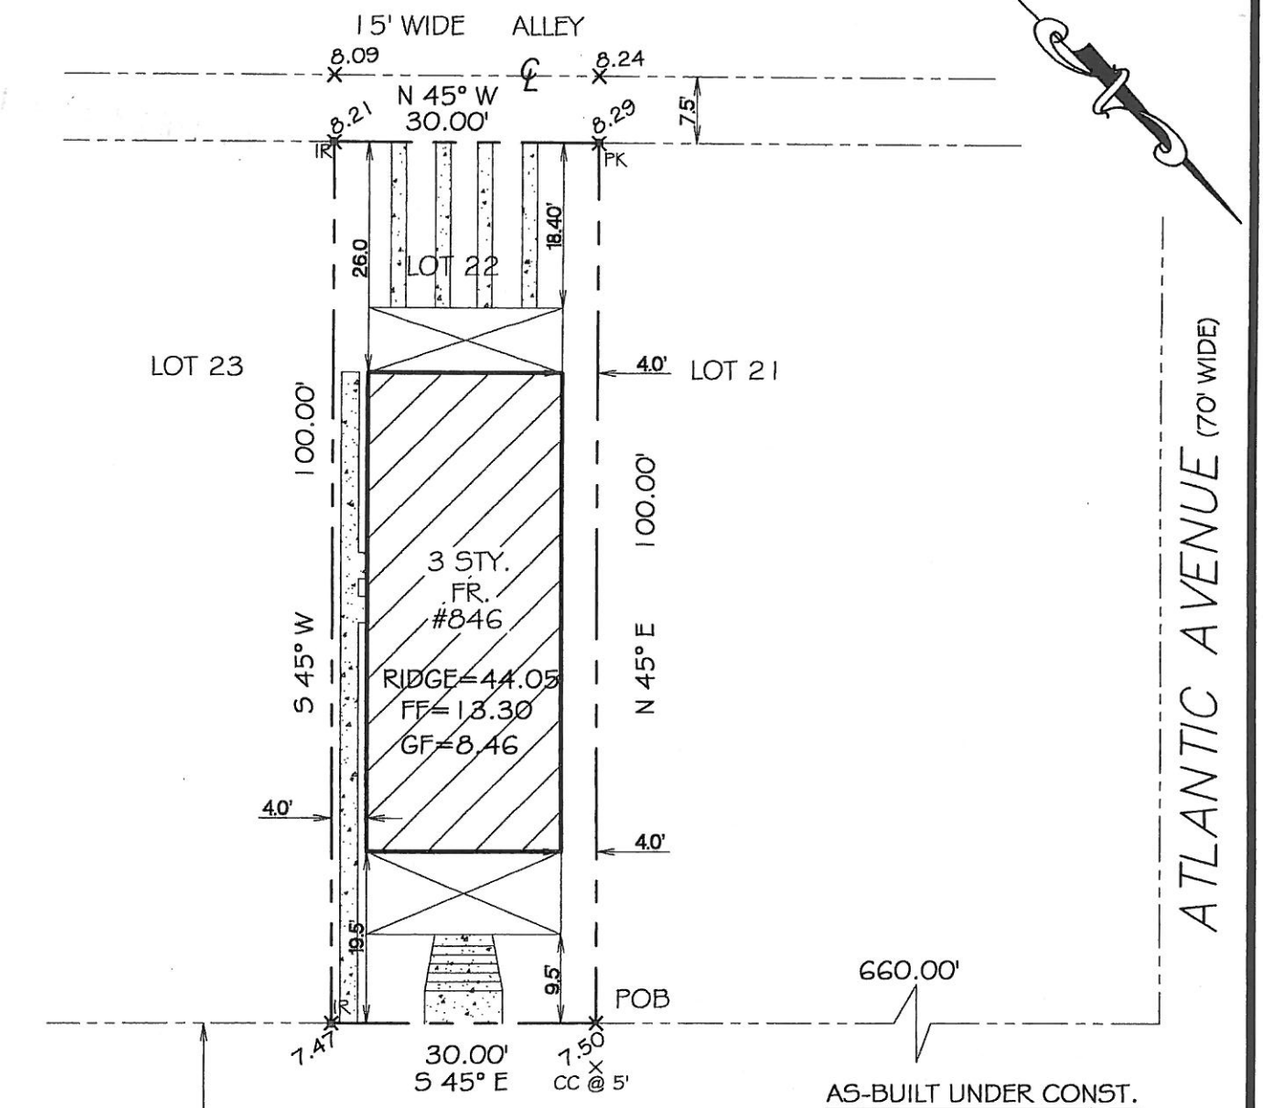

AS-BUILT UNDER CONST.

LOT AREA=3000 SQFT.
LIMIT OF FND.= 37.8% (*)
BLDG. PORCHES/CONC=24.5%
IMPERVIOUS COVERAGE=62.3%
ROOF PEAK ELEV=44.05
ROAD CENTERLINE ELEV.=7.38
(DIFF.=36.67)

* % IS WITHOUT STAIRWELL

- THIS PLAN IS NOT A GUARANTEE OF OWNERSHIP
- BEING LOT 22, BLOCK 102, PLATE 9, TAX MAP OF THE CITY OF OCEAN CITY
- A.K.A. LOT 46, SECTION 3, MAP OF SECTIONS 3 AND 4 OF THE FRONT OCEAN REAL ESTATE COMPANY.
- NO ATTEMPT WAS MADE TO LOCATE THE UTILITIES WHICH MAY EXIST ON THIS PROPERTY. PRIOR TO ANY EXCAVATION, CONTRACTOR SHALL BE RESPONSIBLE TO DETERMINE THEIR EXACT LOCATION.
- SUBJECT TO BUILDING REGULATIONS, RESTRICTIONS, EASEMENTS, RIGHTS-OF-WAY, COVENANTS, RESERVATIONS AND AGREEMENTS OF RECORD, IF ANY.

Design Land Surveying P.A.

MEMBER OF: NJ BLSJ

341 RTE 168 Turnersville, N.J. 08012
Toll Free Phone 1-800-418-9373
Phone (856) 374-1134 - Fax (856) 374-1061

CHECKED T.C.J.

DATE	07-09-03
SCALE	1"=20'
DRN:	JLG

SURVEY NO. 0305045

SURVEY OF PREMISES	SITUATE IN:
846 FIRST STREET	CITY OF OCEAN CITY CAPE MAY COUNTY NEW JERSEY

REV: 12-29-03 (AS-BUILT U.C.)
REV: 03-26-04 (AS-BUILT/FINAL)

TO: ISLAND DEVELOPERS - SHORE TITLE

In consideration of the fee paid for making this plan, I hereby declare that the said plan accurately depicts the tax [illegible] furnished to me. No responsibility is assumed for (a) the location of easements that may be located below the surface of the lands, or (b) on the surface of the lands, and not visible, or matters of title. This declaration is issued solely to the herein named purchaser for any transaction occurring within ninety (90) days of its date. The surveyor shall have no responsibility or liability for any reason unless the fee for the preparation of said plan is paid within thirty (30) days of the date hereof. Surveyor's liability for any reason shall not exceed the sum of ONE HUNDRED DOLLARS (100.00)

THOMAS N. TOLBERT
PROFESSIONAL LAND SURVEYOR
N.J. LIC. GS 38608