
NATIONAL FLOOD INSURANCE PROGRAM

Expires July 31, 2002

BIMPORTANT: Read the instructions on pages 1 - 7.

SECTION A - PROPERTY OWNER INFORMATION	For Insurance Company Use:
BUILDING OWNER'S NAME	Policy Number
BUILDING STREET ADDRESS (Including Apt., Unit, Suite, and/or Bidg. No.) OR P.O. ROUTE AND BOX NO.	Company NAIC Number
#001_003 Pennlyn Place	ZIP CODE
CITY Ocean City New Jersey	08226
PROPERTY DESCRIPTION (Lot and Block Numbers, Tax Parcel Number, Legal Description, etc.)	
Lot 13, Block 200 BUILDING USE (e.g., Residential, Non-residential, Addition, Accessory, etc. Use Comments section if necessary.)	15 (115a)
COO Timely	
LATITUDE/LONGITUDE (OPTIONAL) HORIZONTAL DATUM: SOURCE: L_ GPS (Type): L_ USGS Quad Map	Other
SECTION B - FLOOD INSURANCE RATE MAP (FIRM) INFORMATION	
A COUNTY NUMBER 182 COUNTY NAME	New Jersey
1 Situat Ocean City 345310	B9. BASE FLOOD ELEVATION(S)
B4. MAP AND PANEL B5. SUFFIX B6. FIRM INDEX B7. FIRM PANEL B8. FLOOD DATE EFECTIVE/REVISED DATE ZONE(S) NUMBER A 7	(Zone AO, use cepts of topolog)
B10. Indicate the source of the Base Flood Elevation (BFE) data or base flood depth entered in B9. L LEIS Profile IX LEIRM L Community Determined L Other (Describe):	
B11. Indicate the elevation datum used for the BFE in B9: X NGVD 1929 NAVD 1966 Detail of the B12. Is the building located in a Coastal Barrier Resources System (CBRS) area or Otherwise Protected And B12. Is the building located in a Coastal Barrier Resources System (CBRS) area or Otherwise Protected And B12.	ME (OPA)? LYSE LANG
Designation Date:	
SECTION C - BUILDING ELEVATION INFORMATION (SURVEY REQUIR	ED)
Building Under Construction Prayings* Building Under Construction*	[X]Finished Construction
C1. Building elevations are based on:Construction of the building is complete. *A new Elevation Certificate will be required when construction of the building for which this	certificate is being completed - 845
C2 Building Diagram Number 8 (Select the building diagram most similar to as abdroggaph)	1,45.45
6 and 7. If no diagram accurately represents the building, provided ARIAE ARIAE	1-A30 AR/AH, AR/AO
C3. Flevations - Zones A1-A30, AE, AH, A (with BFE), VE, VI-VSO, V (With BFE)	sed. If the datum is different from
Complete Items C3a-i below according to the building diagram specified in Item C2. State the datum of Camplete used for the BFE. Show like the datum to th	to accomment the commit excite the
Datum NGVD Conversion/Comments	ar on the FIRM? Yes N
Does the elevation reference mark used	
D a) Top of bottom floor (including basement or enclosure) 10.4 ft.(iii)	7/13/04
The of and higher floor	
fl. c) Bottom of lowest horizontal structural member (V zones only)	
O d) Anached garage (lop of side)	
☐ d) Attached garage (top of slab)	1 40 21
C) e) Lowest elevation of machinery and/or equipment	mark & Dranf
servicing the building 7.8 ft.(a)	mark & Diduf

information.
(I e) Lowest elevation of machinery and/of equipment servicing the building (I) Lowest adjacent grade (LAG) (II) Lowest adjacent grade (HAG) (III) Highest adjacent grade (HAG) (III) No. of permanent openings (flood vents) within 1 ft. above adjacent grade (III) Total area of all permanent openings (flood vents) in C3h SECTION D - SURVEYOR, ENGINEER, OR ARCHITECT CERTIFICATE This certification is to be signed and sealed by a land surveyor, engineer, or architect authorized by law 1	TION to certify elevation information, oret the data available.



RTANT: In These Specific and Sp	TOUTE AND BOX NO.	The state of the s
901-905 Fermity Place STATE	ZIP CODE	Company NAIC Number
New :	Jersey 08226	TINUED)
Ocean City SECTION D - SURVEYOR, ENGINEER, OR ARCHIT	ECT CERTIFICATION (OC.	3) building owner.
SECTION D - SURVEYOR, ENGINEER, OR ARCTIVE y both sides of this Elevation Certificate for (1) community official, (2) insu	rance agenucompany, and to	
MENTS		
·	* *	_ Check here if attachments
SECTION E - BUILDING ELEVATION INFORMATION (SURVEY NOT F	EQUIRED) FOR ZONE AD	AND ZONE A (WITHOUT BY E)
The state of the s		
metion for a LOMA or LOMAT, detect the building diagram most similar Building Diagram Number (Select the building diagram most similar see pages 6 and 7. If no diagram accurately represents the building, prompted to the bottom floor (including basement or enclosure) of the building the top of the bottom floor (including basement or enclosure) of the building (check one) the highest adjacent grade. For Building Diagrams 6-8 with openings (see page 7), the next higher floor.	r to the building for which this vide a sketch or photograph.) ing is ft.(m)	lin.(cm) about or below h b) of the building the community's
For Zone AO only: If no flood depth number is available, is the top of the	The local official must certify	this information in Section G.
floodplain management of the state of the property owner or owner's authorized representative who completes Some AD must sign here.	ections A, B, and E for Zone A	A (without a FEMA-issued or
he property owner or owner's authorized representation. omnunity-issued BFE) or Zone AO must sign here.		
OMMUNITY-188060 BT E7 6. EENTATIVE'S NAM		
ROPERTY OWNER'S OR OWNER'S AUTHORIZED REPRESENTATIVE'S NAM	STAT	TE ZIP CODE
ADDRESS	TELF	PHONE
SIGNATURE		
COMMENTS		7-4-abman
		L Check here if attachmen
SECTION G - COMMUNITY INF	ORMATION (OPTIONAL)	ment ordinance can complete
SECTION G - COMMUNITY INF The local official who is authorized by law or ordinance to administer the confections A, B, C (or E), and G of this Elevation Certificate. Complete the as 31. The information in Section C was taken from other documentation engineer, or architect who is authorized by state or local law to delevation data in the Comments area below.) 32. A community official completed Section E for a building located in Zone AO. 33. The following information (Items G4-G9) is provided for community.	that has been signed and em- rify elevation information. (In Zone A (without a FEMA-issu	odicate the source and date of the
33. L_ The following information (Items G4-G9) is provided for comments	G6. DATE CERTIFICA	TE OF COMPLIANCE/OCCUPANCY
TO DATE DERMILISSUED	ISSUED 7/26	107
G4 PERMIT NUMBER G5. DATE PERMIT NUMBER	ii 11- a recomment	
G4 PERMIT NUMBER 03-2717 1 A New Construction I Sub-	stantial Improvement	ft.(m) Datum:

G4 PERMIT NUMBER 03-2717 G5. DATE PERMIT BOSCE 12-2702 G7. This permit has been issued for: L. New Construction L. Sub G8. Elevation of as-built lowest floor (including basement) of the building G9. BFE or (in Zone AO) depth of flooding at the building site is:	stantial Improvement is:	
G4 PERMIT NUMBER 03-2717 G5. DATE PERMIT BOSCE 12-22-03 G7. This permit has been issued for: L. New Construction L. Sub G8. Elevation of as-built lowest floor (including basement) of the building G9. BFE or (in Zone AO) depth of flooding at the building site is: LOCAL OFFICIAL'S NAME	is:	

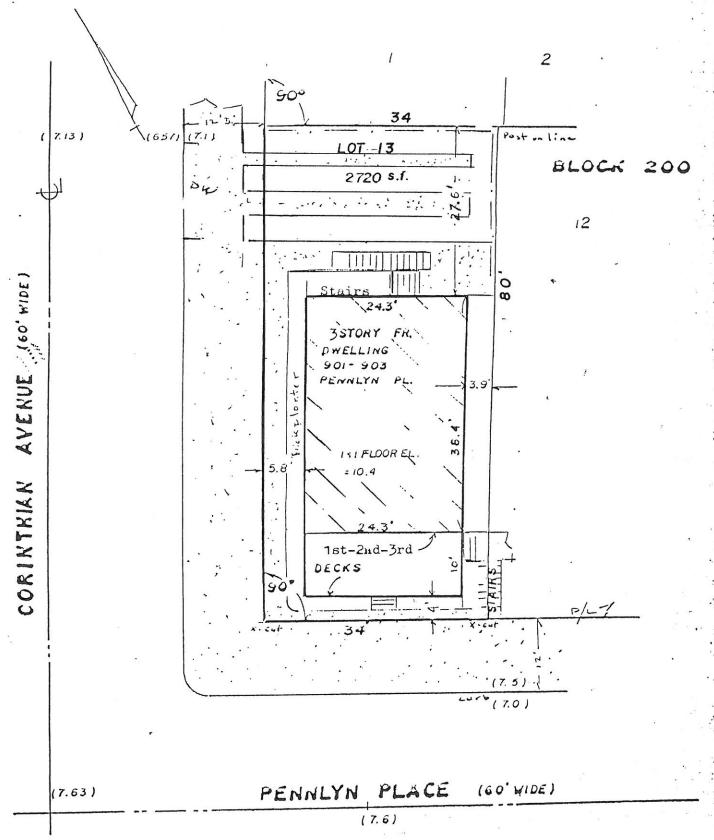

BUILDING DESCRIPTION:
THREE STORY FRAME DWELLING # 901-903 PENNLYN PLACE
THIRD FLOOR ADDITION
THE STORY FRAME ROOF PEAK ELEVATION = 42.6 = 35.0 FEET ABOVE CENTER LINE ELEVATION

LOT COVERAGE = 1228 s.f. = 45% (same as pre-construction) IMPERVIOUS COVERAGE = 1806s.f. = 66%

SURVEY FINAL

PLAN OF SURVEY

LOT 13, BLOCK 200

CITY OF OCEAN CITY, CAPE MAY COUNTY, NEW JERSEY

15 FEET SCALE 1 INCH =

July 13; 2004

DEVAUL SURVEYING

LAND SURVEYORS

OCEAN VIEW, N.J. 08230 20 DEVAULS LANE,

Mari Mark G. DeVaul

34844 N.J. Lic. No.

THIS SURVEY IS INTENDED FOR USE BY THE MUNICIPAL ZONING PLANNING/CONSTRUCTION OFFICE AND NOT TO BE USED FOR CONVEYANCE. NO RESPONSIBILITY OR LIABILITY IS ASSUMED BY SURVEYOR FOR USE OF SURVEY FOR ANY OTHER 12 PURPOSE.