

### FEDERAL EMERGENCY MANAGEMENT AGENCY NATIONAL FLOOD INSURANCE PROGRAM


# **ELEVATION CERTIFICATE**

Important: Read the instructions on pages 1 - 7.
SECTION A - PROPERTY OWNER INFORMATION

O.M.B. No. 3067-0077 Expires July 31, 2002

	SECTION A - PROPERTY	DANIEL HAL OKINY	11014	1 of illadiance co	Impully Cas.
BUILDING OWNER'S NAME				Policy Number	condination p.
BUILDING STREET ADDRESS (Including A	pt., Unit, Suite, and/or Bldg. No.) C	R P.O. ROUTE AND E	BOX NO.	Company NAIC N	lumber :
No. 810 Second Street		STATE	<del></del>	ZIP.COD	VE
Ocean City			New Jersey	ZIP.COC	08226
PROPERTY DESCRIPTION (Lot and Block	Numbers, Tax Parcel Number, Leg	al Description, etc.)	TACAA OCCUPICA	<del>, , , , , , , , , , , , , , , , , , , </del>	The second secon
Lot 5, Block 203					
BUILDING USE (e.g., Residential, Non-residential,	lential, Addition, Accessory, etc. U	se Comments section	if necessary.)		
LATITUDE/LONGITUDE (OPTIONAL)	HORIZONTAL DATUM:	SOURCE:	GPS (Type):		
( ##° - ##' - ##.##" or ##.####°)	NAD 1927   NAD 198		USGS Quad Map	Other:	
( www - mr - www.mr vi				The State of the S	•
SEC	TION B - FLOOD INSURANCE	RATE MAP (FIRM)	INFORMATION		
B1, NFIP COMMUNITY NAME & COMMUN	ITY NUMBER B2. COUNTY			33. STATE	· Toward
City of Ocean City	345310	Cape May	County		Jersey
B4. MAP AND PANEL B5. SUFFIX		FIRM PANEL	B8. FLOOD		DELEVATION(S)
NUMBER		VE/REVISED DATE	ZONE(S)	(Zone AO, use	depth of flooding)
345310 0001 C	7/15/1992 9/5/		A7	] 9.	
B10. Indicate the source of the Base Flo	od Elevation (BFE) data or bas	e flood depth entere	d in B9.	4.5.6	LE ROME CONTRACTOR AS FIRMS
I LEIS Profile IX I FIRM	Community Determined	d Other (Des	scribe):		
B11. Indicate the elevation datum used t	for the BFE in B9: X NGVD 1	929    NAVD 198	8 U Other (De	scribe):	
B12. Is the building located in a Coastal	Barrier Resources System (CB	IRS) area or Otherwi	ise Protected Are	a (OPA)? LIY	∞ □ No ···
Designation Date:					
SECTIO	N C - BUILDING ELEVATION	INFORMATION (SI	JRVEY REQUIR	ED)	
C1. Building elevations are based on:		Building Under			Construction
*A new Elevation Certificate will be					Esc. S
C2. Building Diagram Number	required when construction of t	t similar to the buildi	ng for which this	certificate is being	completed - see
pages 6 and 7. If no diagram accur	rately represents the huilding of	rovide a sketch or p	hotograph.)		141 H At.
22 5 AL A20 AE AL	A With REEL VE V1-V30 V	(with BEE), AR, AR	A. ARVAE, ARVA	-A30, AR/AH, AF	VAO
	ting to the building disgram she	ecitied in Item CZ. 31	ale ine dalum us	CO. I. DIO GOLDINI	a contact to bear
	in a D manuary the deturn to the	THERM TOT THE DEE	JUDAA UDUU IIIGGGG	I OHIO MILE AND	
the datum used for the BFE in Sect calculation. Use the space provide	d or the Comments area of Sec	ction D or Section G,	, as appropriate, t	o document the o	ramu couversiou.
Datum Conversion	/Comments				
Elevation reference mark used	Does the	elevation reference		or on the FIRM?	☐ Yes ☐ No
a) Top of bottom floor (including	basement or enclosure)		15 ft.(m) g		the great
b) Top of next higher floor	PORTO IN T	18			e <sup>2</sup> Ved
C) Bottom of lowest horizontal s	tructural member (V zones only	N/A	fr.(m) 25 = 1		. Joseph Maria
d) Attached garage (top of slab)	0° 10 100 100 100 100 100 100 100 100 10	9.	15 ft.(5A) E Z		" Wally
e) Lowest elevation of machine	ry and/or equipment				Same nath L.
	y and or equipment	9.	35 ft.(m) 1. ft.(m) 1. ft.(m) 2. ft.(m) 2. ft.(m) 3. ft.		Service Transporters
servicing the building		9	1 ft.(m) 2.5		Section of the Control
(LAG)		9	5 ft.(m)	The second	
(HAC)	(0)	diacent grade 1	8 8		in the despeta of the fig.
☐ h) No. of permanent openings (	nood vents) within 1 it. above a		n. (eq. om)	Tall 1	w
(i) Total area of all permanent o	penings (nood vents) in cen			ON	
SEC	TION D - SURVEYOR, ENGINE	EER, OR ARCHITEC	CERTIFICATI	andifu claustian	information
This certification is to be signed and	sealed by a land surveyor, engi-	neer, or architect au	thonzed by law it	nt the data availa	hle Ser Villations
	ne A R and C An Inis cerillicall	a ledigocino ili poo	Choire to mitaile.		Wid.
I certify that the information in Section I understand that any false statement	t may be punishable by fine or i	mprisonment under	70 0.0. 0000, 00		estitut.
CERTIFIER'S NAME		LIC	ENSE NUMBER	34844	
Mark G. Dev		COMPANY NAME			- 3.467-2017
TITLE Land Surveyor	**	DeVaul Survey:	ing STATE	ZIP CO	DE
ADDRESS 20 DeVauls Lane	Ocean '	CITY View	New Jerse	evv	08230
SIGNATURE MALL &	land	DATJuly 12, 20	000 TELEPH	ONE (609) 62	24-0572
"IVAN >					VIOUS EDITIONS
FEMA Form 81-31, AUG 99	SEE REVERSE SIDI	E FOR CONTINUAT	ION REP	LACES ALL PRE	EVIOUS EDITIONS

	copy the corresponding informati	on from Section A.		For Insurance Company Use:
	ding Apt., Unit, Suite, and/or Bidg. No.) (		OX NO.	Policy Number
No. 810 Second Street CITY Ocean City	STATE	New Jersey	, ZIP CODE	Company NAIC Number
	D - SURVEYOR, ENGINEER, OR		08226	TINUED)
	Cert licate for (1) community official,		the second secon	
COMMENTS	sale for (1) community official,	(2) insurance agenio	ompany, and (S	y building owner.
		·		
	* unityperod			and the second second
				Check here if attachment
SECTION E - BUILDING ELEV	VACION INFORMATION (SURVEY	NOT REQUIRED) FO	R ZONE AO A	ND ZONE A (WITHOUT BFE)
formation for a LOMA or LOMR-F, 1. Building Diagram Number see pagen 6 and 7. If no diagra 2. The top of the bottom floor (incle (check one) the highest adjacents. For Building Diagrams 6-8 with fi.(m) lin.
floodplain management ordinar	F - PROPERTY OWNER (OR OW			information in Section G.
	thorned representative who complete		where the party of the last two party and the	
community-issued BFE) or Zone A			210120110114	
ROPERTY OWNER'S OR OWNER'S	A. HORIZED REPRESENTATIVE'S			: : : : : : : : : : : : : : : : : : :
ADDRESS		CITY	STATE	ZIP CODE
SIGNATURE		DATE	TELEPHO	ONE
COMMENTS	***************************************			To Angel
		111111111111111111111111111111111111111	en e	Check here if attachment
	SECTION G - COMMUNITY	INFORMATION (OPT	IONAL)	One of the form data of the form
		a nammunity's floodals	ain managaman	tdi
ections A, B, C (or E), and G of the first of the information in Section engineer, or architect who elevation data in the Company of the first of th	is Elevation Certificate. Complete the Compl	ne applicable item(s) a tion that has been sign o certify elevation infor d in Zone A (without a	and sign below.  The dand emboss  The da	sed by a licensed surveyor, to the source and date of the or community-issued RFE) or











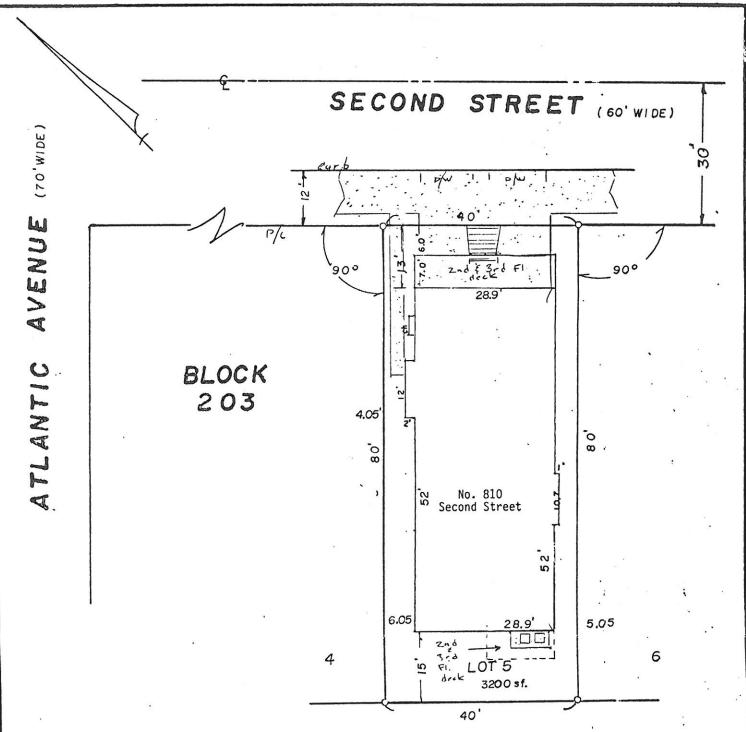

#### NOTE:

According to the Flood Insurance Rate Map, Community #345310, Panel #0001C, dated 9/5/1984, Lot 5 is in Flood Zone A7, Base Flood Elevation

## BUILDING DESCRIPTION:

Four Story Frame Building
First Floor Elevation = 18.17 feet
Garage Floor Elevation = 9.15 feet
Lot Coverage = 1,532 S.F. = 47%
Top of Building Elevation = 48.59 feet = 40.1 feet above center line
Impervious Coverage = 2,017 S.F. = 63%

#### FINAL SURVEY

PLAN OF SURVEY Lot 5, Block 203

CITY OF OCEAN CITY, CAPE MAY COUNTY, NEW JERSEY

Scale 1 inch = 20 feet

May 15, 2000

DEVAUL SURVEYING

OCEAN VIEW,

LAND SURVEYORS

NEW JERSEY

Mark G. DeVaul

N.J. Lic. No. 34844

Rev. 7/9/2000

THIS SURVEY IS INTENDED FOR USE BY THE MUNICIPAL ZONING PLAN-NING/CONSTRUCTION OFFICE AND NOT TO BE USED FOR CONVEYANCE.