

FEDERAL EMERGENCY MANAGEMENT AGENCY NATIONAL FLOOD INSURANCE PROGRAM

O.M.B. No. 3067-0077 Expires December 31, 2005


03125

ELEVATION CERTIFICATE

031		Important: Re	ead the instructions on pag	oe 1 - 7		
	DITY OF DO	SECTION A	- PROPERTY OWNER INFO	DMATION		
BUILDING OWNER'S N	AME	The second second	THOP ENTI OVANER INFO	RIVIATION		For Insurance Company Use:
MARZILLI CONSTI	RUCTION	NOT MEMT				Policy Number
BUILDING STREET ADDRESS (Including Apt., Unit, Suite, and/or Bldg. No.) OR P.O. ROUTE AND BOX NO.						Company NAIC Number
CITY OCEAN CITY			STATE		ZIP COD	
PROPERTY DESCRIPT	ION (Lot and Bloc	k Numbers, Tax Parcel N	NJ lumber, Legal Description, etc		08226	
			ory, etc. Use a Comments and			
				ca, ii riecessaiy.		
LATITUDE/LONGITUDE (##°-##'-##.##" or ##	(OPTIONAL) #.####**)	HORIZON ☐ NAD 1927	ITAL DATUM: ☐ NAD 1983	SOURCE:	GPS (Type): USGS Quad	i Map ☐ Other:
		SECTION B - FLOOD IN	ISURANCE RATE MAP (FIR	RM) INFORMATIO)N	
B1. NFIP COMMUNITY NAME	& COMMUNITY NUM		2. COUNTY NAME			STATE
345310 OCEAN CITY			APE MAY		NEV	V JERSEY
B4. MAP AND PANEL			B7. FIRM PANEL			DO DACE EL CODEL D'ATIONES
NUMBER 345310-1	B5. SUFFIX C	B6. FIRM INDEX DATE 7-15-92	EFFECTIVE/REVISED DATI 9-5-84			B9. BASE FLOOD ELEVATION(S) (Zone AO, use depth of flooding)
B10. Indicate the source of the	Base Flood Eleval			A-	/	9FT
☐ FIS PIOIIIE	XI FIRM	Community Deter	nined Other (I	Jearribe).		
B11. Indicate the elevation da	turn used for the BF	F in R9. NGVD 1020		1000 [000 =	occribo).	r.
B12. Is the building located in	a Coastal Barrier Re	esources System (CBRS) a	rea or Otherwise Protected Area	(OPA)? TYes	SOIDE). ⊠No De	signation Date
	SEC	LION C - BUILDING EL	EVATION INFORMATION (SURVEY REQUI	PED)	algi lation Date
C1. Building elevations are bas	sed on: 🔲 Constru	ction Drawings*	Building Under Construction*	THE RESERVE THE PERSON NAMED IN COLUMN TWO IS NOT THE OWNER.	The second secon	
*A new Elevation Certifica	te will be required w	then construction of the buil	ding is complete	□ Finished Cons □		
C2. Building Diagram Number	6 (Select the building	no diagram most similar to t	he building for which this certifica			
accurately represents the	building, provide a s	ketch or nhotograph)	he building for which this certifica	te is being complete	d - see pages	6 and 7. If no diagram
C3. Elevations - Zones A1-A3	D. AF AH A (with F	SEED VE V1.V30 V (with B	BFE), AR, AR/A, AR/AE, AR/A1-A			
Complete Items C3a-i be	low according to the	e building disgram execition	in Item C2. State the datum use	3U, ARVAH, ARVAO		1200
Section B, convert the date	ım to that used for t	the BFF Show field measur	rements and datum conversion o	a. II the datum is din	rerent from the	datum used for the BFE in
Section D or Section G. as	appropriate to do	cument the datum conversion	on lenis and dawn conversion o	aculation. Use the	space provided	d or the Comments area of
Datum SAME Conversion	n/Comments NONE		л.			
Elevation reference mark	sed PRVT Does th	= ne elevation reference mort	used appear on the FIRM?	v 5 1		
a) Top of bottom floor (including basement	or enclosure)		Yes 🛛 No		
☐ b) Top of next higher flo	or	or enclosure)	<u>5</u> . <u>8</u> ft.(m)		Seal,)
			<u>12</u> . <u>8</u> ft.(m)		S be a	/
c) Bottom of lowest hord) Attached garage (to)	zoniarsi uciurai me vofolob)	ember (v zones only)	<u>NA</u> ft(m)		Date	() ()
e) Lowest elevation of r			<u>5</u> . <u>7</u> fL(m)		Embosse and Date	216
convicing the building	Topograpia in a O	quipment			F. 6.	1197
servicing the building f) Lowest adjacent (finis	y (Describe in a Cor	mments area)	<u>10</u> . <u>1</u> ft.(m)		ag tru	
a) Highest adjacent (iii is	inea) grade (LAG)		<u>5</u> .8ft(m)		Wales Sand	
g) Highest adjacent (fin	snea) grade (HAG)		<u>5</u> . <u>9</u> ft.(m)		si V	X
i) No. of permanent op	enings (flood vents)	within 1 ft. above adjacent	grade <u>16</u>		License Number, E	33536
a iy rotararea orali permi		od vents) in C3.h <u>3,456</u> sq. i				
	SEC	CTION D - SURVEYOR,	ENGINEER, OR ARCHITEC	T CERTIFICATION)Ń	
I his certification is to be sign	ned and sealed b	by a land surveyor, engine	eer, or architect authorized by	law to certify eleva	tion informat	ion.
r ceruity triat the initimation	III Sections A, B,	and C on this certificate	represents my best efforts to i	interpret the data a	vailable.	
CERTIFIER'S NAME	statement may be	e punishable by fine or im	prisonment under 18 U.S. Co	de, Section 1001.		
JAMES E. SCHWAB III				LICENICE AILB	4DED 00 500	
TITLE				LICENSE NUN	IDEN 33,536	
LAND SURVEYOR			COMPANY NAMI	E JAMES E. SCHW	/AB LAND SU	RVEYING
ADDRESS			CITY		STATE	ZIP CODE
8 EAST 10TH STREET			OCEAN CITY		NJ	08226
SIGNATURE	_	$\overline{}$	DATE	. / _	TELEPHONE	
			10/18	1/05	609-398-056	•

IMPORTANT: In these spaces, copy the corresponding info		*****	For Insurance Company Use:
BUILDING STREET ADDRESS (Including Apt., Unit, Suite, and/or Bldg. No.) OR 244 ASBURY AVENUE	P.O. ROUTE AND BOX NO.	1 P.	Policy Number
CITY OCEAN CITY	STATE NJ	ZIP CODE 08226	Company NAIC Number
SECTION D - SURVEYOR, EN	GINEER, OR ARCHITECT CER	TIFICATION (CONTINUI	ED)
Copy both sides of this Elevation Certificate for (1) community official, (2)			
COMMENTS			
C3A IS ELEVATION OF CCRAWLSPACE. C3B IS FIRST FLOOR EL	LEVATION. C3E IS ELEVATION O	GROUND FLOOR UTILIT	Y PLATFORM.
SECTION E - BUILDING ELEVATION INFORMATION	ON (SLIDVEY NOT DECLIDED	FOR ZONE AO AND ZO	Check here if attachmen
or Zone AO and Zone A (without BFE), complete Items E1 through E4. I			
co zone AO and zone A (will out BFE), complete harts E1 till ough E4. I section C must be completed.	II ti le Elevation de tilicate is intende	nor use as supporting into m	Iduoti for a LOIVIA of LOIVIA-F,
1. Building Diagram Number_(Select the building diagram most similar	to the building for which this certifica	te is being completed – see p	pages 6 and 7. If no diagram accurat
represents the building, provide a sketch or photograph.)			
2. The top of the bottom floor (including basement or enclosure) of the bu	uilding is $_{-}$ ft.(m) $_{-}$ in.(cm) \Box at	ove or 🗌 below (check on	e) the highest adjacent grade. (Use
natural grade, if available).	r floor or alguated floor (alguation h)	of the building is \$ (m)	in (and) above the highest adjacent
 For Building Diagrams 6-8 with openings (see page 7), the next higher grade. Complete items C3.h and C3.i on front of form. 	r lloor or elevated floor (elevation b)	or the building is it.(m)	_in.(cm) above the highest adjacent
4. The top of the platform of machinery and/or equipment servicing the b	ouilding is ft.(m) in.(cm)□at	ove or D below (check on	e) the highest adjacent grade. (Use
natural grade, if available).	0 = ()= ()=		-, ·· J ·· · · , ··- · · (·
5. For Zone AO only: If no flood depth number is available, is the top of t	the bottom floor elevated in accordar	nce with the community's floo	dplain management ordinance?
Yes No Unknown. The local official must certify this in	nformation in Section G.		
Yes No Unknown. The local official must certify this in SECTION F - PROPERTY OWN	nformation in Section G. NER (OROWNER'S REPRESE		West of the second seco






















Check here if attachments

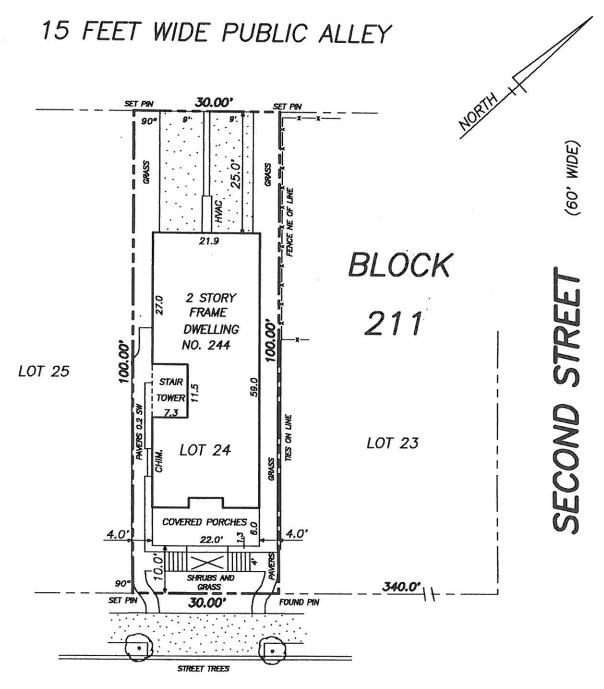

ASBURY AVENUE

(65' WIDE)

COVERAGE AND HEIGHT

LOT AREA- 3,000 SF BUILDING AREA- 1,200 SF, 40% IMPERVIOUS AREA- 2,100 SF, 70% CENTERLINE ELEVATION - 5.40 FT

PEAK ELEVATION 38.8 FT BUILDING HEIGHT- 33.4 FT ISSUED TO:

MARZILLI CONSTRUCTION

FINAL CONSTRUCTION SURVEY

~~~ NOT FOR CONVEYANCE ~~~

LOT 24 BLOCK 211 OCEAN CITY

SCALE

## JAMES E. SCHWAB III

PROFESSIONAL LAND SURVEYOR AND PLANNER 8 EAST 10TH STREET

OCEAN CITY, NEW JERSEY 08226

TELE 609-398-0565

FAX 398-1861

PROFESSIONAL LAND SURVEYOR NEW JERSEY LICENSE NUMBER 33,536

03-125

BK13.PG48 FIELD BOOK